



Wichita-Sedgwick County Metropolitan Area Planning Department

May 19, 2000

Epworth United Methodist Church
c/o Jay Holt, Trustee
856 S. Grove
Wichita, KS 67211

FILE COPY

Re: Administrative Adjustment BZA2000-00011: An administrative adjustment to allow parking in the 25-foot front building setback on property zoned "TF-3" Two-Family Residential.

Legal Descriptions: Lots 78 and 80, on Green Street, Sunny-side 2nd Addition to Wichita, Sedgwick County, Kansas (856 S. Green Street)

Dear Mr. Satterfield:

We have reviewed your request for an administrative adjustment to allow parking in the 25-foot front yard setback on the aforementioned Lots for the purpose of parking. You have stated that you plan to use this area for required off-street parking, in conjunction with improvements made to your church property.

The Unified Zoning Code allows an adjustment to permit parking in residential districts to be located within a required front yard, but in no case closer to the property line than eight feet. Therefore, we find that allowance of parking within the 25-foot front yard setback meets the four conditions required by Section V-1.6 of the Unified Zoning Code as set out below:

- 1) Impact on safety and convenience of vehicular and pedestrian circulation: The proposed encroachments would have no impact on safety and convenience of vehicular and pedestrian circulation in the vicinity of the application area. The allowance of parking within the setback will not generate any additional traffic above what is expected for the church.
- 2) Impact on existing uses in surrounding areas: There should not be a negative impact on the existing uses in the surrounding areas as a result of the reduction of the setbacks. There are single-family homes to the north and west of this site. Parking will be intermittent with the church use and should not encroach or encumber any uses adjacent to this property.
- 3) Compatibility with existing or permitted uses on abutting sites: The allowance of parking

within the setbacks should not compromise the residential homes in the area.


- 4) Effect on public health, safety or welfare: There will be no encroachment into public utility easements or right-of-way, therefore, there should not be a negative impact on the public health, safety or welfare nor will properties or improvements in the vicinity be materially injured.

Our signatures below indicate that an administrative adjustment to allow parking in the 25-foot front building setback, but no closer than 8 feet to the property line, is hereby granted subject to the following condition:

- 1) The parking lots shall be developed in accordance with the submitted site plan.
- 2) The applicant shall be required to plant and maintain street trees and parking lot screening along Green Street. The applicant shall submit a landscape plan to the Planning Director for review and approval.

The zoning adjustment sign may now be removed from the property.



Marvin S. Krout
Director of Planning

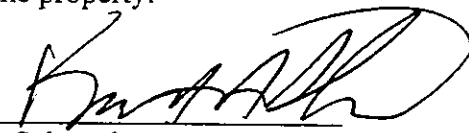
Kurt Schroeder
Superintendent of Central Inspection

MK/KS/lv

cc: Paul Hayes, Office of Central Inspection
Kurt Schroeder, Office of Central Inspection
Donna Goltry, MAPD

B Fence Elevation

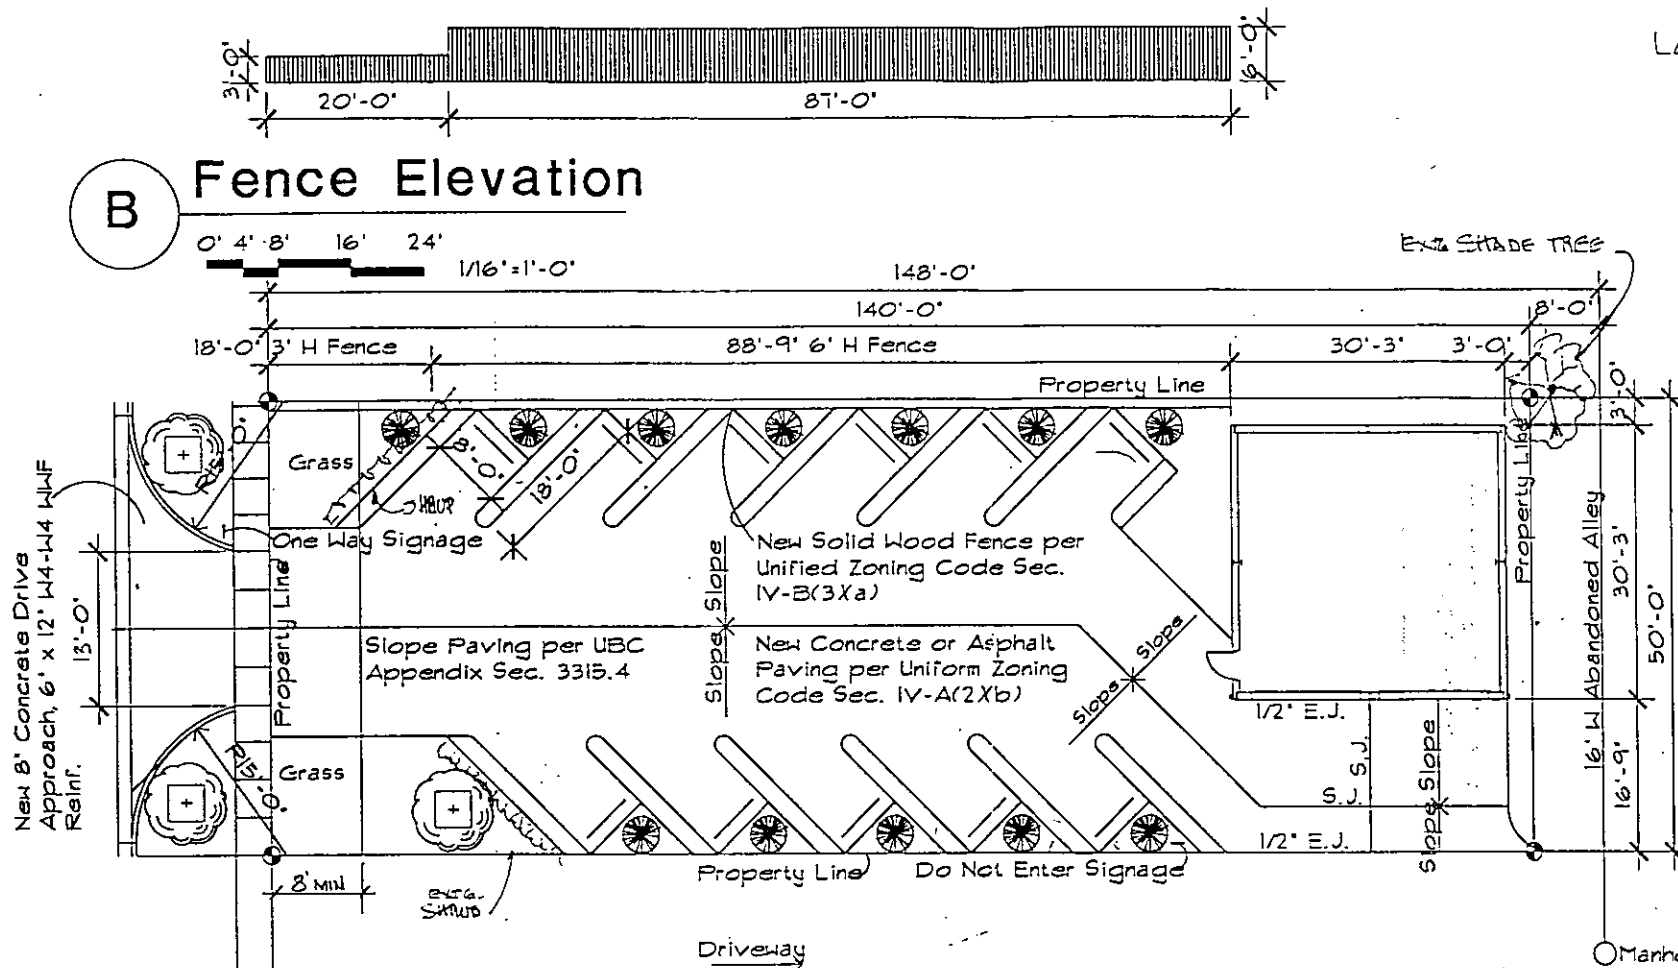

LANDSCAPE READ CALCULATIONS

50' STREET PFT X
8" = 400' LAND SC
STREET AND FRONT
STREET YARD TREES
REQD = 1

PROVIDED 1
PARKING LOT SCREENING
REQD ON GREEN
PARKING LOT TREES
REQD = 0
BUFFER REQD ON N
SE = 5' SHAD TREE

BUFFER PROVIDED =
1 ORNAMENTAL &
1 EXISTING TREE

PLANT LIST

12 EASTERN RED BUDS
(CERAS CANADENSIS)
10 ANTHONY WATER
ER "S. PINE"
(SPARGANGLA)
(ANTHONY WATERER)

Legal Description


Lots 18 and 80, Avenue I, Now Green,
Second Sunny-side Addition, To Wichita,
Sedgwick County, Kansas

Sheet Index

- A1 Site Plan
- A2 Floor Plan and General Notes
- A3 Building Elevations
- A4 Building and Wall Sections
- S1 Foundation Plan and Details
- S2 Structural Notes and Details

A Site Plan

0' 4' 8' 16' 24'
1/16" = 1'-0"

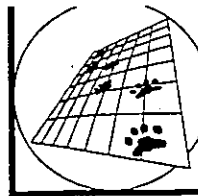

**SHAD
TRAYLOF
DESIGN**

Architect
839 N. West Street
Wichita, Kansas 67212
Tel (316) 729-4636
Fax (316) 729-4636

New Bus Building For
Epworth United
Methodist Church
856 South Green
Wichita, Kansas 67211

Epworth United
Methodist Church
Wichita, Kansas
Wichita, Kansas 672

Site Plan

REVISED
DATE 8/1/16
DRAWN BY S.T.
CHECKED BY S.T.

SF