



Wichita-Sedgwick County Metropolitan Area Planning Department

October 4, 2017

Anthony J. Veith
409 N Huntington Rd.
Andale, KS 67001

Re: BZA2017-00045: County Administrative Adjustment to allow an accessory structure in front of the principal structure on property zoned Rural Residential ("RR").

Legal Description: LOT 4, BLOCK 1, HIEGER EAST 2ND ADDITION, Sedgwick County, Kansas

Dear Applicant:

We have reviewed your request for a Zoning Adjustment to permit an accessory structure in front of the principal structure on less than five acres. From reviewing your application, we understand that you propose to construct a 72-foot by 48-foot detached garage/workshop on the aforementioned property which will be setback from the front property line approximately 110 feet, according to the site plan.

Sec. V-1.2.n of the Unified Zoning Code allows a Zoning Adjustment to permit an accessory structure in front of the principal structure on less than five acres. The proposed construction of an accessory building on the abovementioned property meets the four conditions required by Sec. V-1.6 of the Unified Zoning Code as set out below:

- 1) **Impact on safety and convenience of vehicular and pedestrian circulation**: This request is to allow an accessory structure in front of the principal structure. Public vehicular and pedestrian circulation will not be affected as the structure complies with development standards for Class 1 – paved arterial streets.
- 2) **Impact on existing uses in surrounding areas**: The surrounding property is Rural Residential and is adjacent to a large lot residential development and agricultural land. There should be no impact on the existing uses in surrounding areas as a result of the structure being placed in front of the house.
- 3) **Compatibility with existing or permitted uses on abutting sites**: Placing an accessory structure in front of a principal structure is within allowable adjustments and should not detract from the existing or permitted uses on abutting sites, which are single family residences and farm land.

City Hall • 10th Floor • 455 North Main • Wichita, Kansas 67202-1688

T 316.268.4421 F 316.268.4390

www.wichita.gov

FILE COPY

- 4) Effect on public health, safety or welfare: There will be no encroachment into public utility easements or right-of-way. There will be no negative impact on the public health, safety or welfare, nor will properties or improvements in the vicinity be materially injured.


Our signatures below indicate that a Zoning Adjustment to permit an accessory structure to be placed in front of the principal structure on less than five acres of land for the aforementioned property is hereby GRANTED, subject to the following conditions:

- 1) The site shall be developed in general conformance with the approved site plan, and all permits necessary to construct the improvements shall be acquired and the building constructed within one year.
- 2) The permitting of an accessory structure in front of the principal structure shall apply only to the proposed structure illustrated on the approved site plan. All other structures or additions on the subject property shall conform to the development standards of the Unified Zoning Code unless a separate Zoning Adjustment or Variance is granted.
- 3) If the Zoning Administrator finds that there is a violation of any of the conditions of the Zoning Adjustment, the Zoning Administrator, in addition to enforcing the other remedies set forth in the Unified Zoning Code, may, with the concurrence of the Planning Director, declare that the Zoning Adjustment is null and void.

The "Development Application" sign should now be removed from the property.



Dale Miller, Director
Metropolitan Area Planning Department



Chris Labrum, Director
Metropolitan Area Building and Construction
Department

cc: MABCD
David Dennis, District 3


10/14/2017
REVISION

SITE PLAN

53,02

54,03

100' (AV) - (AV) = 100'

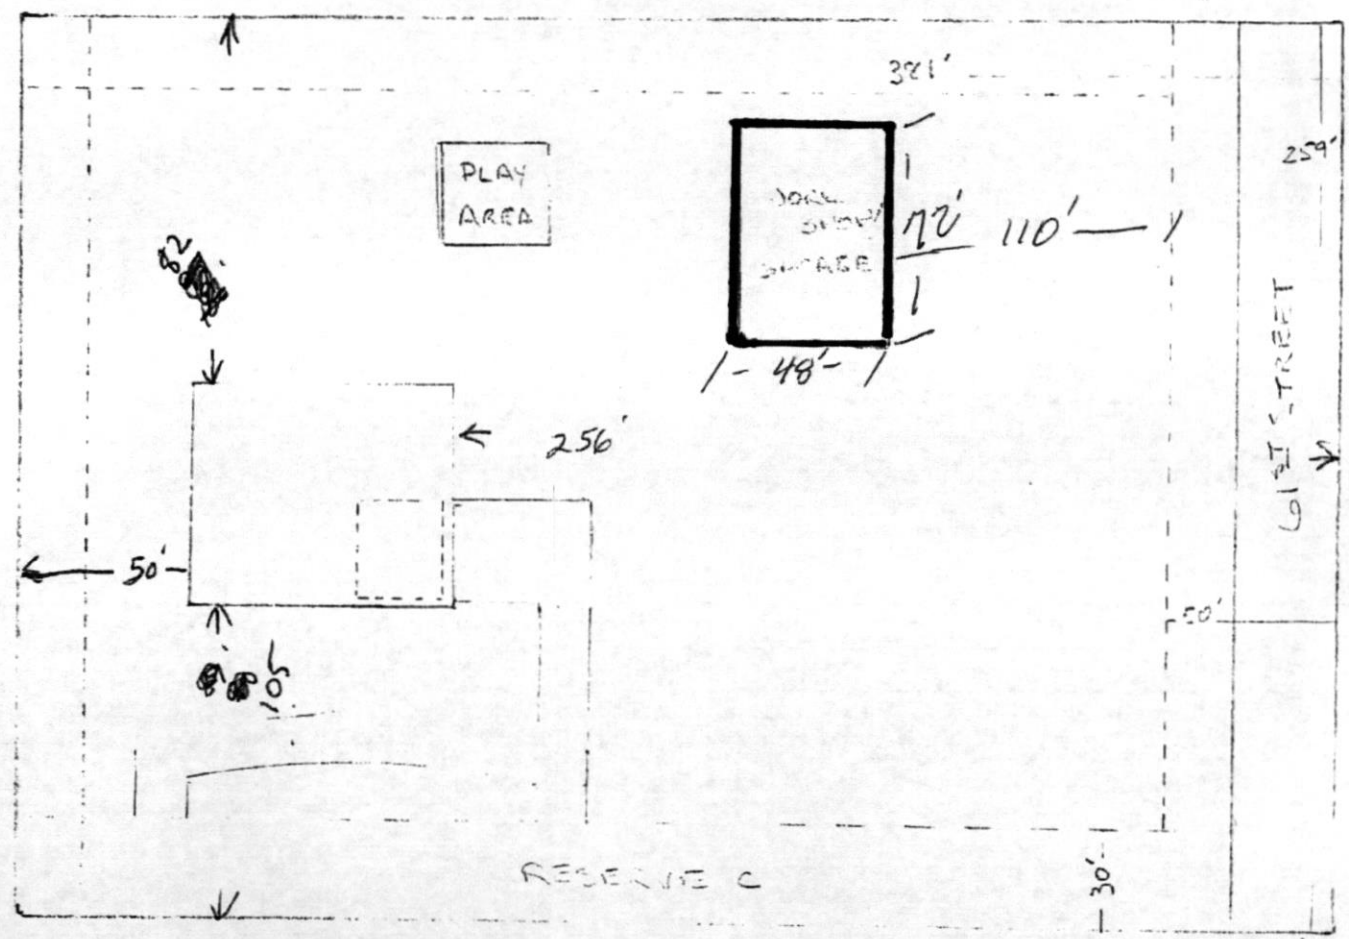

SITE PLAN REV. 1

24210 W. 61ST N