

Save 01-28-2009 11:00:12 AM by BEJ
Plot Scale 1:204.8512 02-03-2009 8:30:19 AM
C:\2007\07148\001\07148-001-Easement and Access Control Vacate.dedicate 1 of 2

Q 167TH STREET WEST = SECTION LINE

599.36'
One Overlap
Complete Access Control
125.00'


GODDARD SCHOOL 2ND ADDITION

AN ADDITION TO WICHITA, SEDGWICK COUNTY, KANSAS

25' Setback

25' Setback

LEGEND	
	ACCESS CONTROL TO BE VACATED
	ACCESS CONTROL TO BE DEDICATED
	PLATTED EASEMENTS TO BE VACATED (Utility Easements & Waterline Easements)
	UTILITY EASEMENTS TO BE DEDICATED
	WATERLINE EASEMENTS TO BE DEDICATED

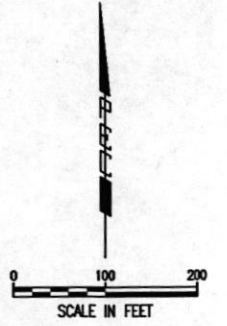

KELLOGG (US HIGHWAY 54)

123.24'

Complete Access Control
1,011.37'

GODDARD SCHOOL 2ND ADDITION


AN ADDITION TO WICHITA, SEDGWICK COUNTY, KANSAS

Save: 01-28-2009 10:29:50 AM by: [REDACTED]
 01-28-2009 10:29:50 AM 02-23-2009 8:32:40 AM

167TH STREET WEST = SECTION LINE

MAPLE STREET = SECTION LINE

LEGEND	
	ACCESS CONTROL TO BE VACATED
	ACCESS CONTROL TO BE DEDICATED
	PLATTED EASEMENTS TO BE VACATED (Utility Easements & Waterline Easements)
	UTILITY EASEMENTS TO BE DEDICATED
	WATERLINE EASEMENTS TO BE DEDICATED

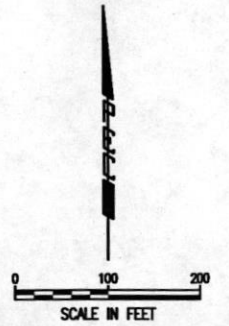

Complete Access Control
100.00'

599.36'

RESERVE B

①

RESERVE A

25' Setback

25' Setback