

SIERRA HILLS

Wichita, Sedgwick


UAC2009-19

State of Kansas)
Sedgwick County) SS

We, Ruggles & Bohm, P.A., Land Surveyors in do hereby certify that, under the supervision surveyed and platted "SIERRA HILLS 2ND A County, Kansas, and that the accompanying exhibit of the property surveyed, described as:

The Southeast Quarter of Section 35, Towns of the Sixth Principal Meridian, Sedgwick Coun at the southeast corner of said Section 35; line 1372 feet; thence with an angle of 100 distance of 302 feet; thence with an angle the right for a distance of 198 feet; thenc 35 minutes to the right for a distance of 46 to the left of 48 degrees 15 minutes for a with an angle to the right of 79 degrees 3 104 feet; thence with an angle to the right a distance 535 feet; thence with an angle 30 minutes to a distance of 322 feet; then of 95 degrees 10 minutes for a distance of thence with an angle of 94 degrees 17 minu for a distance of 856.3 feet to place of l of the SE1/4 of Sec. 35, T27S, R2E of the Kansas described as being the North 1187.86 the West 400.00 feet and EXCEPT the East 60.00 acres more or less, AND EXCEPT Tha 35, T27S, R2E of the 6th P.M., Sedgwick C beginning at the N.E. corner of said SE1/4 the east line of said SE1/4, 1809.20 feet; feet; thence N00°47'54"E, 322.00 feet; then thence S79°52'54"W, 104.00 feet; thence S north line of said SE1/4, 1760.97 feet to thence N00°00'45"E along said west line, 15 of said SE1/4; thence N89°32'19"E along t. 2639.29 feet to the place of beginning; EX and EXCEPT the West 400.00 feet thereof.

All public easements and dedications are here 12-512(b).

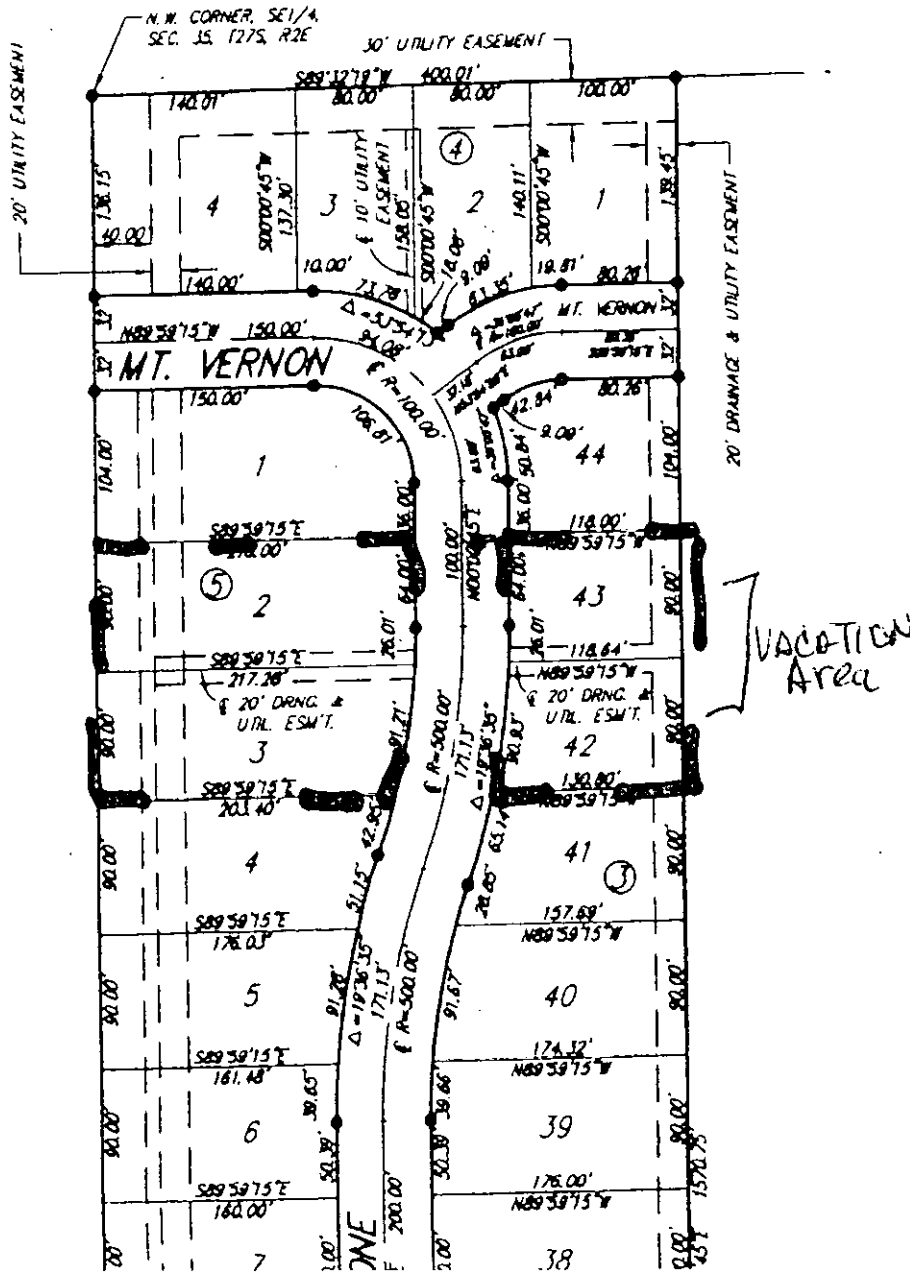

Shore & Bohm, P.A.