




Savoy Company, P.A.  
433 S. Hydraulic  
Wichita, KS. 67211-1911

PH (316) 265-0005  
FAX (316) 265-0275  
WWW.SAVOYCO.COM

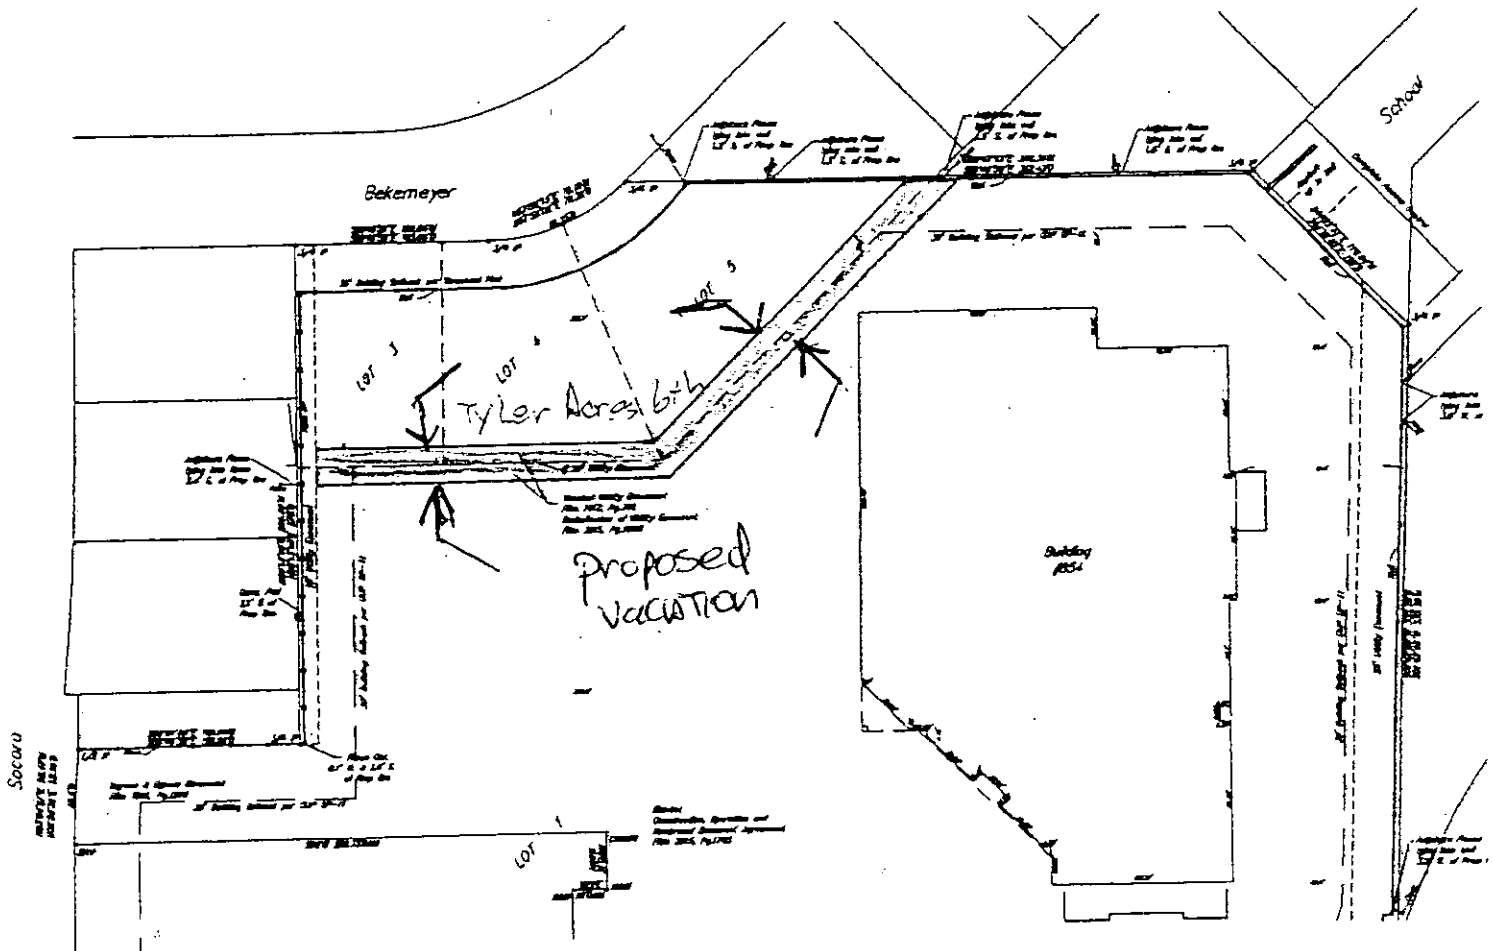

UAC2009-19