


2004-000000 - SECTION 100

2004-000000 - SECTION 100

 

EXISTING UTILITY EASEMENT
(Film 2904, Page 535)

SECTION 10

SECTION 10

PORTION OF UTILITY EASEMENT
TO BE VACATED

2004-000000 - SECTION 100


2004-000000 - SECTION 100

GODDARD SCHOOL 2ND ADDITION
AN ADDITION TO WICHITA, SEDGWICK COUNTY, KANSAS

WILLIAM (S) HENRY (S)

VAC2004-36

3H

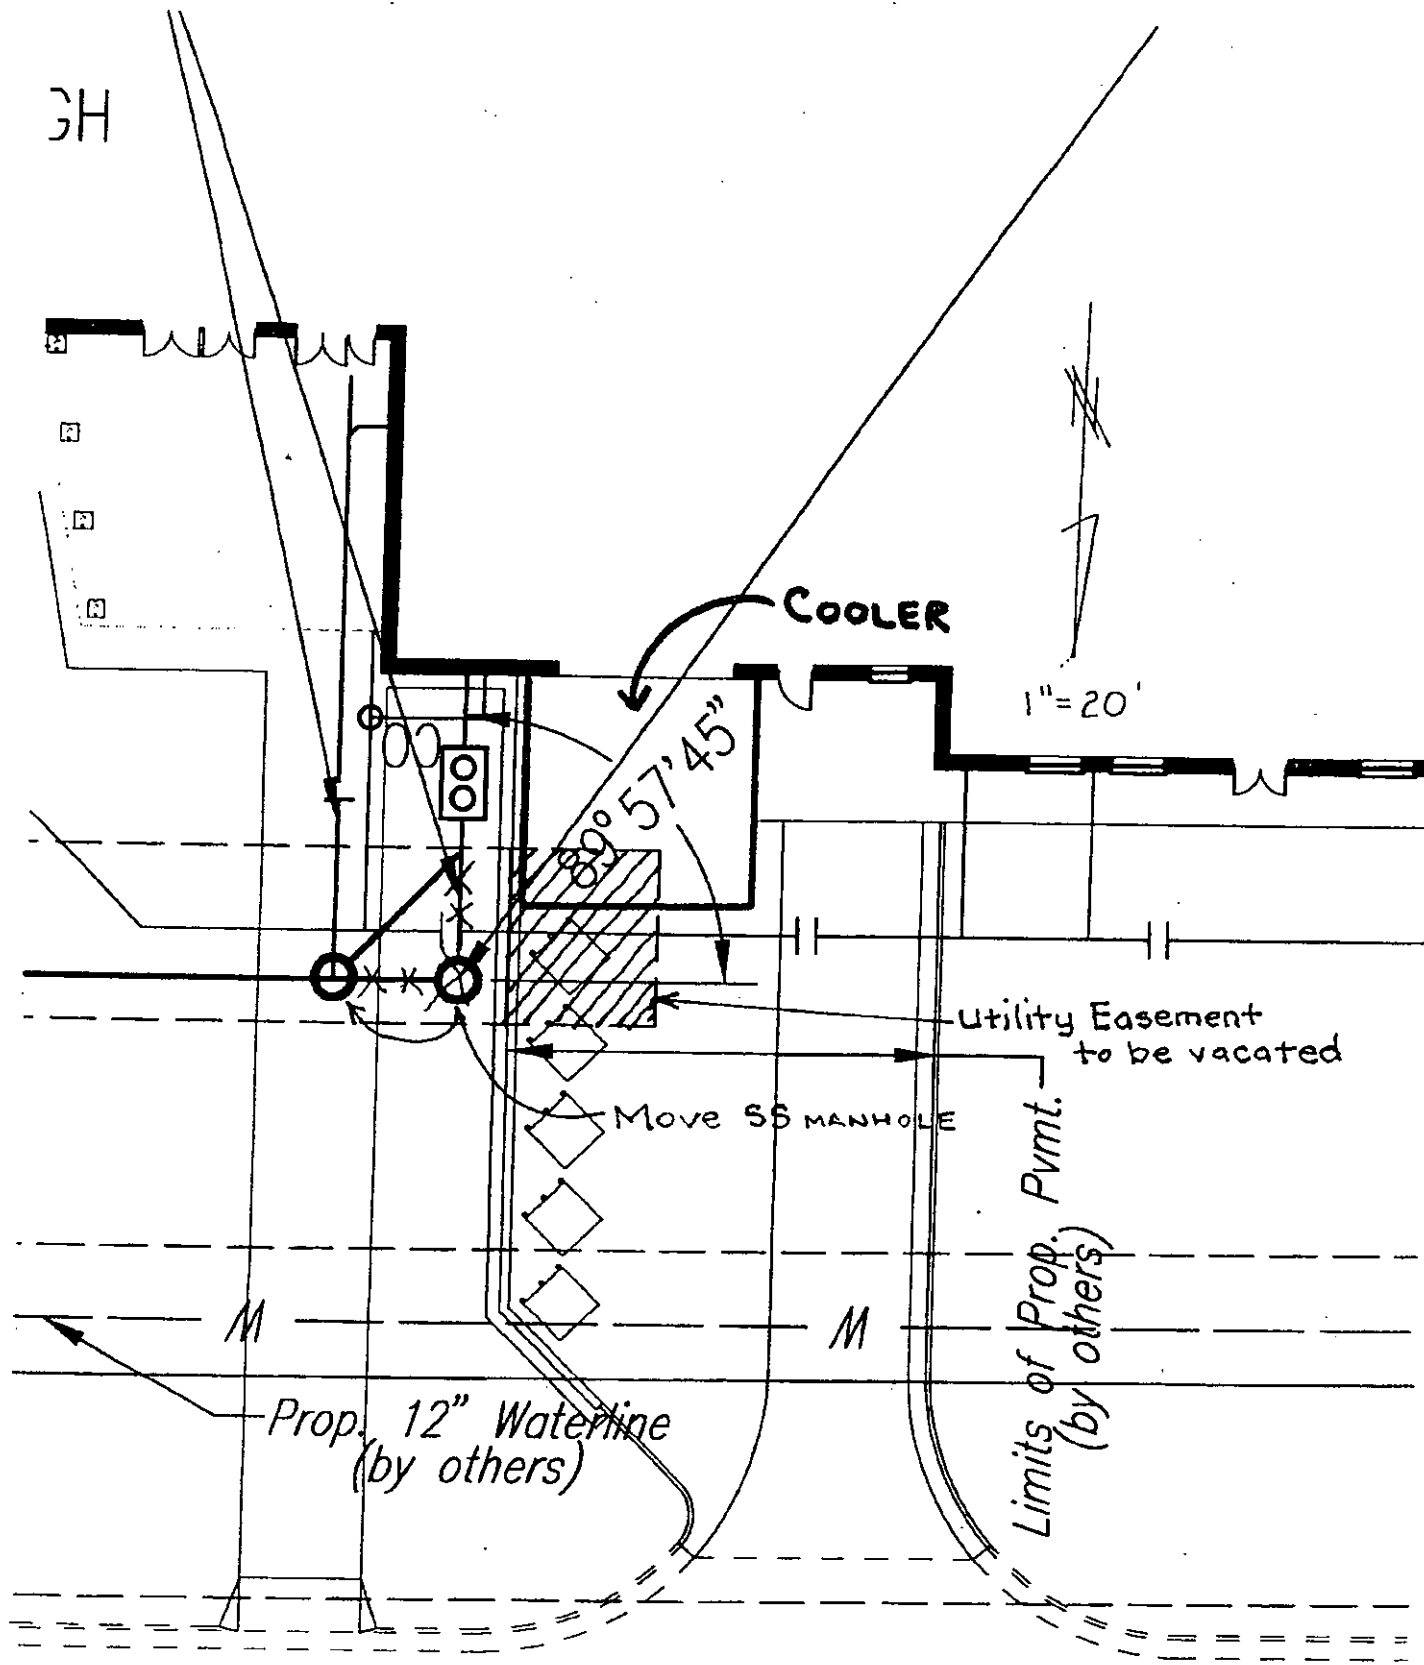

VAC2009-34