

A: House to R-O-W
B: House to Back of Curb



VAC2010-09

Air Capital Land Surveyors


1900 N. AMIDON, SUITE 209
WICHITA, KANSAS 67203

[316] 838-9071

LEGEND	Section	A	B
MEASURED DISTANCE	1	12.1'	51.5'
MEASURED DISTANCE	2	7.5'	49.7'
MEASURED DISTANCE	3	9.0'	47.5'


PLAT OF SURVEY

DEC. 30, 2009

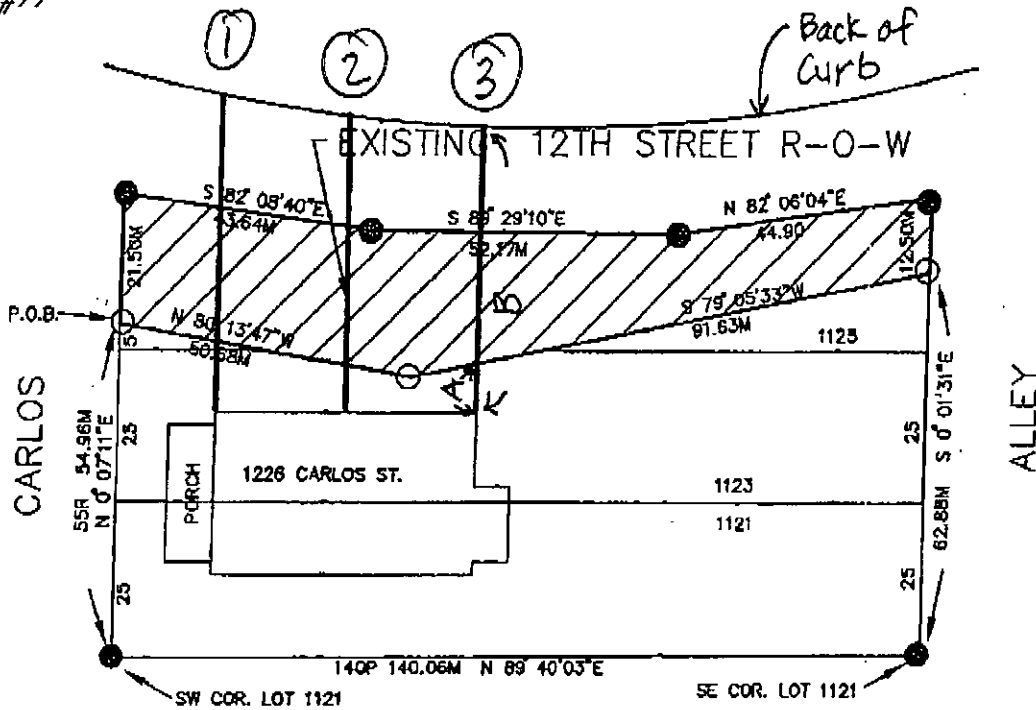

IS)
SS)
GWICK)

Previtera, being a duly licensed land surveyor in said County hereby certify that I caused the land shown in the exhibit to be surveyed and that said survey and the exhibit are true and correct to the best of my knowledge

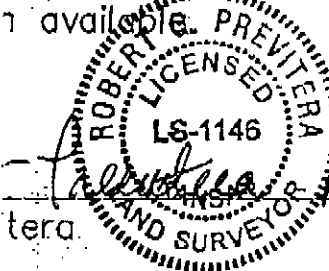

Dec. 30, 2009

NOTE

A = House to R.O.W
 B = House to Back of Curb



VAC2010-09

Air Capital Land Surveyors

1900 N. AMIDON, SUITE 209
 WICHITA, KANSAS 67203

[316] 838-9071

Section	A	B
1	1.0'	29.5'
2	10.7'	36.1'
3	25.2'	41.2'

PLAT OF SURVEY

DEC. 30, 2009

LEGEND

1 DISTANCE


2 DISTANCE

3 DISTANCE

Rebar LS #77

NUMERICAL

BEGINNING

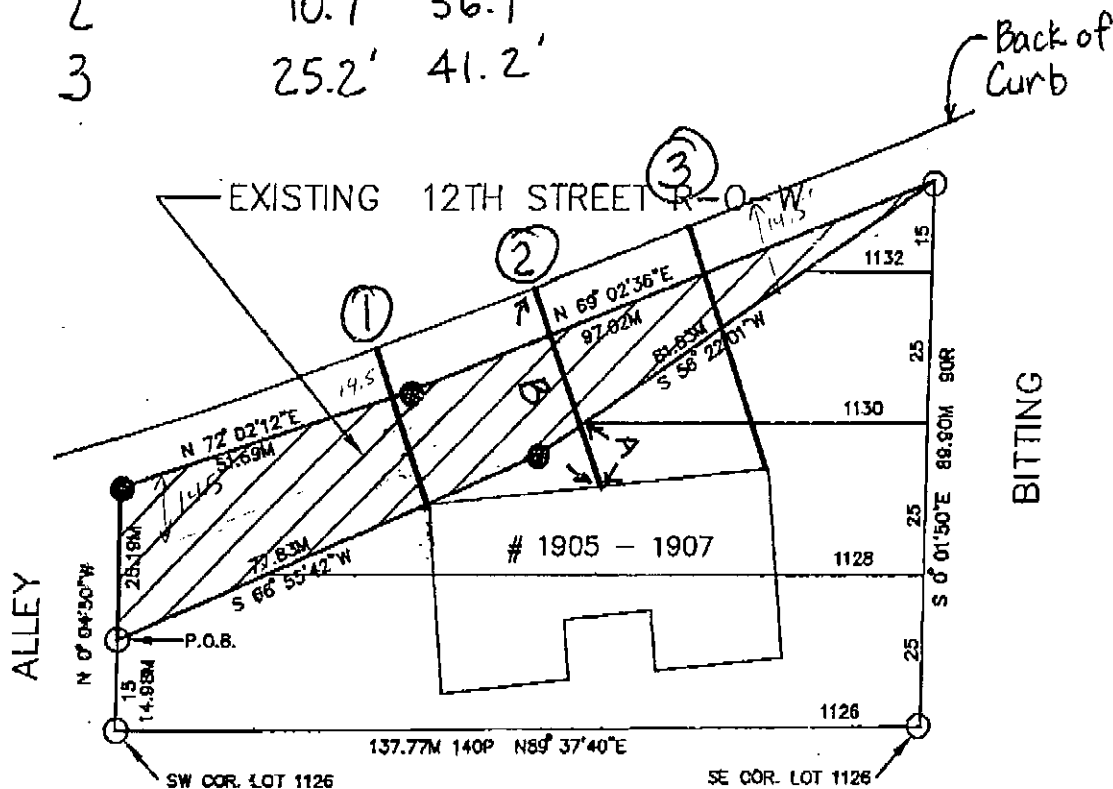

LEGAL


A tr
 north
 desc.
 Bitt.
 City
 the
 as 91
 more

Begin
 point
 1126,
 an a:
 12" 1
 north
 56° 2
 of 1:
 of th
 corne
 begin

BITTING

15)
) SS
 GWICK)

evitera, being a duly licensed land surveyor in said County hereby certify that I caused the land shown in the exhibit to be surveyed and that said survey and the exhibit are true and correct to the best of my knowledge

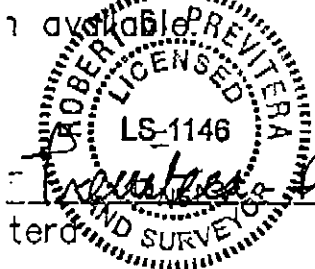

NOTE:

