NW MAIN PUMP STATION

AN ADDITION TO WICHITA, SEDGWICK COUNTY, KAN

OF 135TH STREET

N.V.D.

SCALE : 1" = 50'

● = 3/4" IRON PIPE W/PEC CAP UNLESS OTHERWISE NOTED

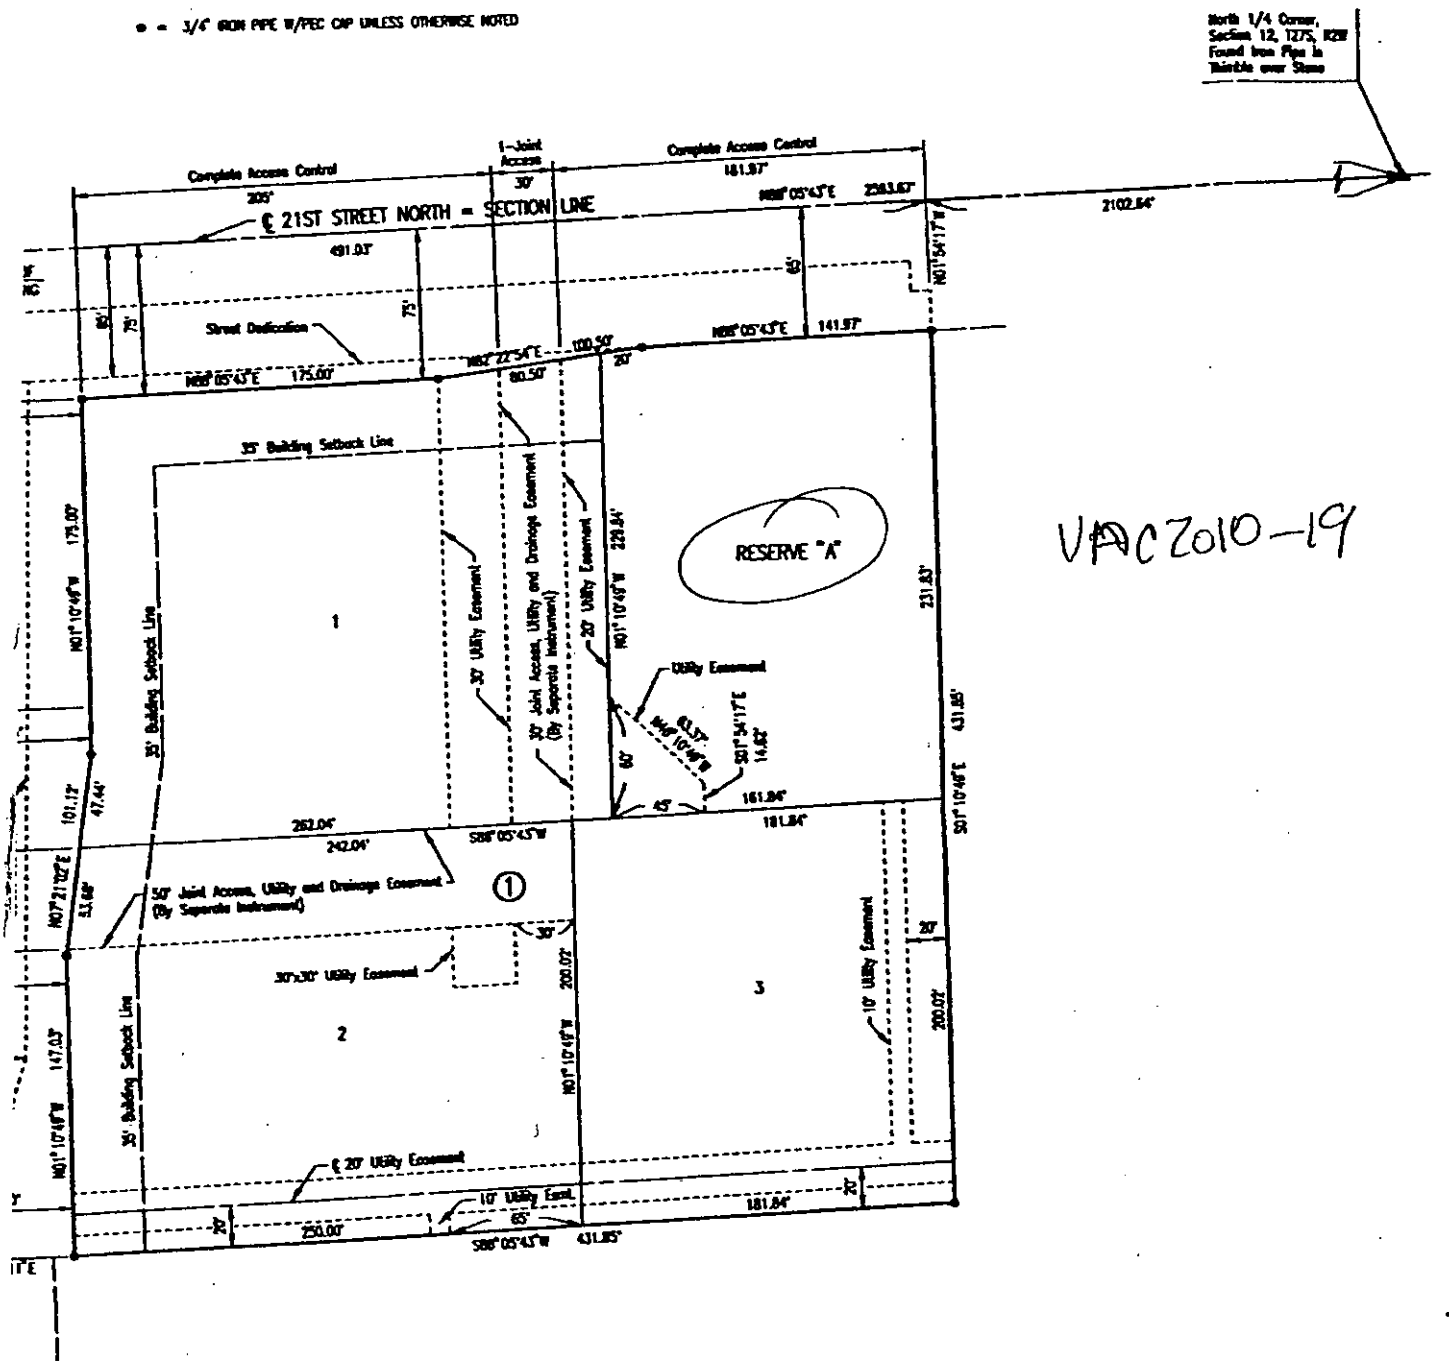

VACZ010-19