VAC2010-37

water & sewer

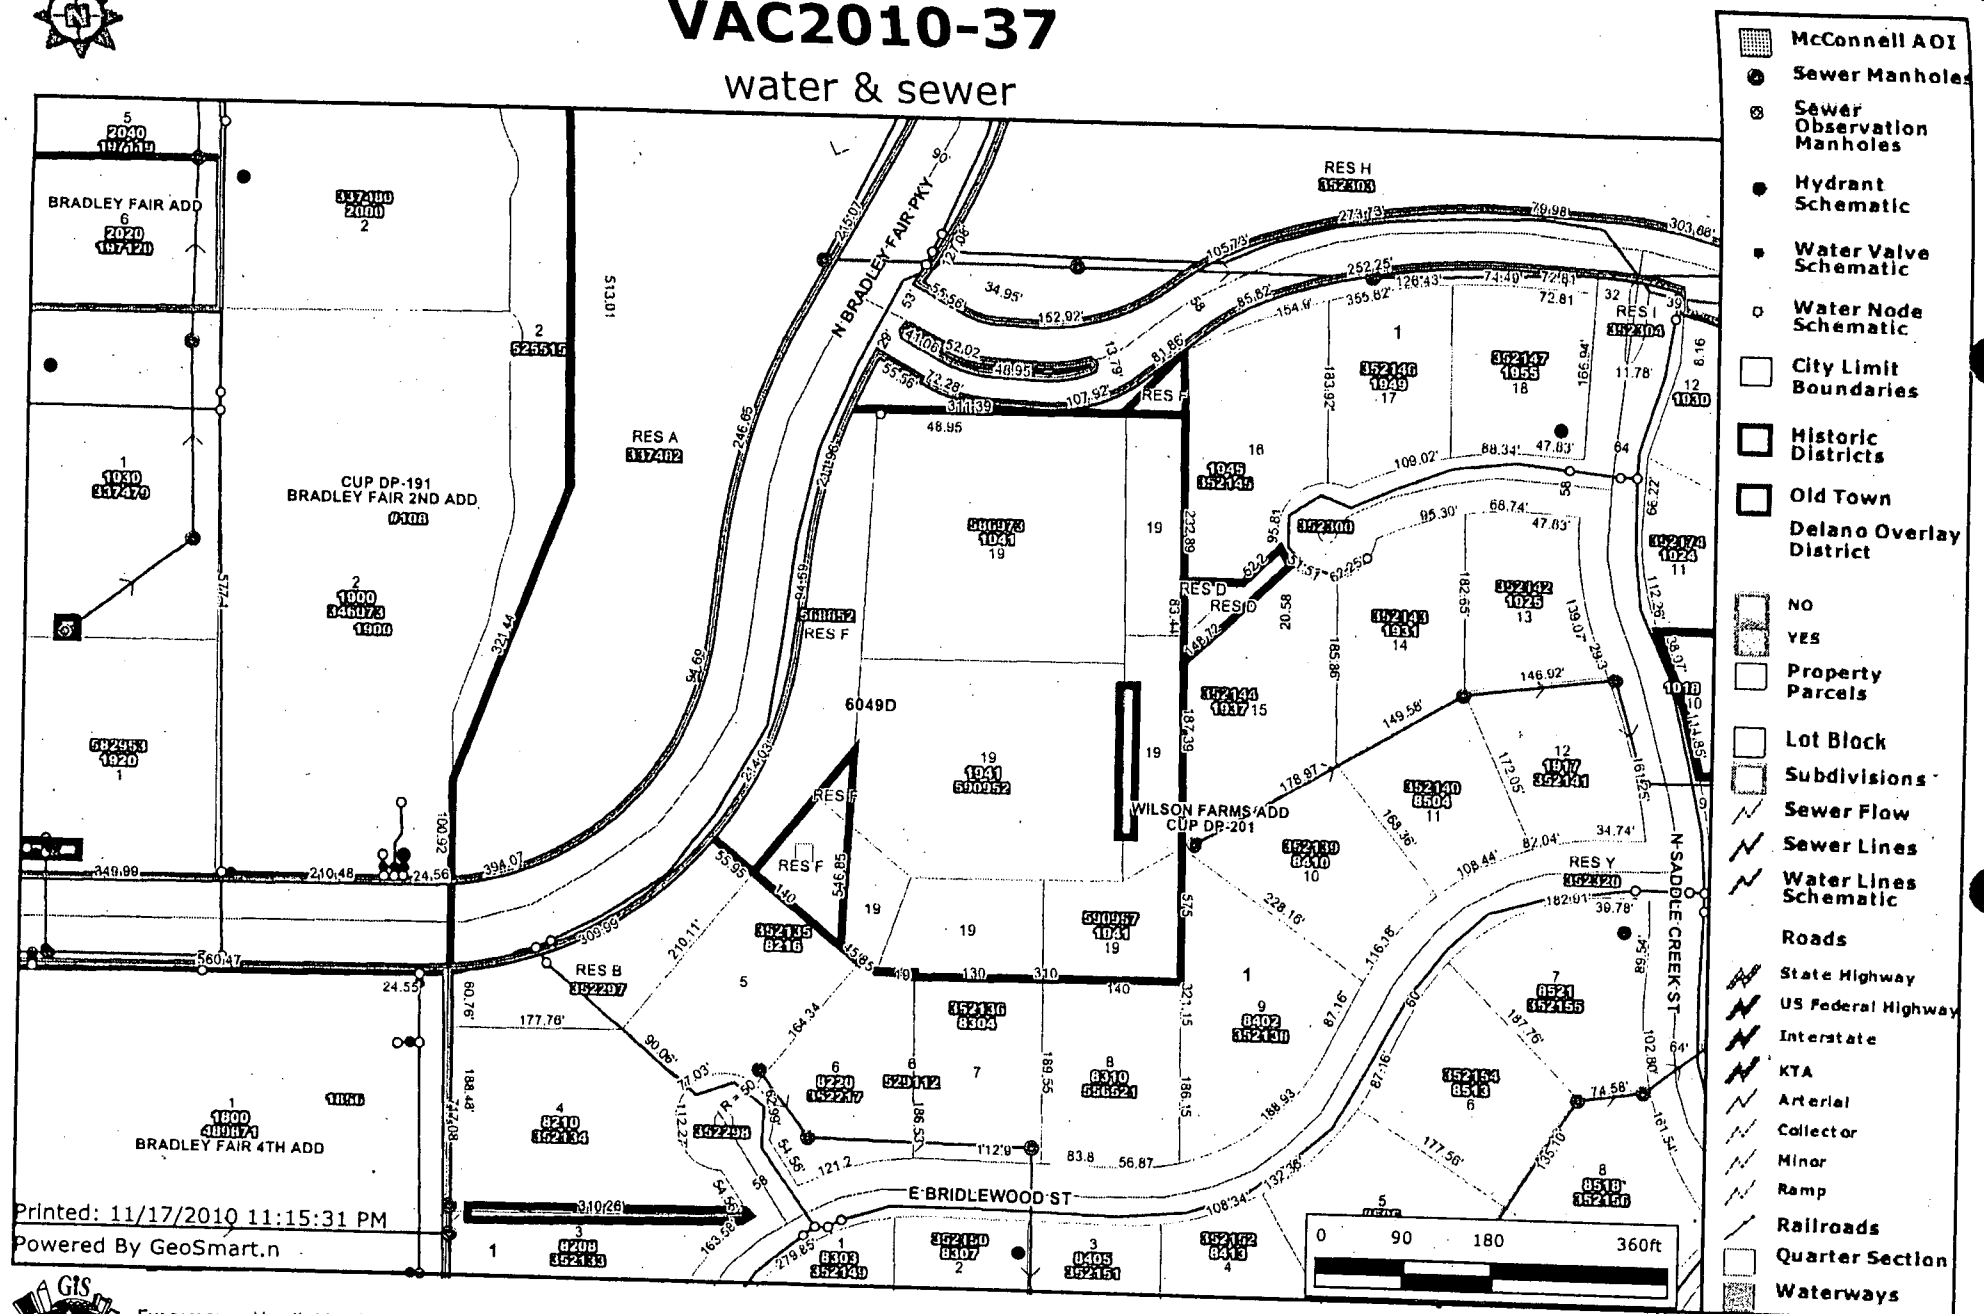

McConnell AOI
Sewer Manholes
Sewer Observation Manholes
Hydrant Schematic
Water Valve Schematic
Water Node Schematic
City Limit Boundaries
Historic Districts
Old Town
Delano Overlay District
NO
YES
Property Parcels
Lot Block
Subdivisions
Sewer Flow
Sewer Lines
Water Lines Schematic
Roads
State Highway
US Federal Highway
Interstate
KTA
Arterial
Collector
Minor
Ramp
Railroads
Quarter Section
Waterways

Every reasonable effort has been made to assure the accuracy of the maps and associated data provided herein. This information is provided with the understanding that the data are susceptible to a degree of error, and conclusions drawn from such information are the responsibility of the reader. The City of Wichita makes no warranty, representation or guaranty as to the content, accuracy, timeliness or completeness of any of the data provided herein. Some data provided here and used for the preparation of these maps has been obtained from public records not created or maintained by the City of Wichita. The City of Wichita shall assume no liability for any decisions made or actions taken or not taken by the reader in reliance upon any information or data furnished hereunder. The user should consult with the appropriate departmental staff member, e.g. Planning, Parks & Recreation, etc. to confirm the accuracy of information appearing in the visual presentations accessible through these web pages.

CITY OF WICHITA

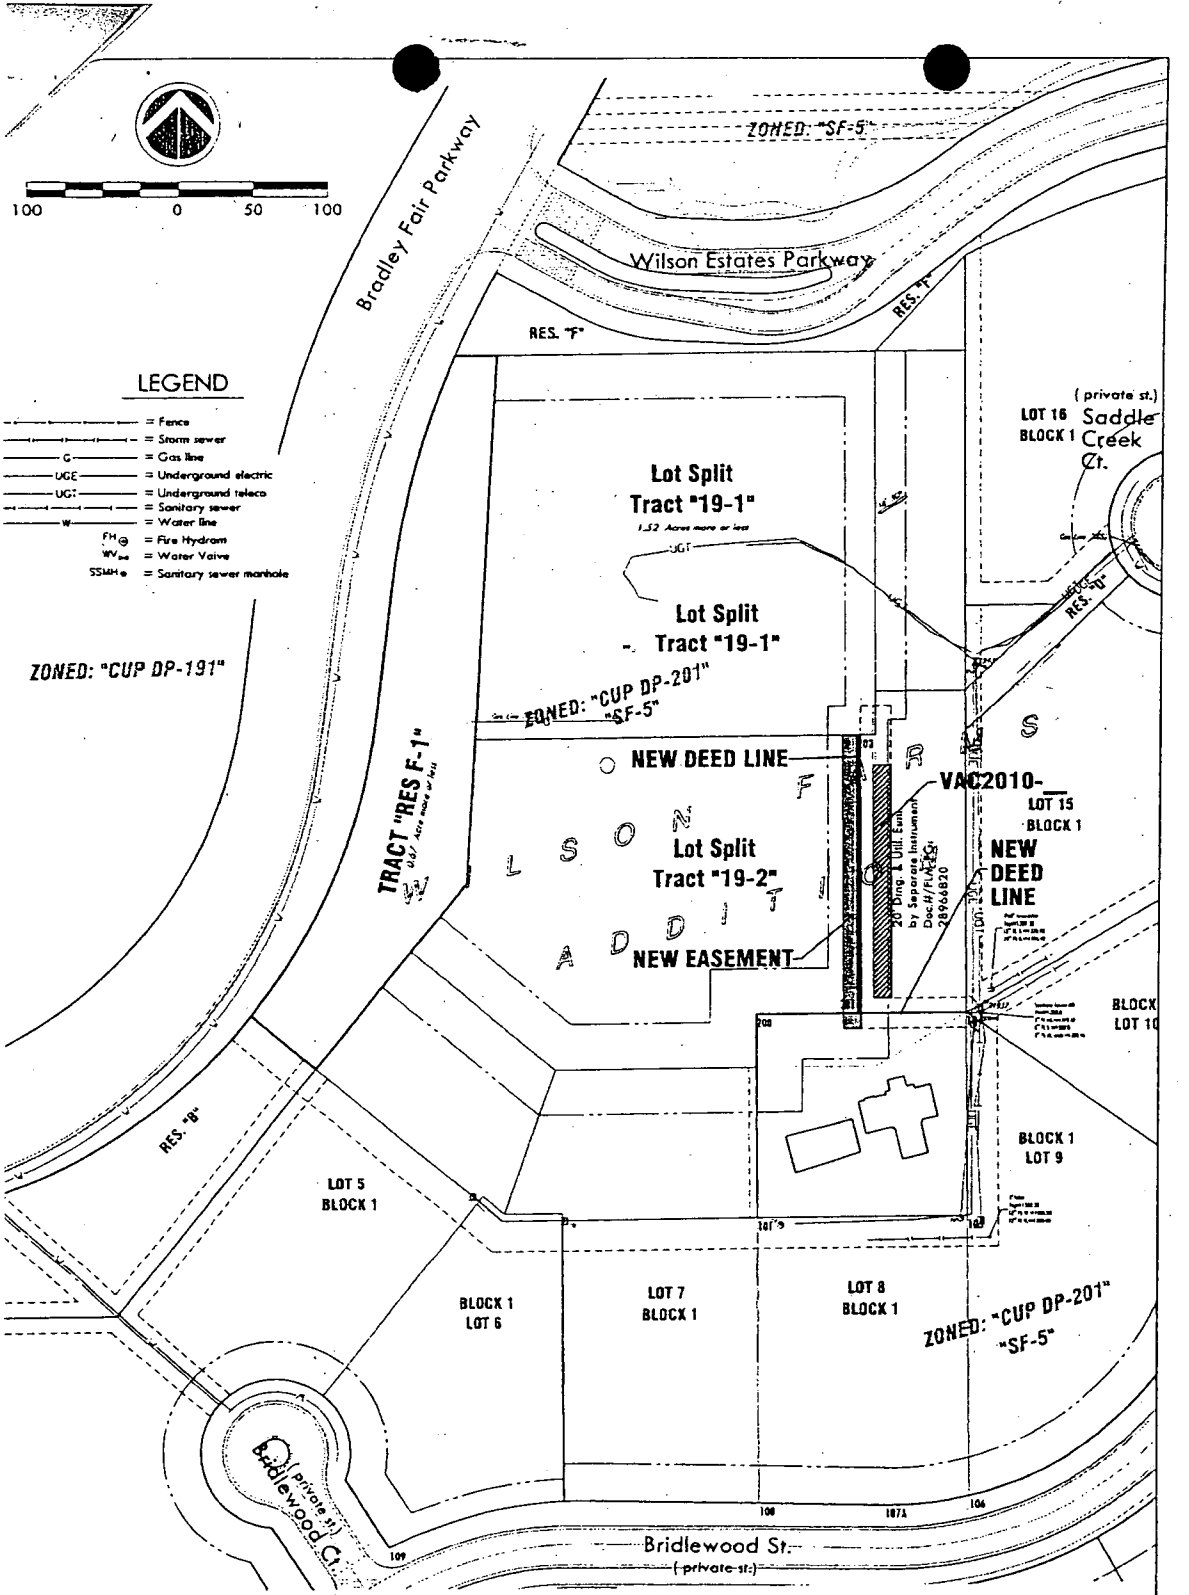

6/6/2008
Lot split SUB2008-30

RECORDED 7-15-1997

WILSON FARMS ADDITION
PROJECT NAME

VACATION CASE EXHIBIT
DRAINAGE & UTILITY EASEMENT
SHEET TITLE

MKEC ENGINEERING CONSULTANTS, INC.

411 N. WEBB ROAD
WICHITA, KS. 67206
316 - 684 - 9600

BDL	BDL	CJA
DESIGN BY:	DRAWN BY:	CHECKED BY:
OCT. 2010	07663	1 / 2

\\DWG\98\07663\07663Vrep\07663vrep.dwg 1/1/2008 11:58:11 AM CDT