


**RUSTY ECK PUD #15**  
(F.K.A. KELLOGG MALL CUP  
Parcels 12, 10, & 7a) ZONED: "PUD"

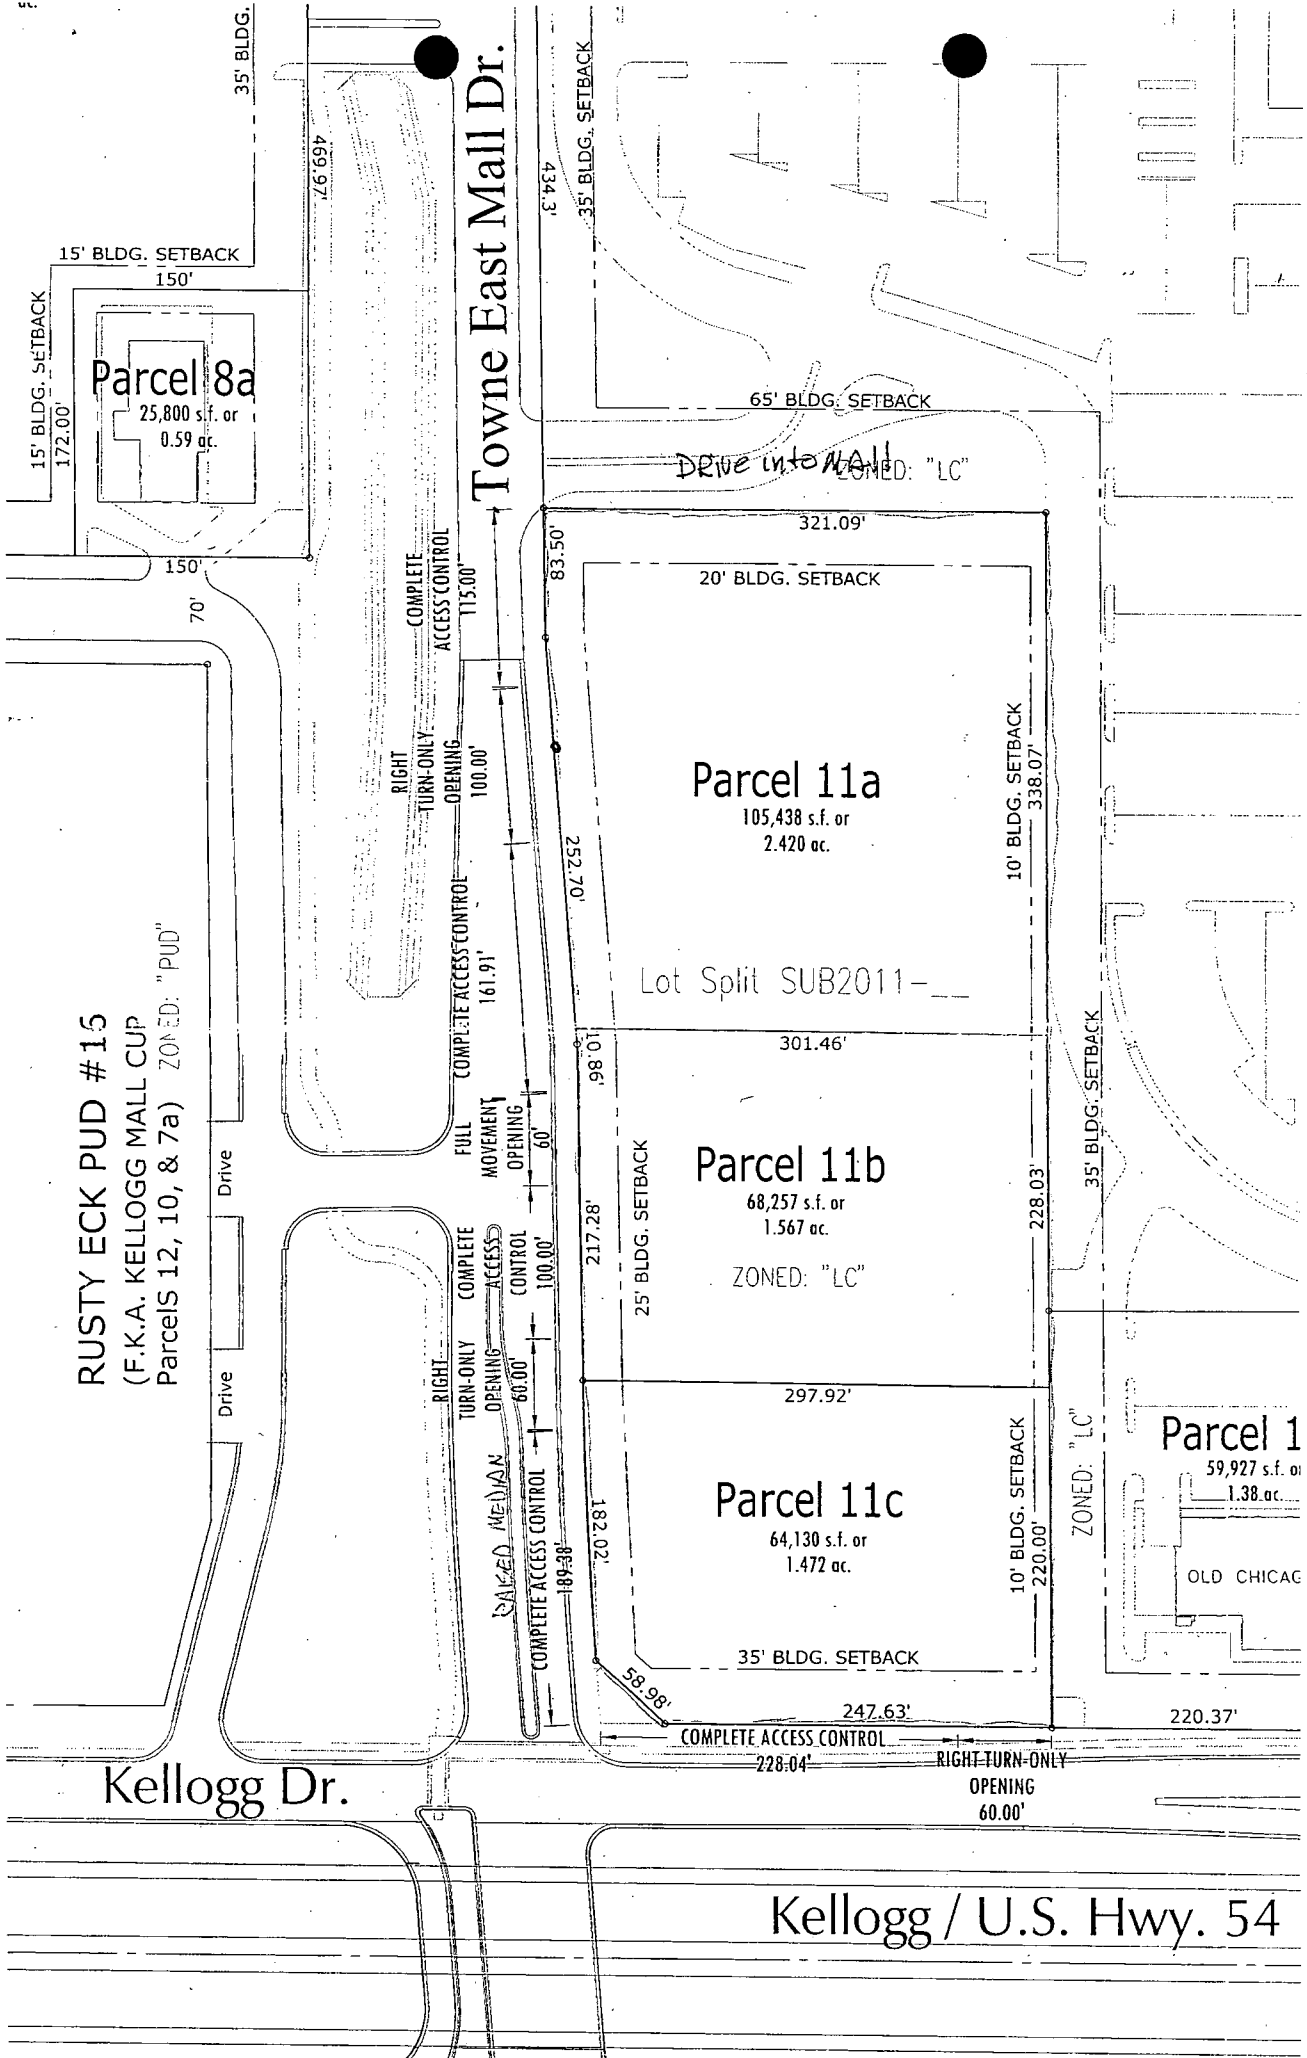

VAC 2011-21