

PERSHING


LEWIS STREET

Ex. Building encroachment into setback varies from 0' to 11.5' for a distance of 37'.

PLATTED SETBACK TO BE VACATED
25' SETBACK IF APPROVED

PROJECT AREA

DELROSE

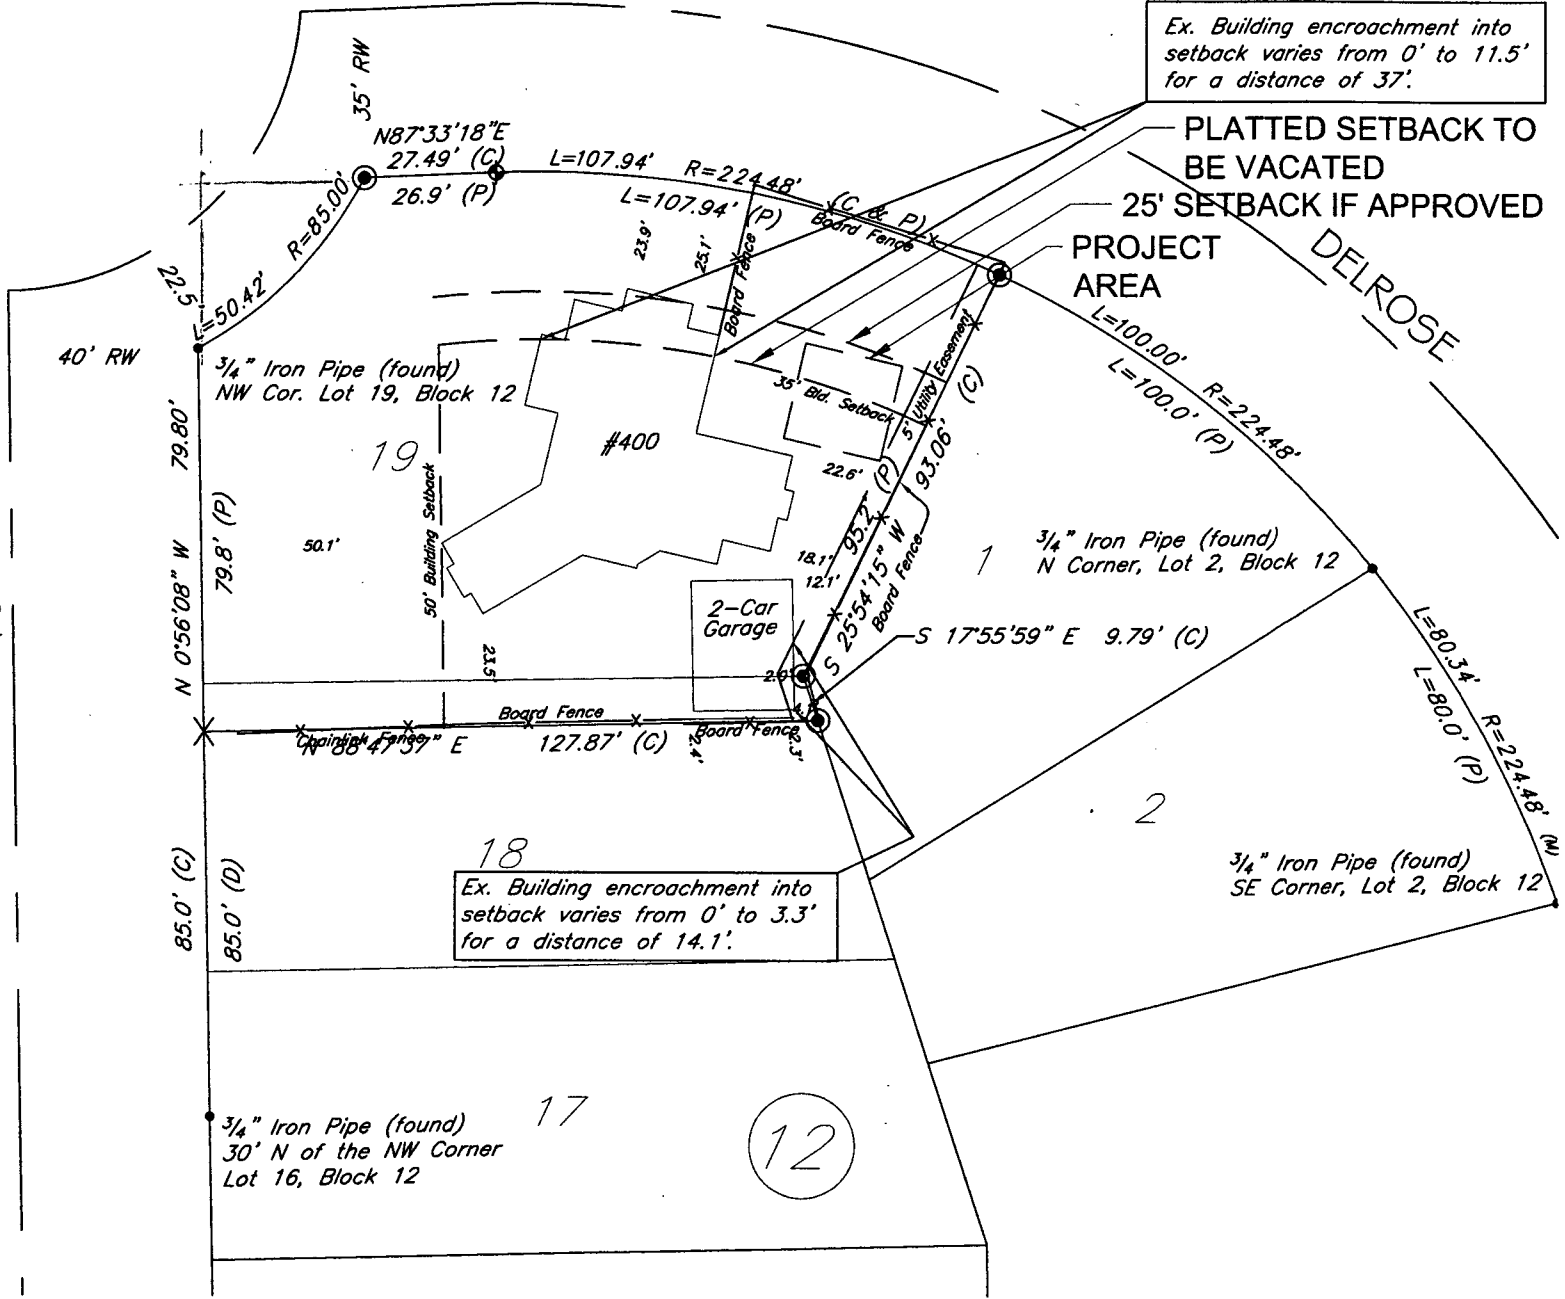

Ex. Building encroachment into setback varies from 0' to 3.3' for a distance of 14.1'.

3/4" Iron Pipe (found) N Corner, Lot 2, Block 12

3/4" Iron Pipe (found) SE Corner, Lot 2, Block 12

