



Wichita-Sedgwick County Metropolitan Area Planning Department

September 12, 2012

M J & Dana Dilks
5420 S. Broadway
Lot 34
Wichita KS 67216


Re: **VAC2012 -00026**- County request to vacate an easement dedicated by separate instrument, generally located west of Hydraulic Avenue, east of I-35, north of 77th Street South on the west side Ida Street.

Dear Sir or Madam:

At its regular meeting on Wednesday, September 5, 2012, the Board of County Commission considered request. The action of the Board of County Commissioners was to APPROVE subject to the recommendation by the MAPC.

If you have any questions about this matter, please call 268-4494.

Sincerely,

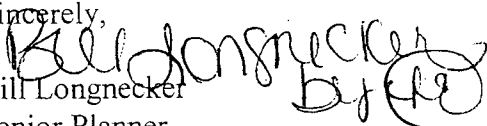
Bill Longnecker
Senior Planner

BL:le

cc: Jim Weber, Sedgwick County Engineer, Public Works Department, 1144 S. Seneca, Wichita, KS 67213
Sedgwick County Electric Coop, Attention: Allen Henning & Wayne Voss, P.O. Box 220, Cheney, KS, 67205-0220
Kelly Dixon, Sedgwick County Code Enforcement, 1144 S. Seneca, Wichita KS 67213
Jeana Morgan, City of Haysville, 200 W. Grand, P.O. Box 404, Haysville KS 67060
Lorena Vital & Luciano Campa, 7647 S. Ida, Haysville KS 67060

VAC2012-26


HANCOCK SECOND ADDITION

TO

HAYSVILLE, SEDGWICK COUNTY, KANSAS

N.W. Cor. N.W. 1/4, S.E. 1/4,
Sec. 4, T29S.-R1E. of the 6th P.M.

N.E. Cor. N.W. 1/4, S.E. 1/4, Sec. 4,
T29S.-R1E. of the 6th P.M.

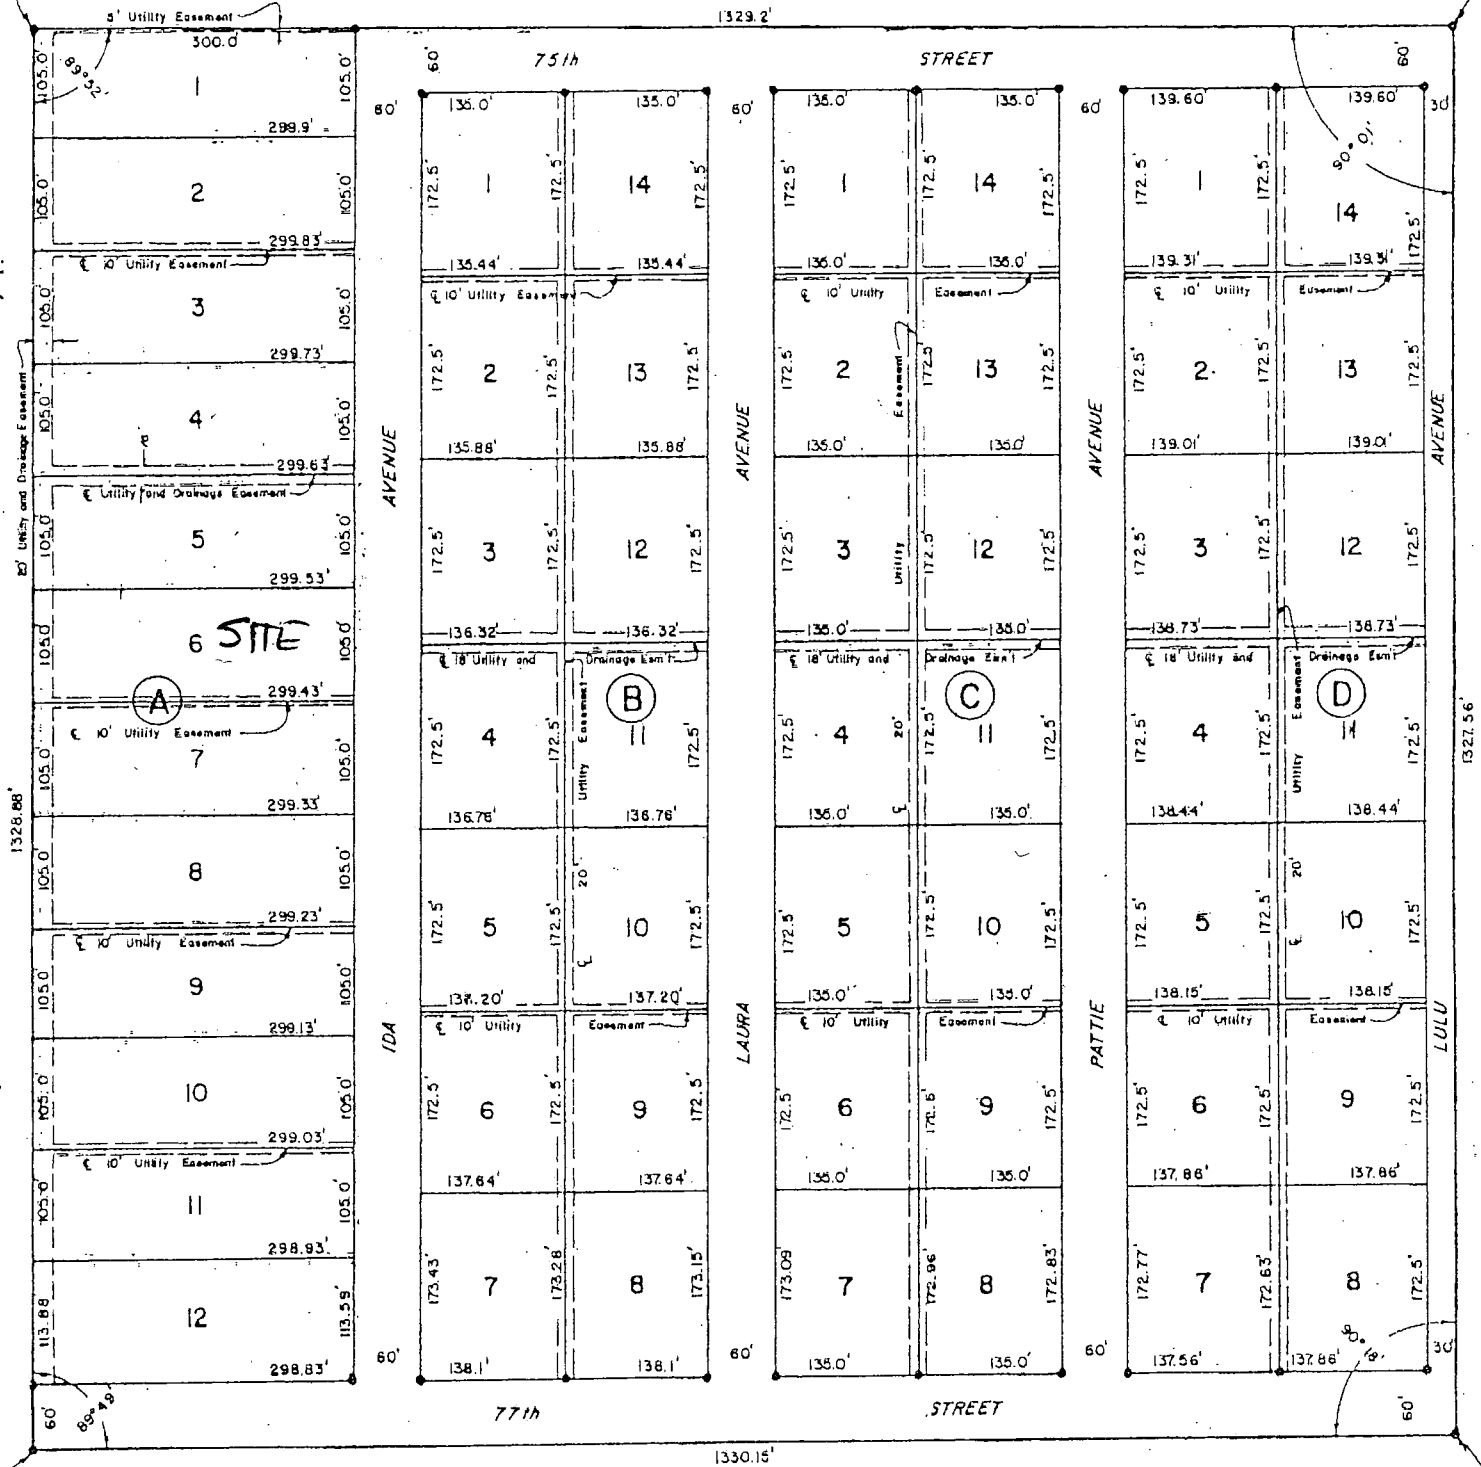

S.W. Cor. N.W. 1/4, S.E. 1/4,
Sec. 4, T29S.-R1E. of the 6th P.M.

S.E. Cor. N.W. 1/4, S.E. 1/4,
Sec. 4, T29S.-R1E. of the 6th P.M.

State of Kansas }
County of Sedgwick } SS

I, Don C. Moehring, a Civil Engineer in said State and County, do hereby certify that I have surveyed and platted Hancock Second Addition in Hayville, Sedgwick County, Kansas into Blocks, Lots, and Avenues, the

Know all men by these presents that we the undersigned property owners of the land as set forth in the Civil Engineers Certificate have caused the same to be surveyed and platted into Blocks, Lots, and Avenues, the same to be