

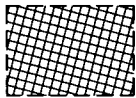


# EXHIBIT


## PART OF GREAT PLAINS BUSINESS PARK 4TH ADDITION

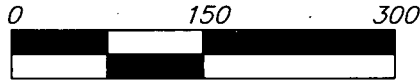

INDICATES AREA OF LEGAL DESCRIPTION  
FOR DRAINAGE EASEMENT VACATION

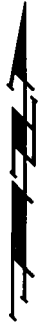

INDICATES AREA OF LEGAL DESCRIPTION  
FOR DRAINAGE EASEMENT GRANT

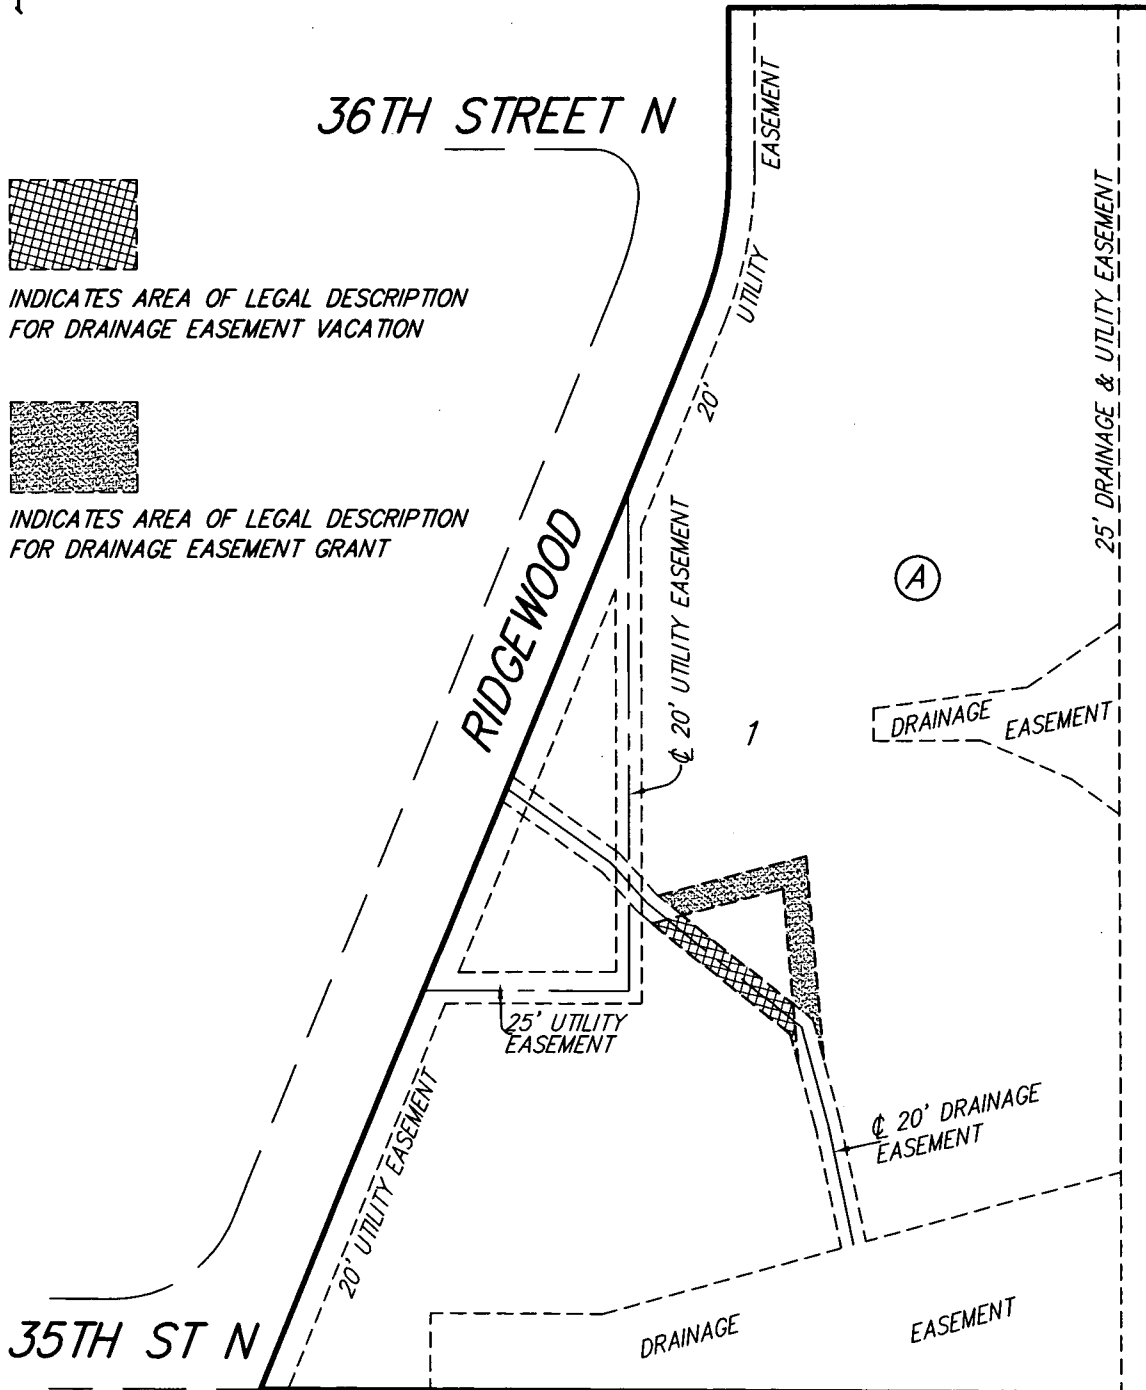

K-96 EXPRESSWAY  
(COND. CASE 88C-3017)

7 NOV 2012

**B** Baughman Company, P.A.  
315 Ellis St. Wichita, KS 67211 P 316-262-7271 F 316-262-0149  
Baughman ENGINEERING | SURVEYING | PLANNING | LANDSCAPE ARCHITECTURE