UAC2014-01

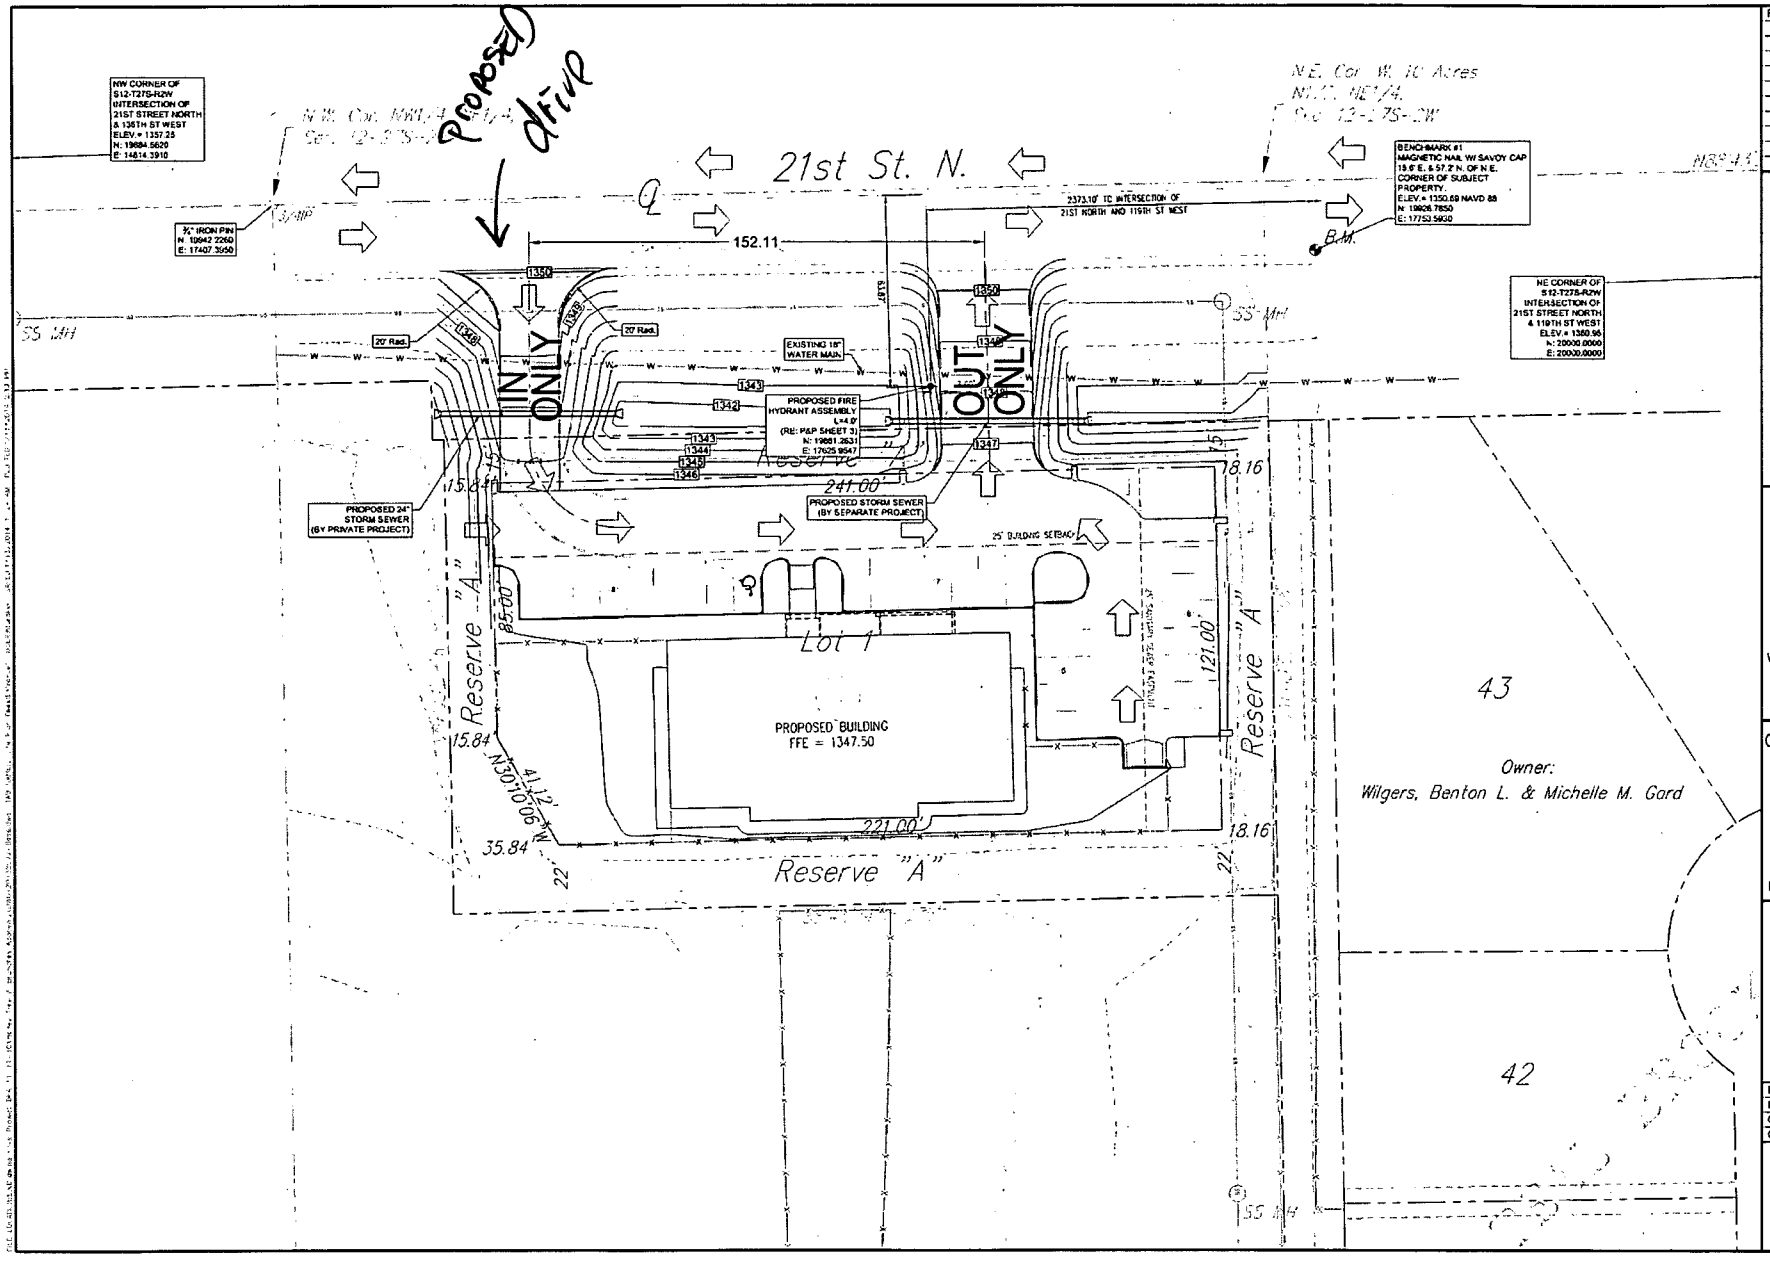

REV.	DESCRIPTION	DATE

GRAPHIC SCALE
20' 0 20'
(IN FEET)
1" = 20'

HONEY TREE & BRANCHES ACADEMY

12807 WEST 21ST STREET NORTH
GREIFFENSTEIN SQUARE
AN ADDITION TO
WICHITA, SEDGWICK COUNTY, KANSAS

CERTIFIED ENGINEERING DESIGN, P.A.
CIVIL ENGINEERING

1935 WEST MAPLE
WICHITA, KANSAS 67213
PH.(316)262-8808 FAX.(316)262-1669

MARLAN DALE FORAKER LICENSED 10891 2-15-13 KANSAS PROFESSIONAL ENGINEER

PROJECT NO.: 20132092
ISSUE DATE: 02/15/2013
CONTACT: H. FORAKER, L. MILLS
CHECKED BY:

SITE PLAN FOR WEST ENTRANCE

2