

Conc. 0.6'± S. of Line & 0.8'± E. of Line


Fnc 0.3'± S. of line & 0.5'± E. of Line

SEWER line

84'

Fnc 0.6'± S. of line

Conc. 0.9'± S. of Line

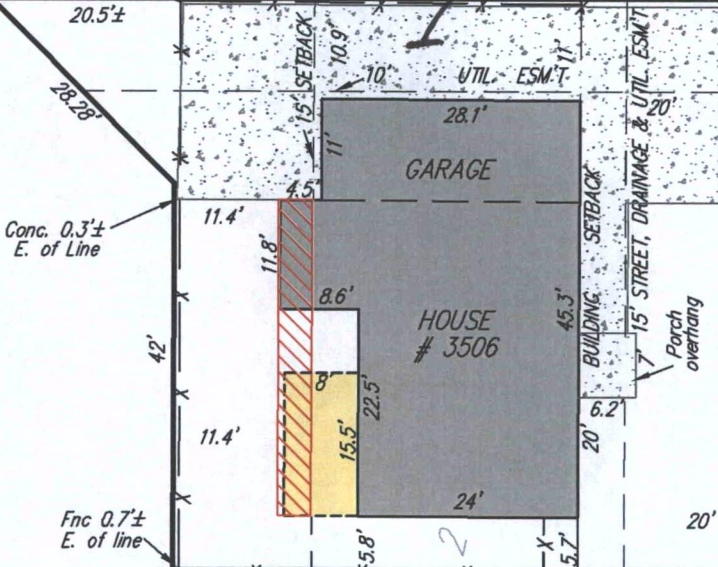

VAC 2014-13



UNIVERSITY AVENUE

ASSOCIATED WITH BZA 2014-31 (Variance)