


LEGAL DESCRIPTION: The west 30 feet of Lot 18 TOGETHER with all of Lot 19, Block D, E.B. Clark Addition, Wichita, Sedgwick County, Kansas.

AREA OF EASEMENT VACATION



AREA OF GARAGE ADDITION

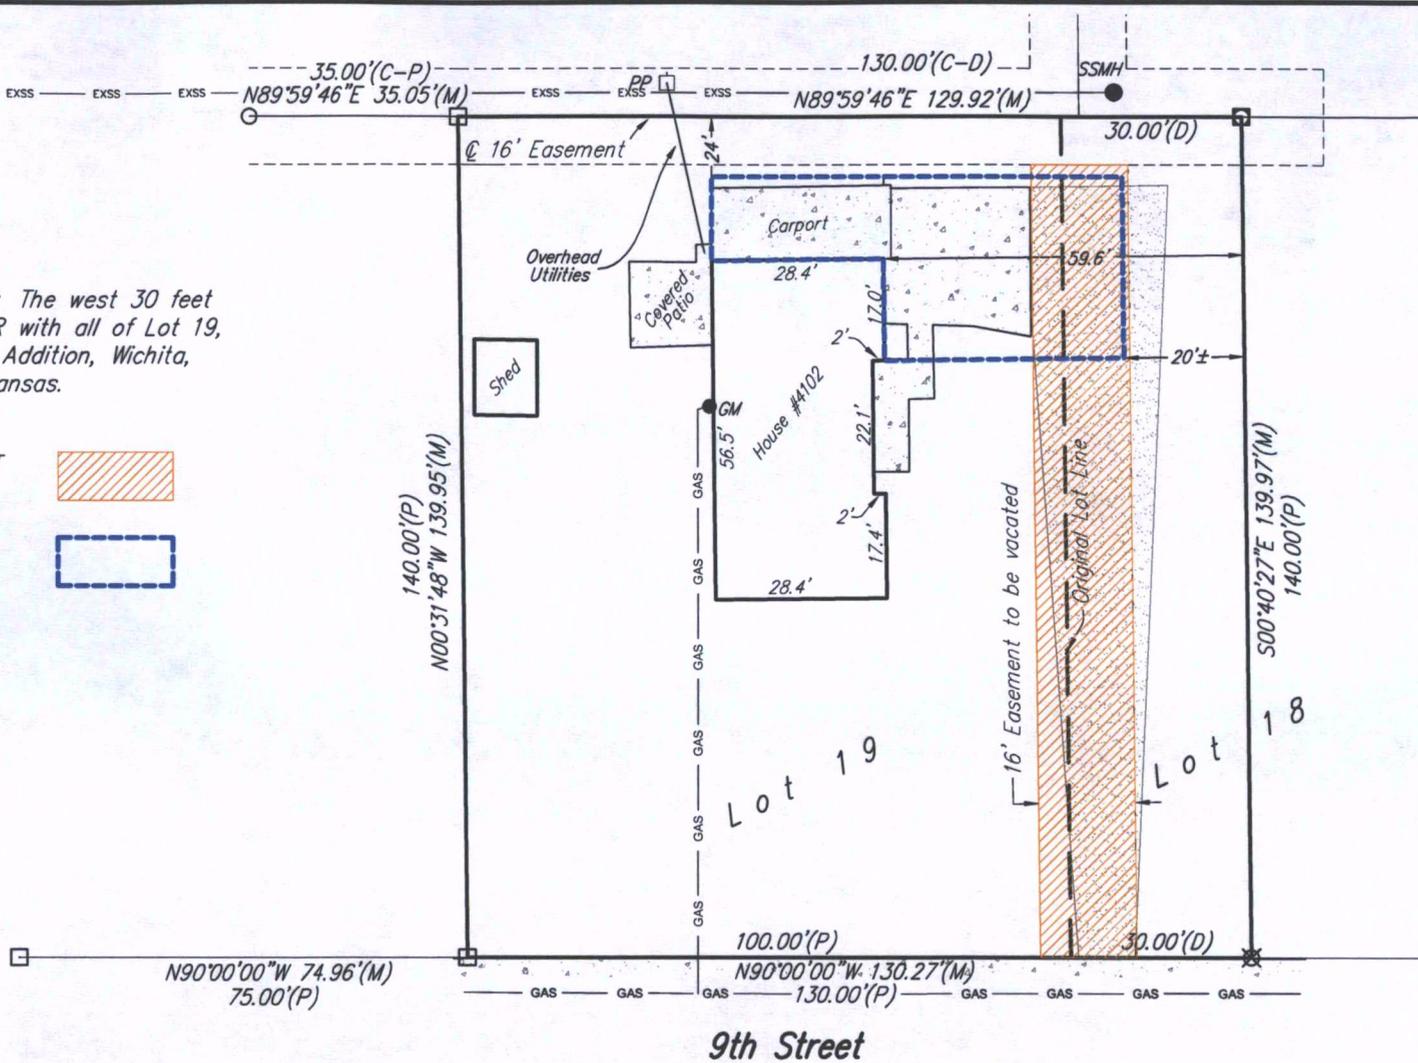

9th Street

VAC2014-14 EXHIBIT
4102 WEST 9TH STREET NORTH



SCALE: 1" = 20'



Baughman
ENGINEERING PLANNING LANDSCAPE ARCHITECTURE