



SITE PLAN

UAC 2014-18

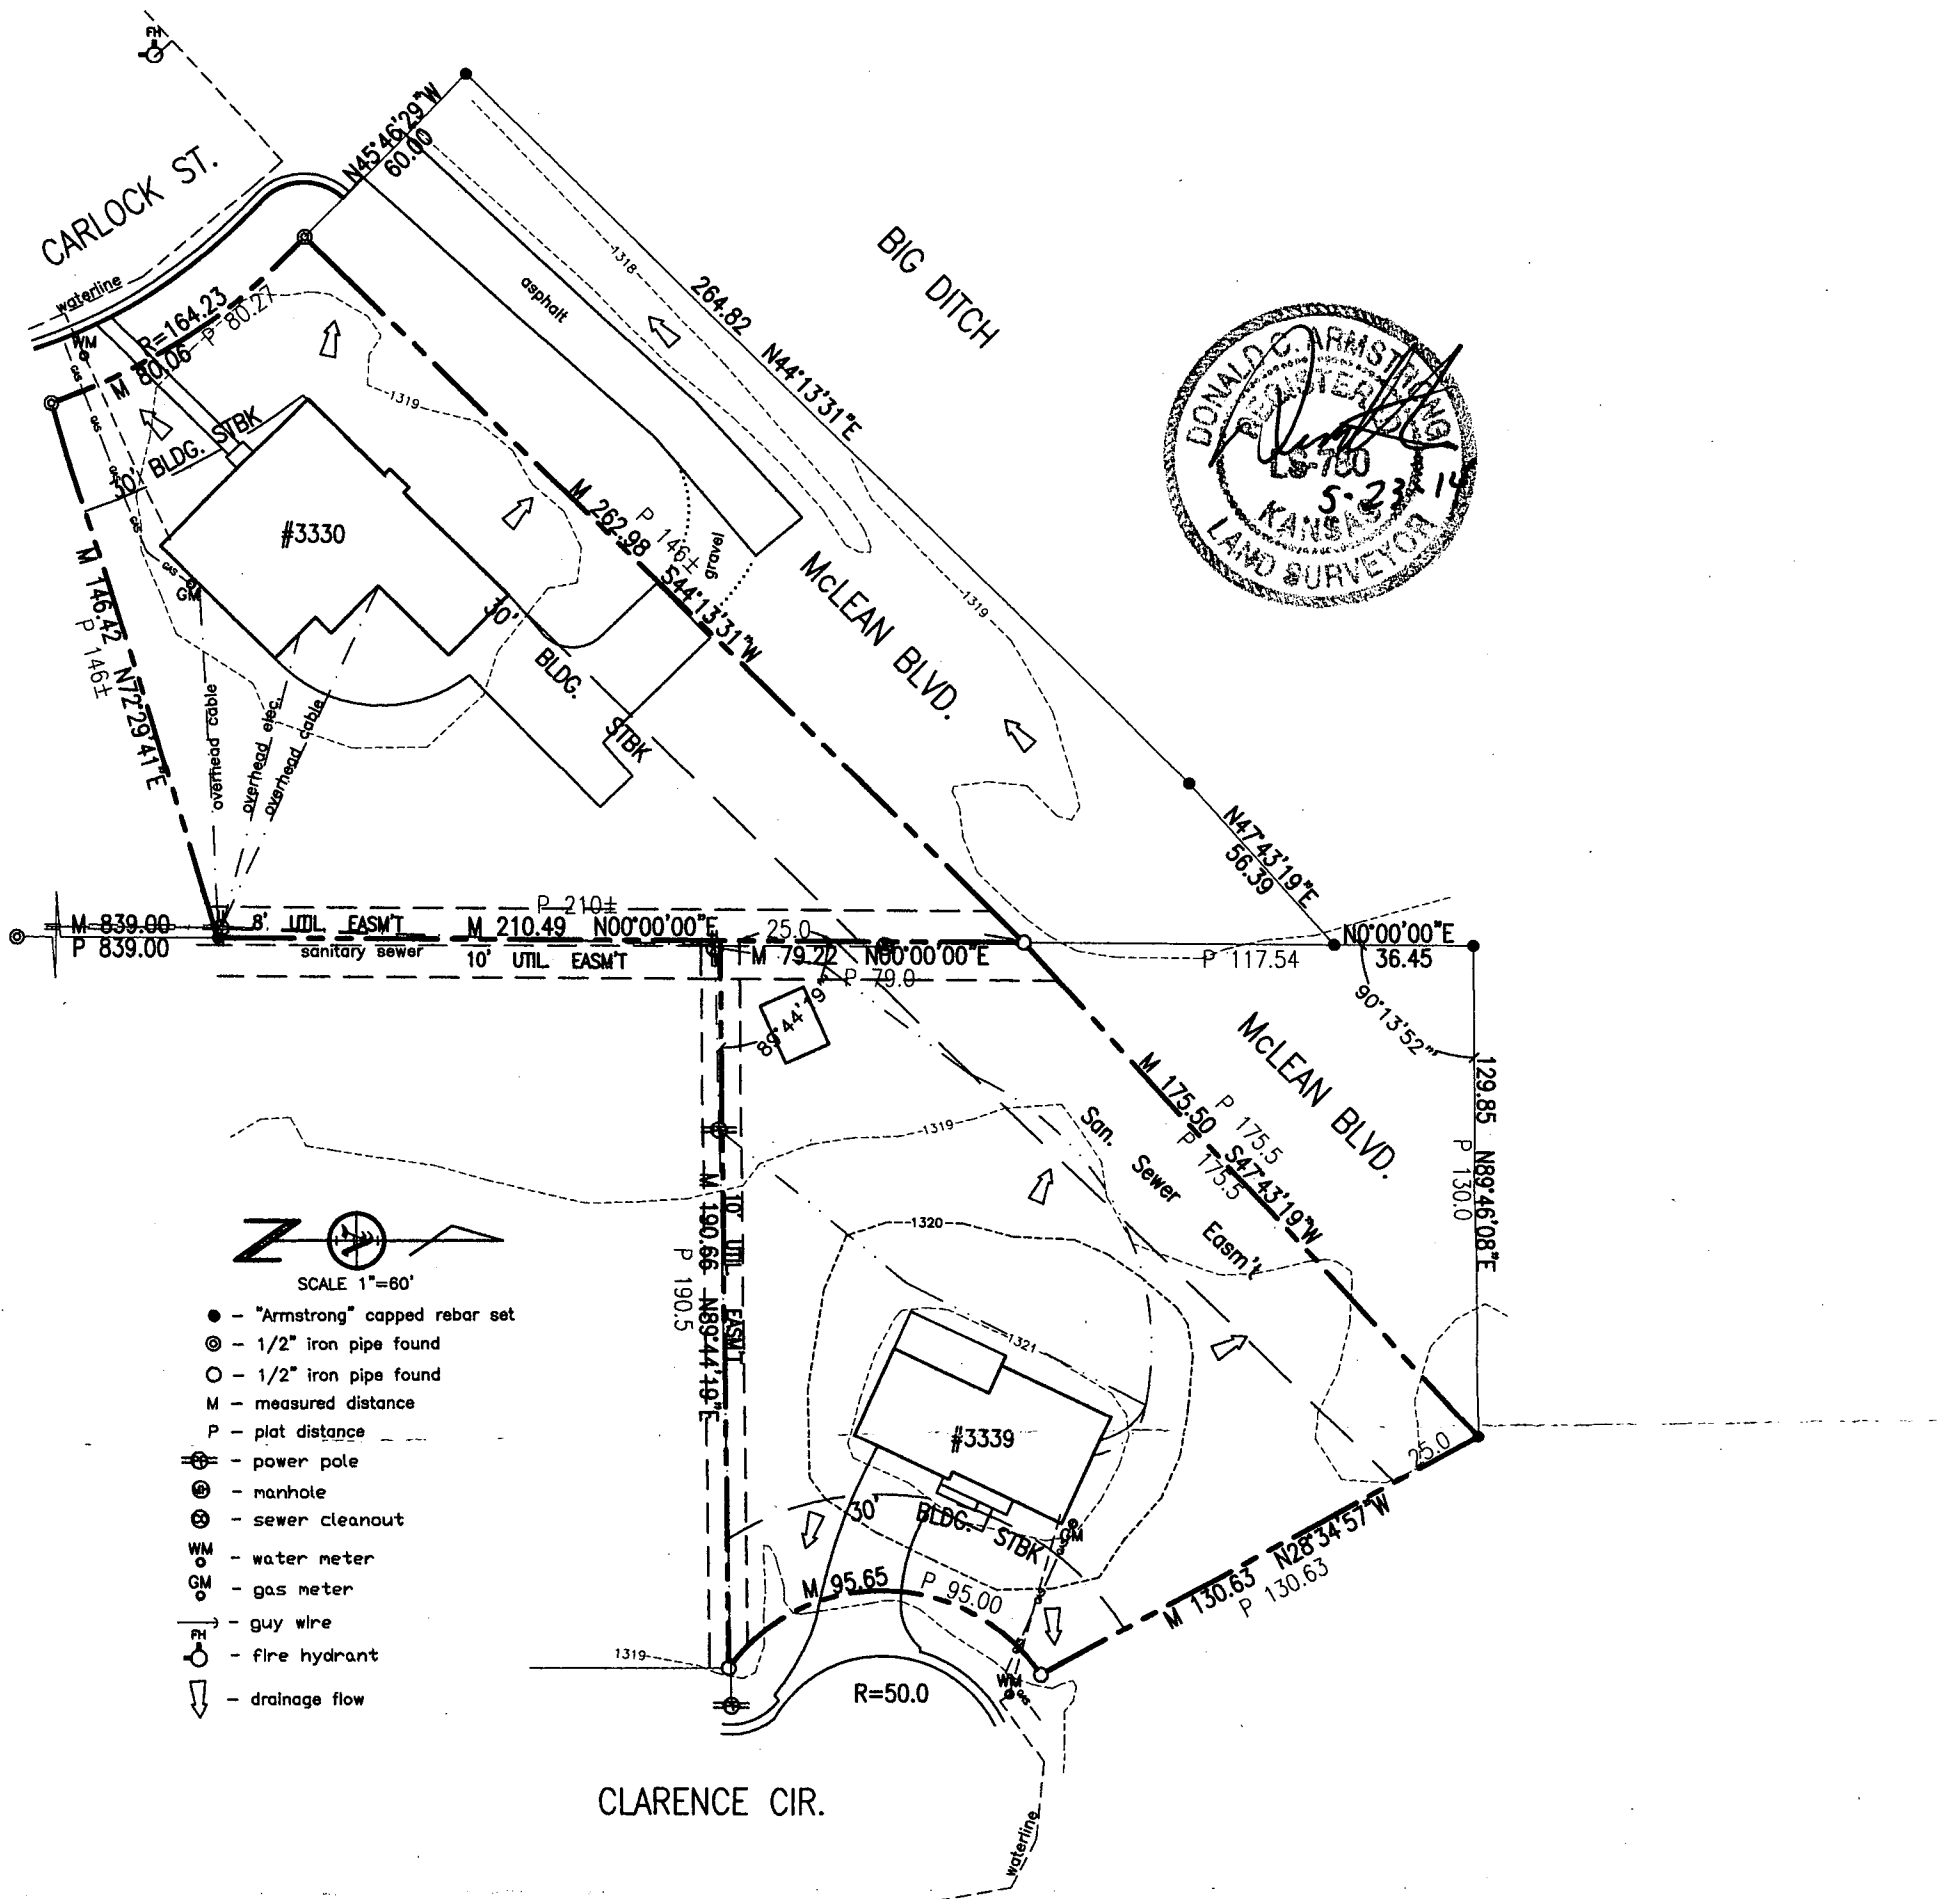

3330 N CARLOCK: LOT 8, BLOCK 4, PIERPOINT ACRES ADDITION, SEDGWICK COUNTY, KANSAS.
 3339 N CLARENCE: LOT 1, LADENE ADDITION, WICHITA, SEDGWICK COUNTY, KANSAS.

	ARMSTRONG	1601 E. HARRY
	LAND SURVEY, P.A.	WICHITA, KS 67211
		PH. (316) 263-0082
		FX. (316) 263-0092