AN

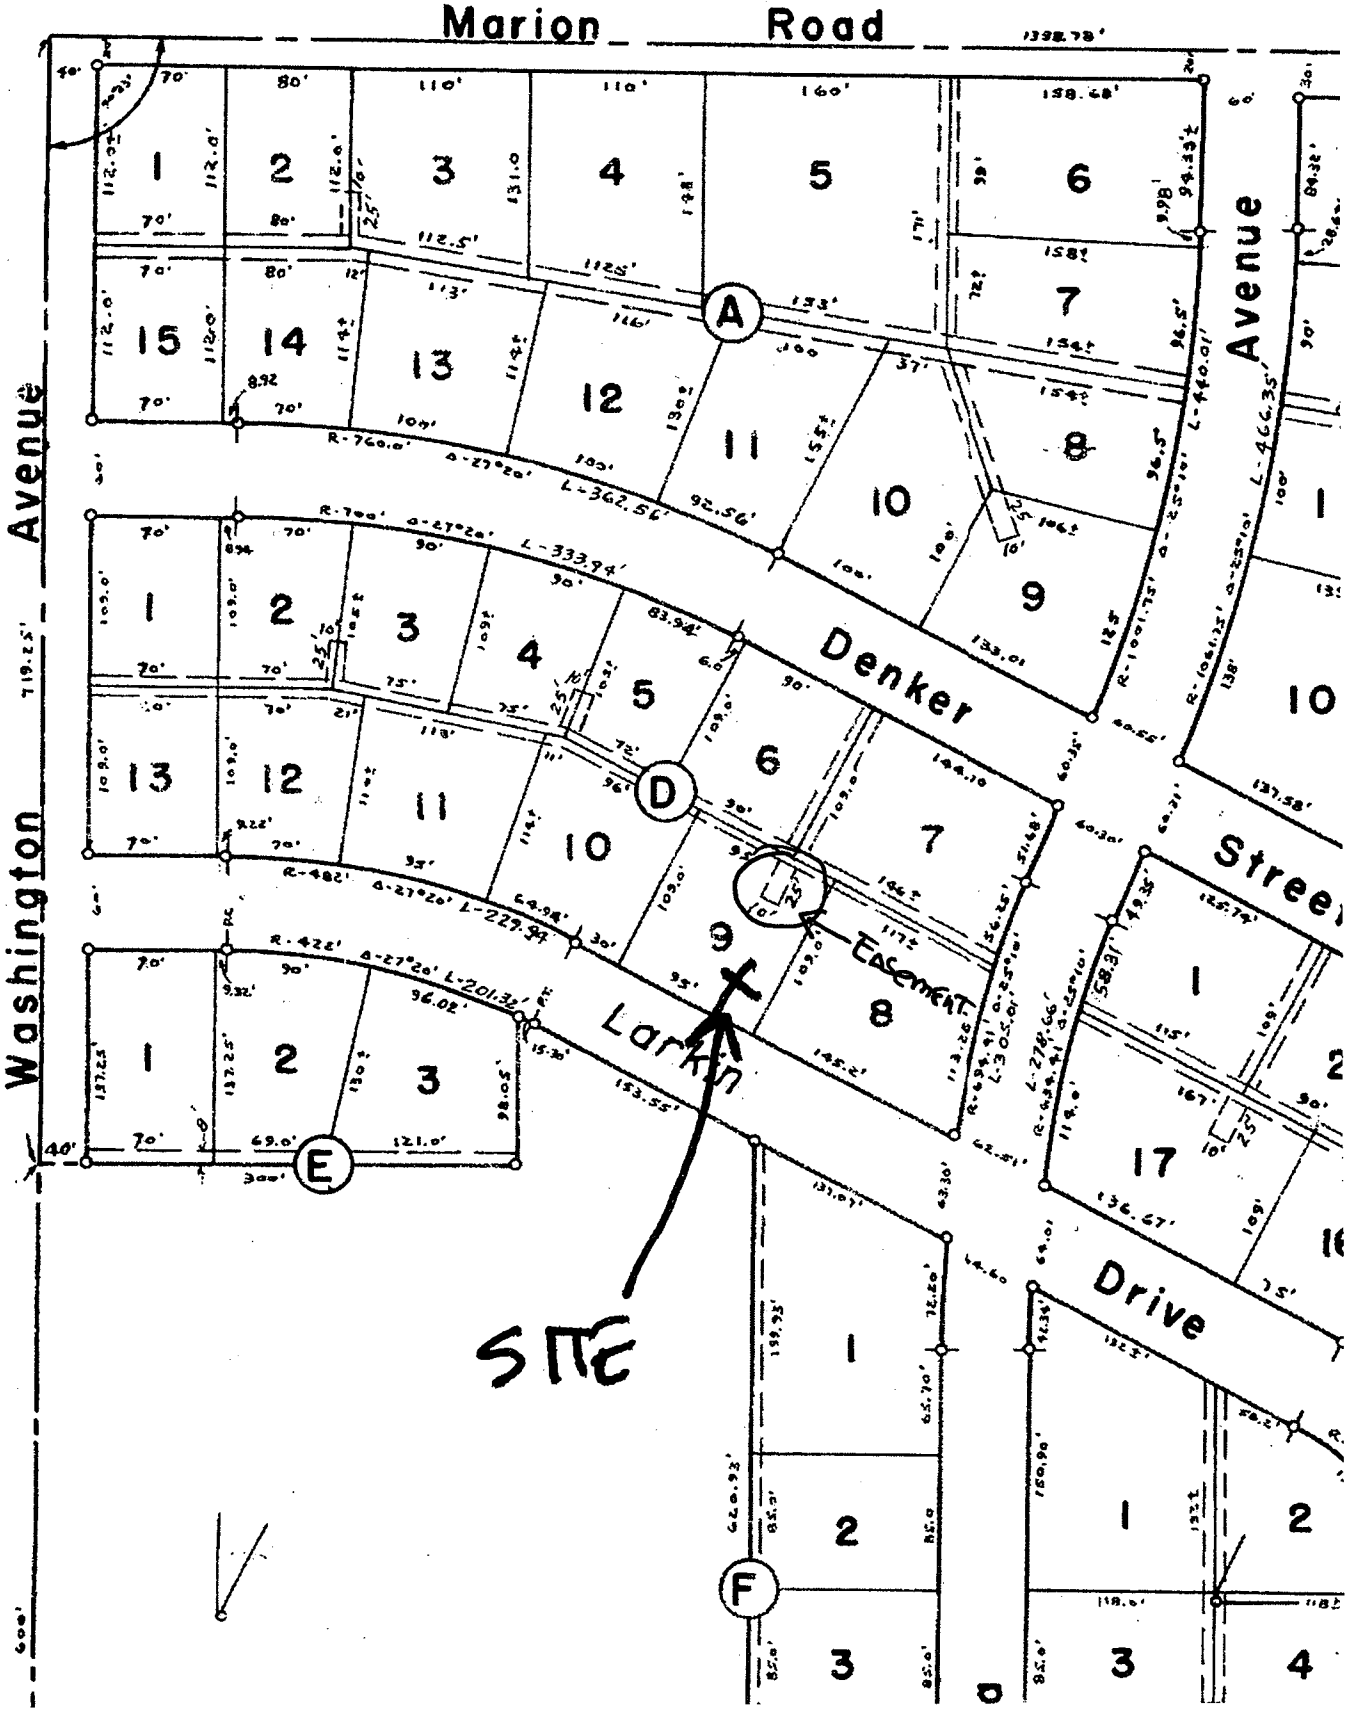
Marion Road
Washington Avenue
Denker Avenue
Larkin Street
Drive
Easement
SITE
A
D
E
F