



Wichita-Sedgwick County Metropolitan Area Planning Department

CORRECTED

February 22, 2017

~~February 13, 2017~~

Central Plains Development
c/o Brian Flores
3620 E. Sunnybrook Ste A
Wichita, KS 67210

Ref: VAC2014-00020 - City request to vacate a platted easement on property generally located southwest of the Pawnee Avenue - George Washington Boulevard intersection and northeast of the Cessna - Roseberry Streets intersection.

Dear Mr. Flores:

At its regular meeting on Tuesday, December 13, 2016, the Wichita City Council considered the above-referenced request. The action of the City Council was to **APPROVE** subject to the recommendation by the MAPC.

If you have any questions about this matter, please call 268-4421.

Sincerely,

Stephen Banks
Senior Planner

SB:klw

cc: Hawkins Marital Trust, c/o Craig A. Kreiser, Co-Trustee, PO Box 9510, Wichita, KS, 67277
Victor Torres, 3912 E Roseberry, Wichita KS 67210



**BEFORE THE CITY COUNCIL OF THE
CITY OF WICHITA, SEDGWICK COUNTY, KANSAS**

**IN THE MATTER OF THE VACATION OF A PLATTED)
UTILITY EASEMENT)**

**GENERALLY LOCATED SOUTHWEST OF THE EAST)
PAWNEE AVENUE & SOUTH GEORGE WASHINGTON)
BOULEVARD INTERSECTION & NORTHEAST OF THE)
CESSNA & ROSEBERRY STREETS INTERSECTION)
MORE FULLY DESCRIBED BELOW)**

VAC2014-00020

VACATION ORDER

NOW on this 13th day of December, 2016, comes on for hearing the petition for vacation filed by Victor Hugo Torres & Central Plains Development c/o Brian Flores, member (owners), praying for the vacation of described portion of a platted utility easement, to-wit:

The platted 8-foot wide utility easement centered on and running parallel (north-south) to the common lot line of Lots 2 & 5, Block D, Planeview Subdivision No.1, Wichita, Sedgwick County, Kansas, all other easements will remain in effect.


The City Council, after being duly and fully informed as to fully understand the true nature of this petition and the propriety of granting the same, makes the following findings:

1. That due and legal notice has been given by publication, as required by law, in The Wichita Eagle on July 3, 2014, which was at least 20 days prior to the public hearing.
2. No private rights will be injured or endangered by the vacation of the described portion of the platted utility easement and the public will suffer no loss or inconvenience thereby.
3. In justice to the petitioner(s), the prayer of the petition ought to be granted.
4. No written objection to said vacation has been filed with the City Clerk by any owner or adjoining owner who would be a proper party to the petition.

5. The vacation of the described portion of the platted utility easement, should be approved.

IT IS, THEREFORE, BY THE CITY COUNCIL, on this 13th day of December, 2016, ordered that the described portion of the platted utility easement is vacated. IT IS FURTHER ORDERED that the City Clerk shall send this original Vacation Order to the Register of Deeds of Sedgwick County.

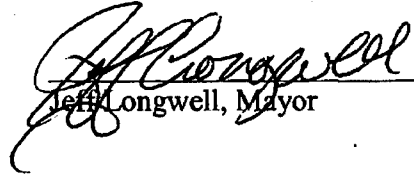



Jeff Longwell, Mayor

ATTEST:


Karen Sublett, City Clerk

Approved as to Form:

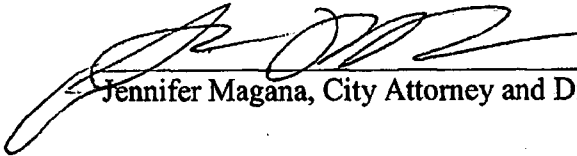
Jennifer Magana, City Attorney and Director of Law

Take to Title Company

↓ E. get



○ = notification

(+) = owners

X = owners

VAC 2014-20

SITE

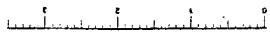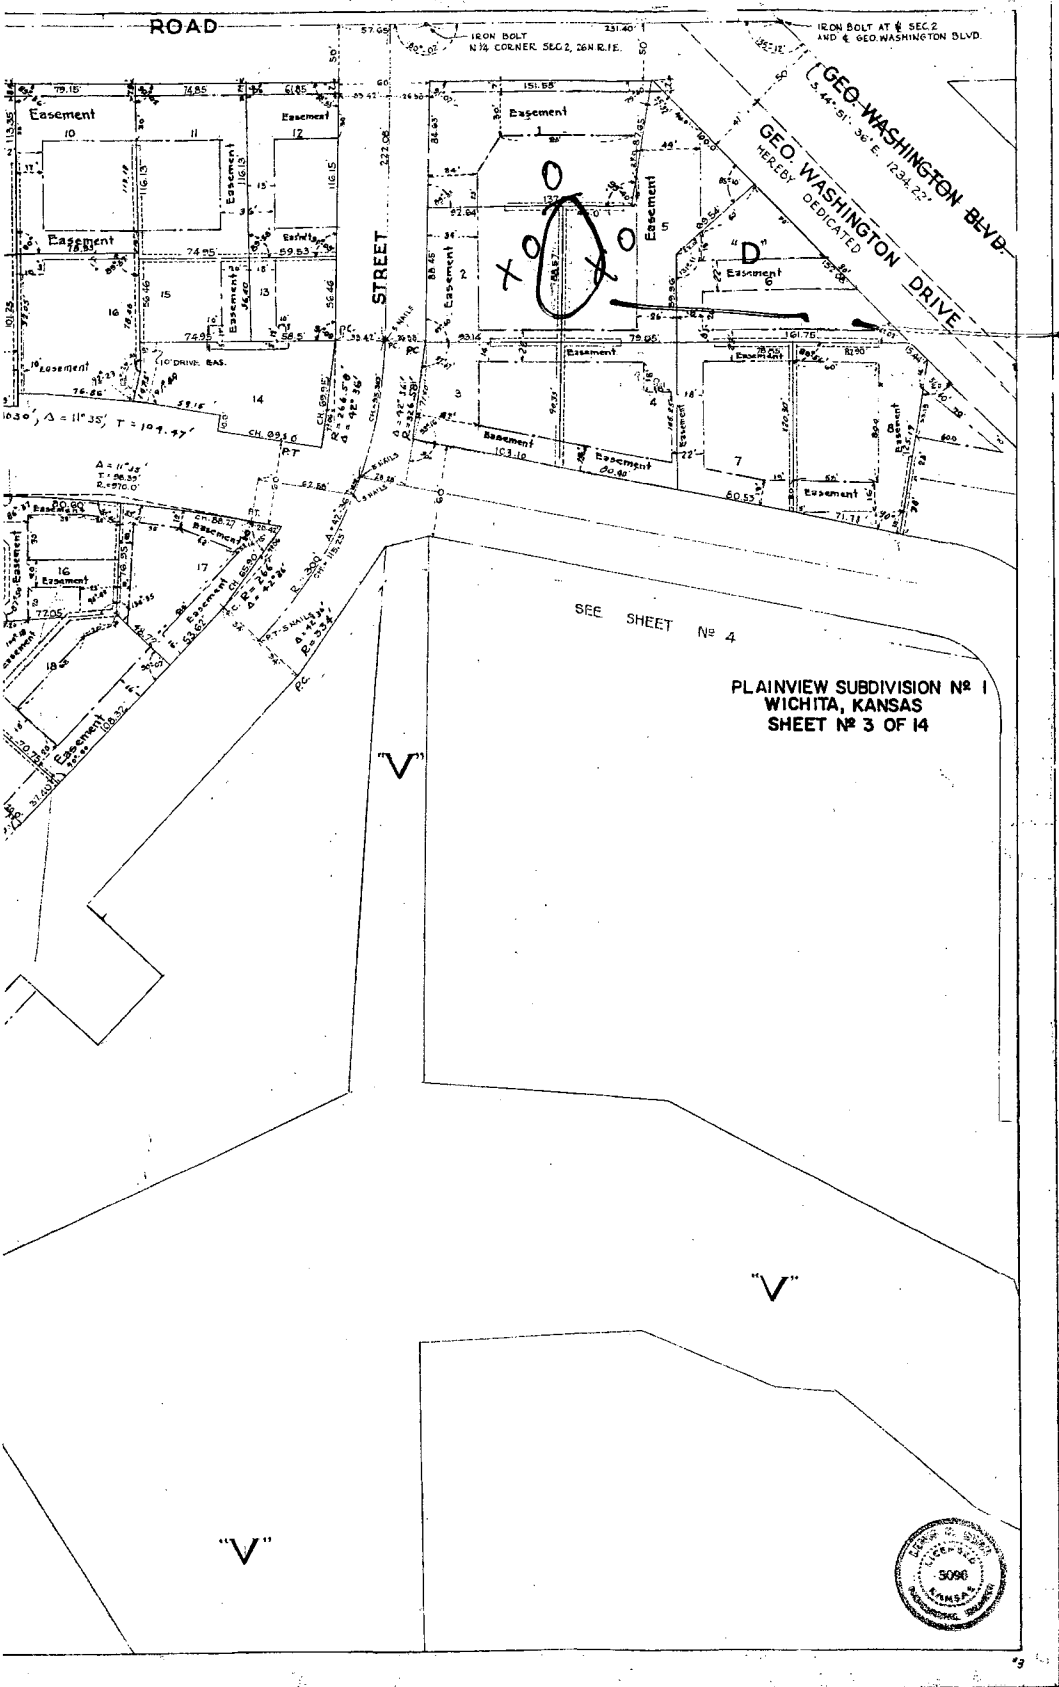

This digital plat record accurately reproduces in all details the information contained in the original record as filed with the Sedgewick County Register of Deeds. Digitized under contract with Sedgewick County Geographic Information Systems.

Bill Meeke, Register of Deeds
 Digitized under contract with Sedgewick County Geographic Information Systems.

