


EXHIBIT


PART OF LOT 1, BLOCK 1, RIDGE PORT ADDITION

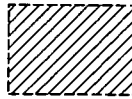

INDICATES AREA OF LEGAL DESCRIPTION OF DRAINAGE EASEMENT TO BE VACATED (DOC.#/FLM-PG: 29416578)




INDICATES AREA OF LEGAL DESCRIPTION OF WATER LINE EASEMENT TO BE VACATED (DOC.#/FLM-PG: 29416579)

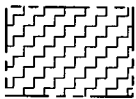

INDICATES AREA OF LEGAL DESCRIPTION OF UTILITY EASEMENT TO BE VACATED (DOC.#/FLM-PG: 29416580)



INDICATES AREA OF LEGAL DESCRIPTION OF WATER LINE EASEMENT TO BE VACATED (DOC.#/FLM-PG: 29424773)

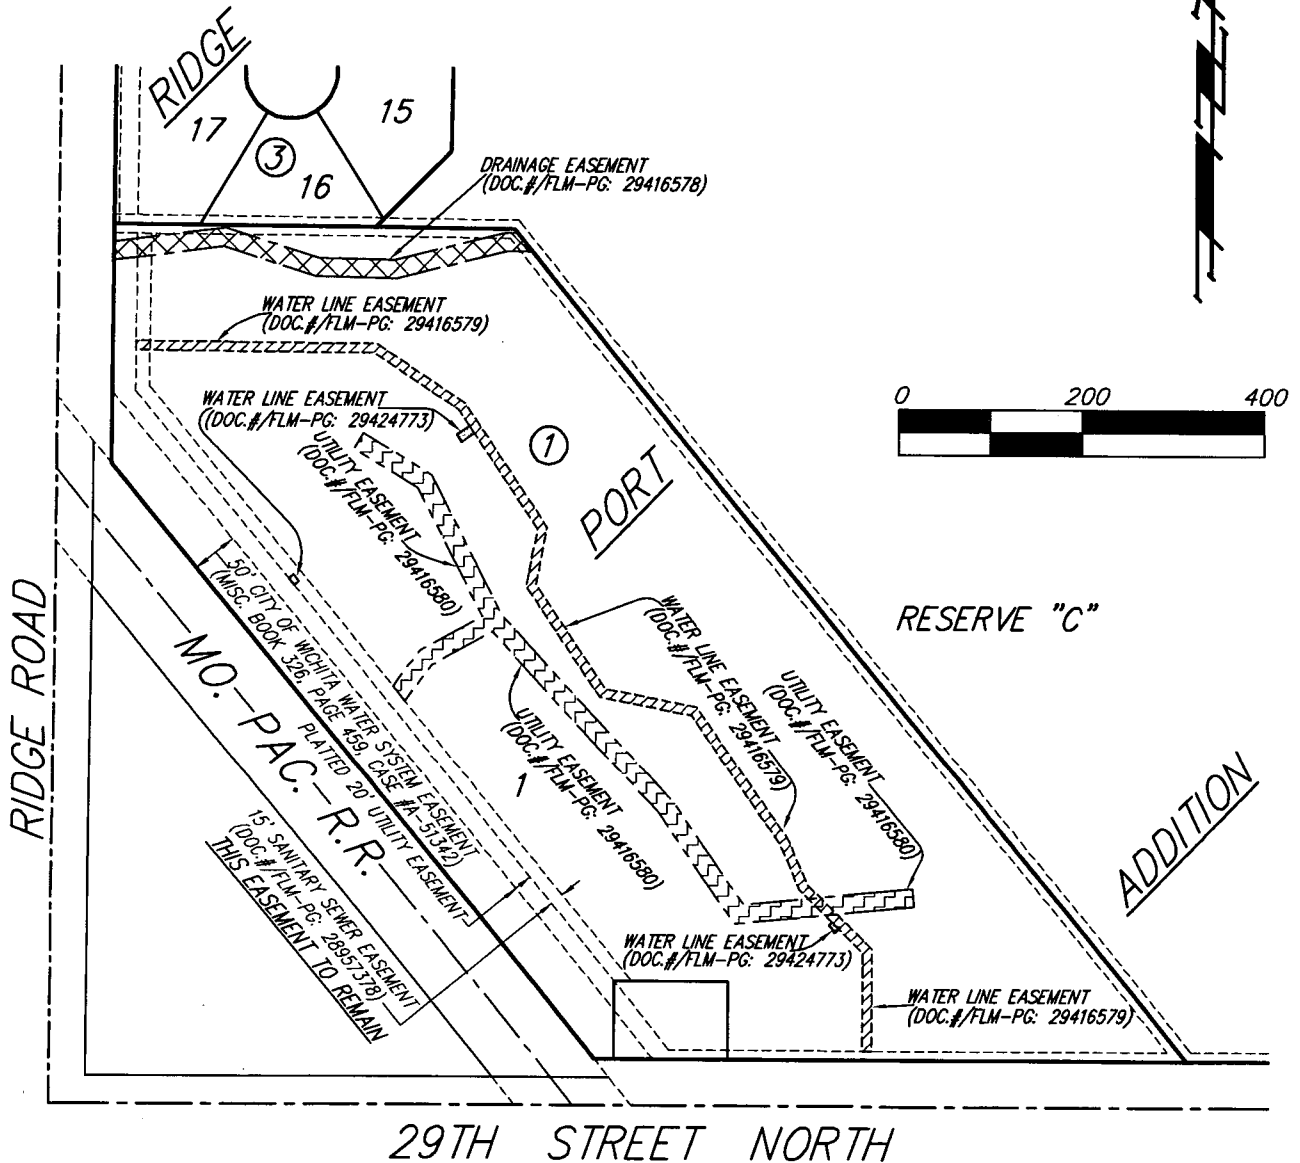

VAC2014-00046

21 OCT 2014

B Baughman Company, P.A.
 315 Ellis St. Wichita, KS 67211 P 316-262-7271 F 316-262-0149
 Baughman ENGINEERING | SURVEYING | PLANNING | LANDSCAPE ARCHITECTURE