


# FURLEY

Sedwick County,  
Kansas.

VA2014-52

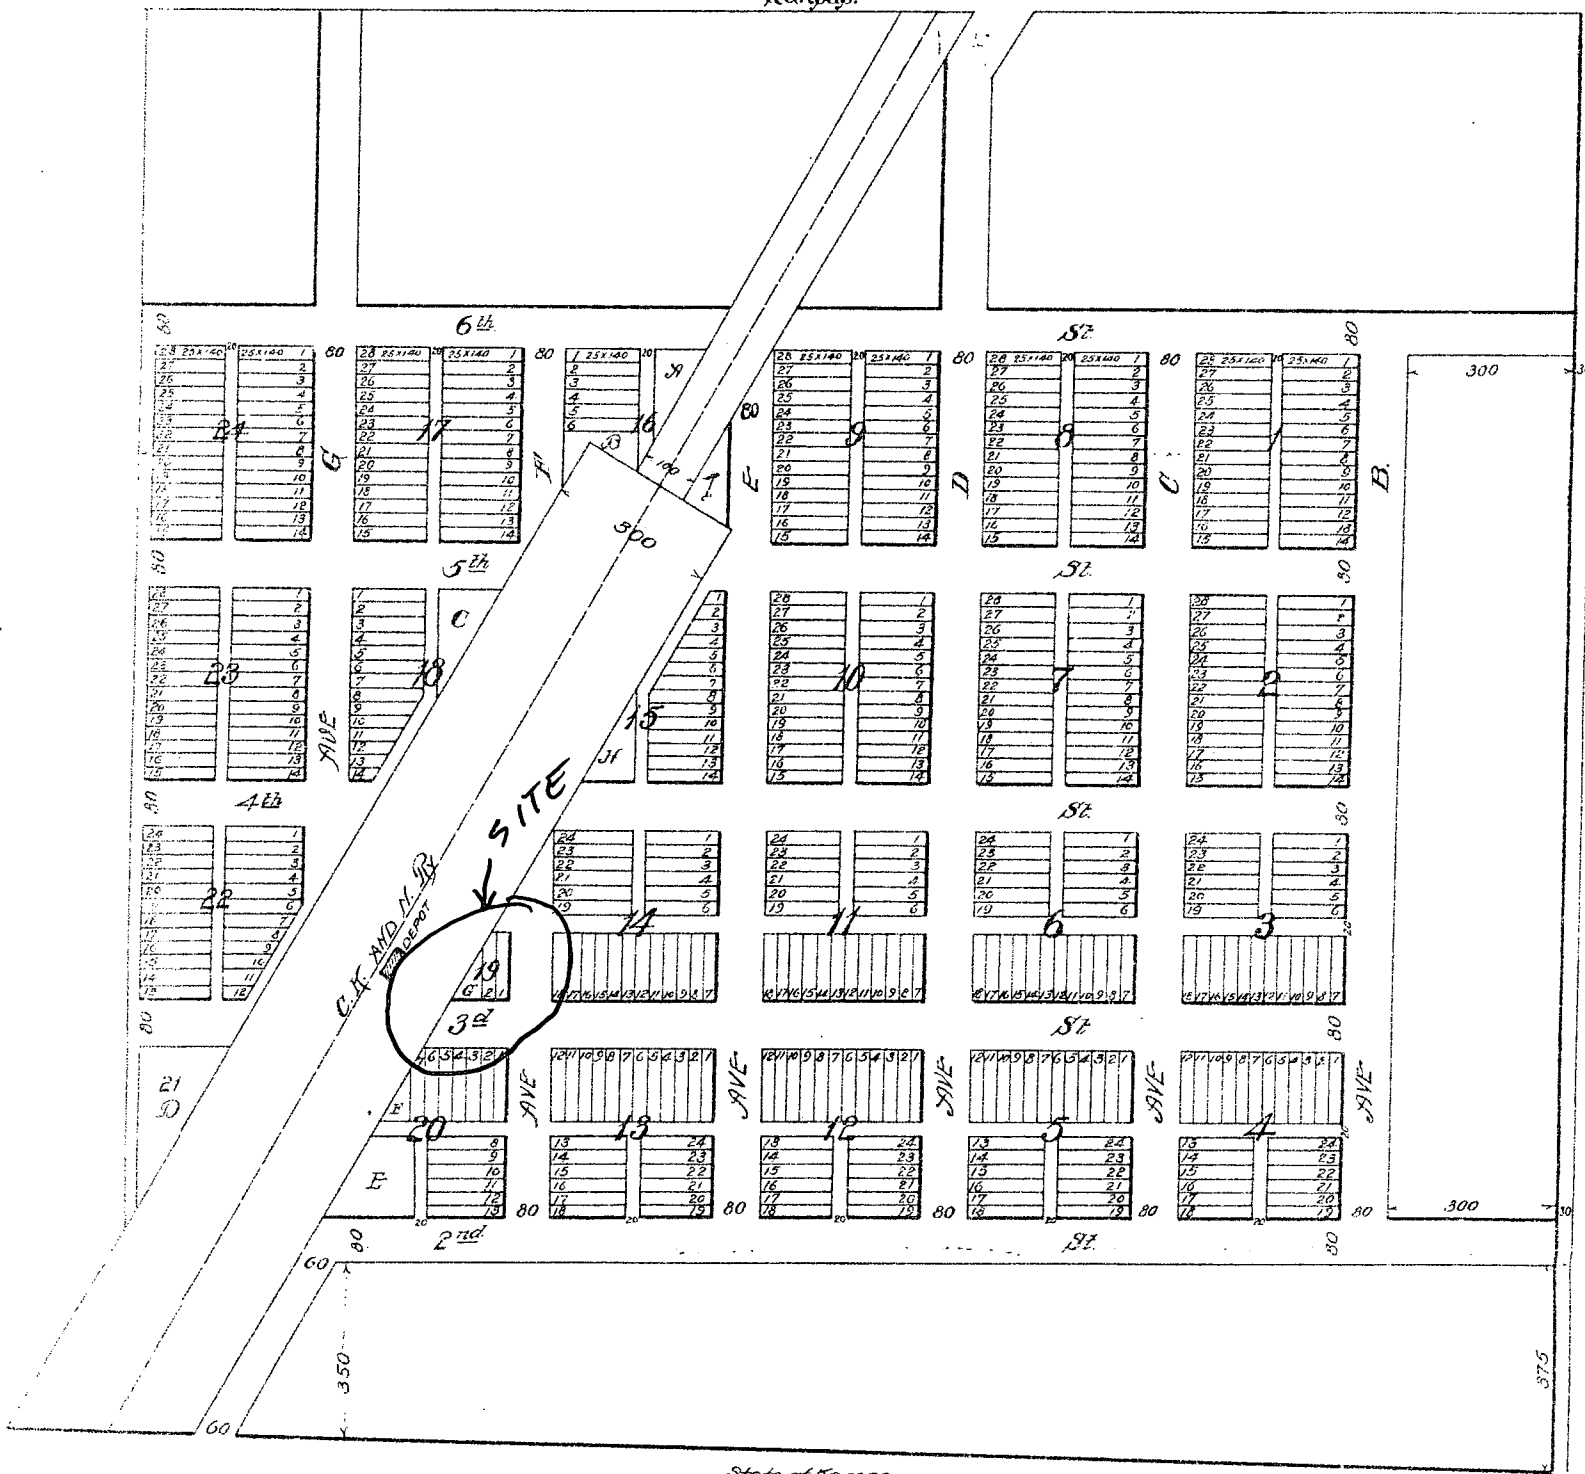

Know all men by these presents that the Golden Belt town Company a corporation duly organized under the laws of the State of Kansas has caused this plat to be made executed and filed by it as a map or plat of a town to be known as the town of Furley located on a part of the Northeast quarter of section sixteen (16) township twenty five (25) south of range two (2) east in Sedwick County, Kansas. More particularly described as follows: to wit: Beginning at a point on a line running north 10°40' west three hundred and seventy five (375) feet north of and three hundred and thirty (330) feet west of the south east corner of said quarter section running thence northerly on said line seventeen hundred and twenty feet (1720) thence westerly at a right angle to said line to the west line of said quarter section thence southerly on the west line of said quarter section seventeen hundred and twenty (1720) feet thence easterly on a line to the place of beginning. All streets and alleys are of the width indicated on plat all lots are 25 x 140 feet excepting those in blocks 15, 16, 17, 18, and 22 which are of such dimensions and bounded by such streets and alleys as indicated by plat. Frachon's A, B, C, D, E, F, G, H, I are of such shape and dimensions and bounded by such others grounds as plat indicates. All streets and alleys are hereby dedicated to the public use. In witness whereof the Golden Belt town Company has caused this plat to be subscribed by its President attested by its Secretary and the seal of said corporation to be fixed hereunto this day of May A.D. 1887.  
E.H. Holbrook, President.  
Charles C. Furley, Secretary.


State of Kansas, S.S.  
Marion County, Mo.  
Be it remembered that on this 20th day of May A.D. 1887 before me a Notary Public in and for said county personally came E.H. Holbrook and to me known to be the identical person described in and who executed the foregoing plat as president of the Golden Belt town company and who duly acknowledged the execution of the same. In testimony whereof I have hereunto set my hand and official seal on the day and year above written.  
Willis Hesterbrook,  
Notary Public.  
Notary term expires Jan'y 29-1888.

FILED 20 MAY 1887 AND RECORDED  
IN PLAT BOOK P  
PAGE 1  
H.D. HENDERSON, REGISTER OF DEEDS  
GEO. A. BEANSE, DEPUTY.

ENTERED ON TRANSFER  
RECORDED  
MAY 20 1887  
E. R. FORD, CLERK.



State of Kansas, S.S.  
Sedwick County, Mo.  
Be it remembered that on this 20th day of May 1887 before me a Notary Public in and for said county personally came one C.C. Furley and to me known to be the identical person described in and who executed the foregoing plat as secretary of the Golden Belt town Company and duly acknowledged the execution of the same. In testimony whereof I have hereunto set my hand and official seal the day and year above written.  
W.J. Holbrook,  
Notary Public.  
Notary term expires June 9-1890.

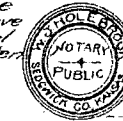

I, Joseph E. Bennett,  
Register of Deeds of  
Sedwick County, Kansas,  
do hereby certify that the  
above is a true and correct  
copy of the plat of Furley,  
Sedwick County, Kansas,  
that the original of which  
above is a copy, is on file in  
my office and that I have  
the legal custody thereof.  
Witness my hand and the  
seal of my office this 20th day  
of Feb. 1912.

Joseph E. Bennett  
Register of Deeds



This digital plat record accurately reproduces in all details the original plat filed with the Sedwick County Register of Deeds. Digitized under the supervision of Register of Deeds Bill Meek by Sedwick County Geographic Information Systems.

Bill Meek, Register of Deeds  
Digitized under the supervision of Register of Deeds Bill Meek by Sedwick County Geographic Information Systems.