F. N. I. C. ADDITION

WICHITA, KANSAS.
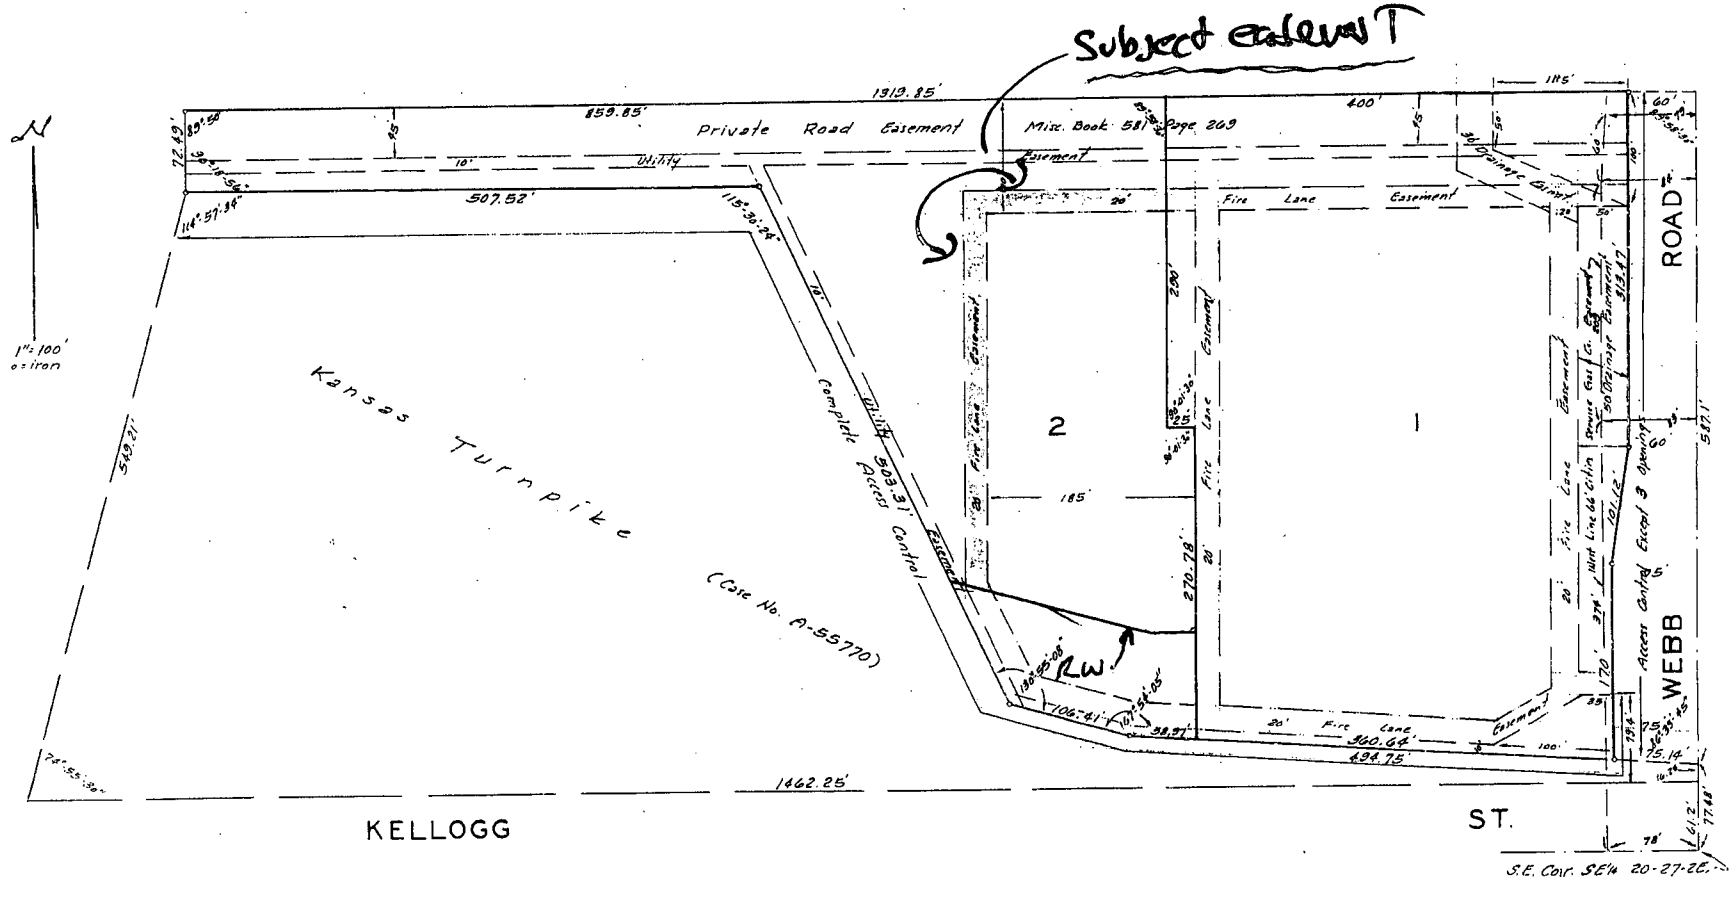
UPC2015-56