


# MC GINTY

WICHITA, KA

VOC2015-57

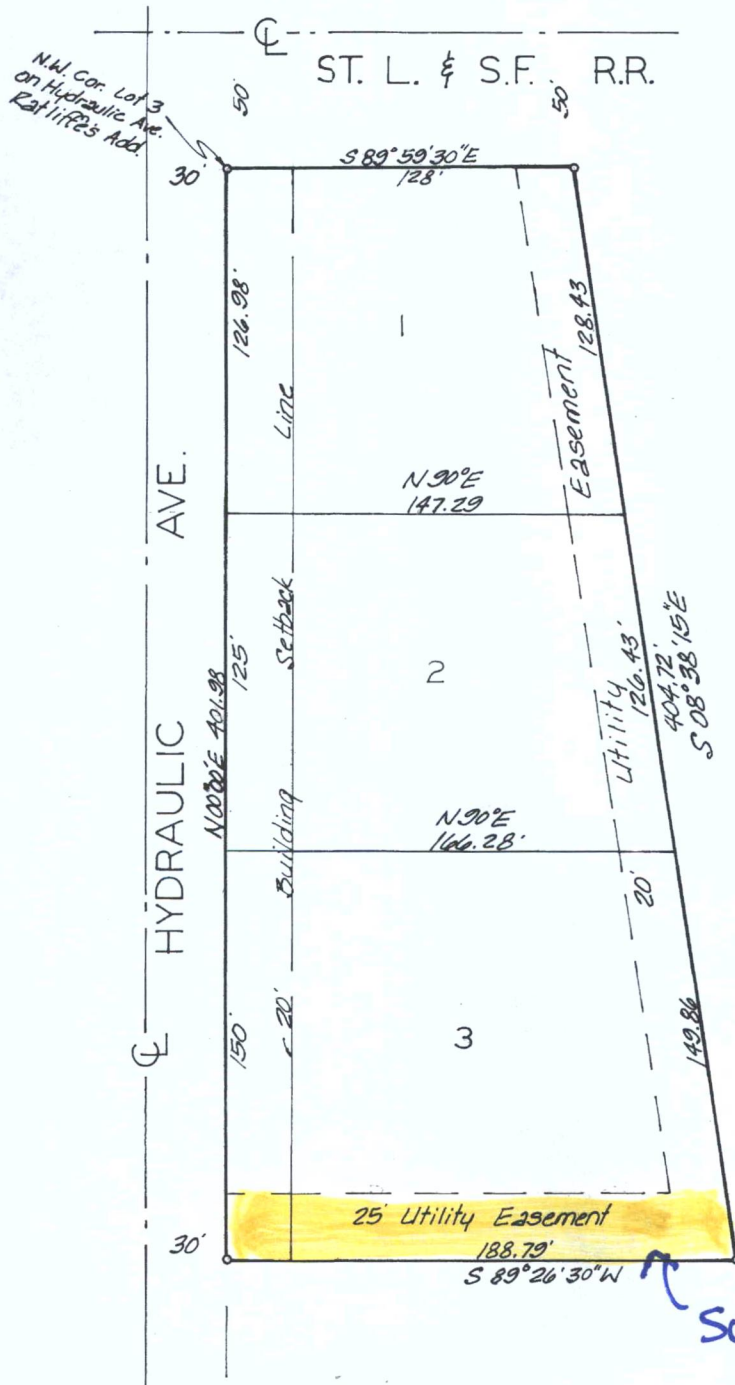

135

INTERSTATE



Subject easement