


ONE FULL
INCH PER
FOOT
VERTICAL
SCALE

ACCESS CONTROL PER ACCESS MANAGEMENT REGULATIONS 443.43'
[SEE ACCESS CONTROL NOTE]

ACCESS CONTROL PER ACCESS MANAGE
[SEE ACCESS CONT]

Basis of Bearings: Kansas Coordinate System 1983 South Zone Grid bearing of N00°55'
1323.59'(CM)

Street Dedication (width varies)

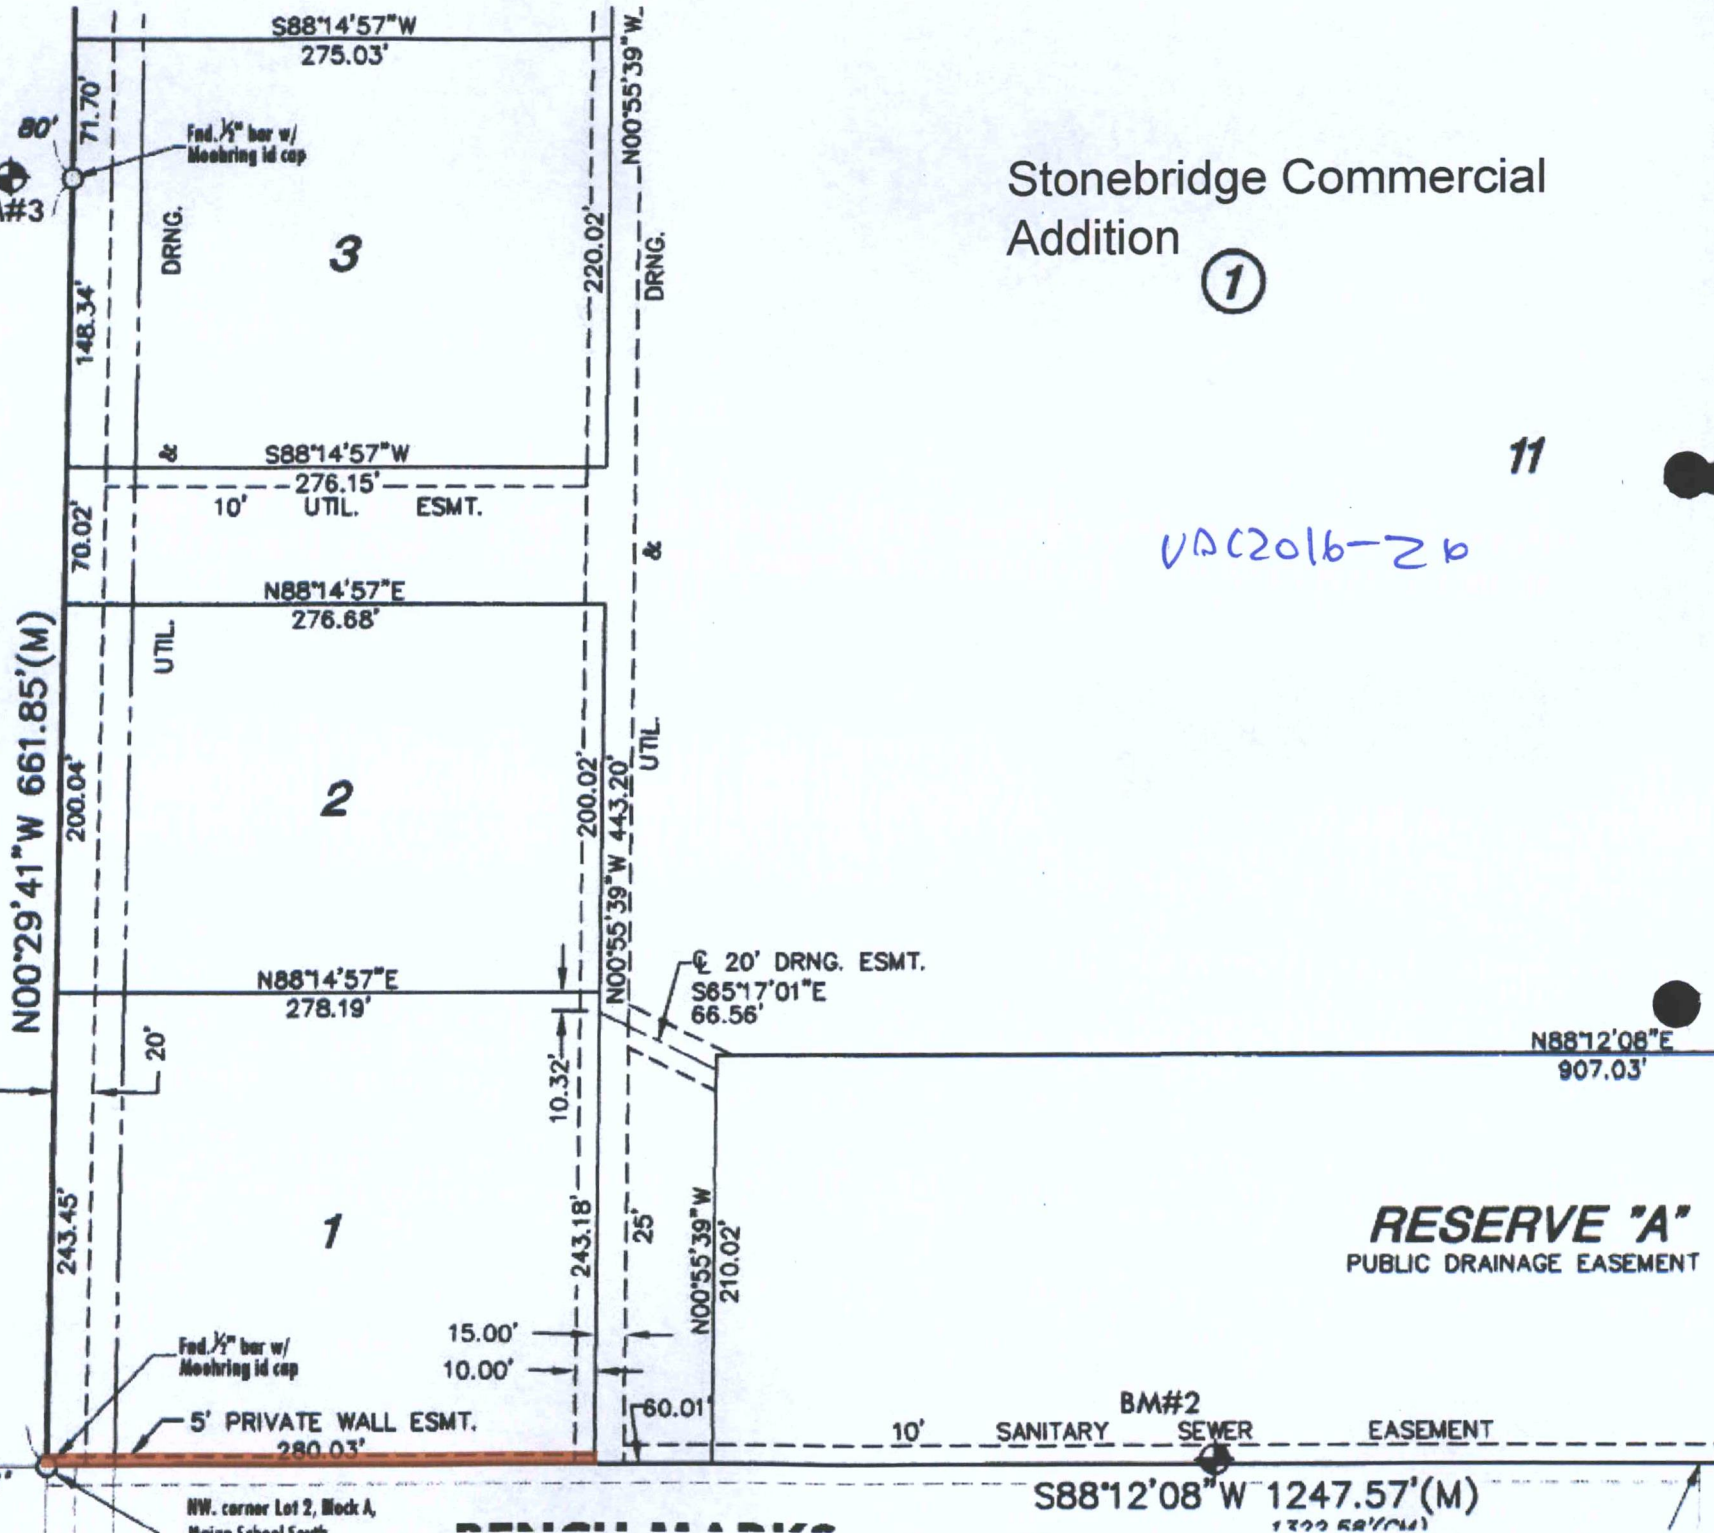

Stonebridge Commercial Addition

①

11

VAC2016-26

RESERVE "A"
PUBLIC DRAINAGE EASEMENT

S88°12'08"W 1247.57'(M)
1322.58'(CM)

NW 1/4, 1

NW corner Lot 2, Block A,
Maine School South