


VAC 2016-28

MAYWOOD 64'

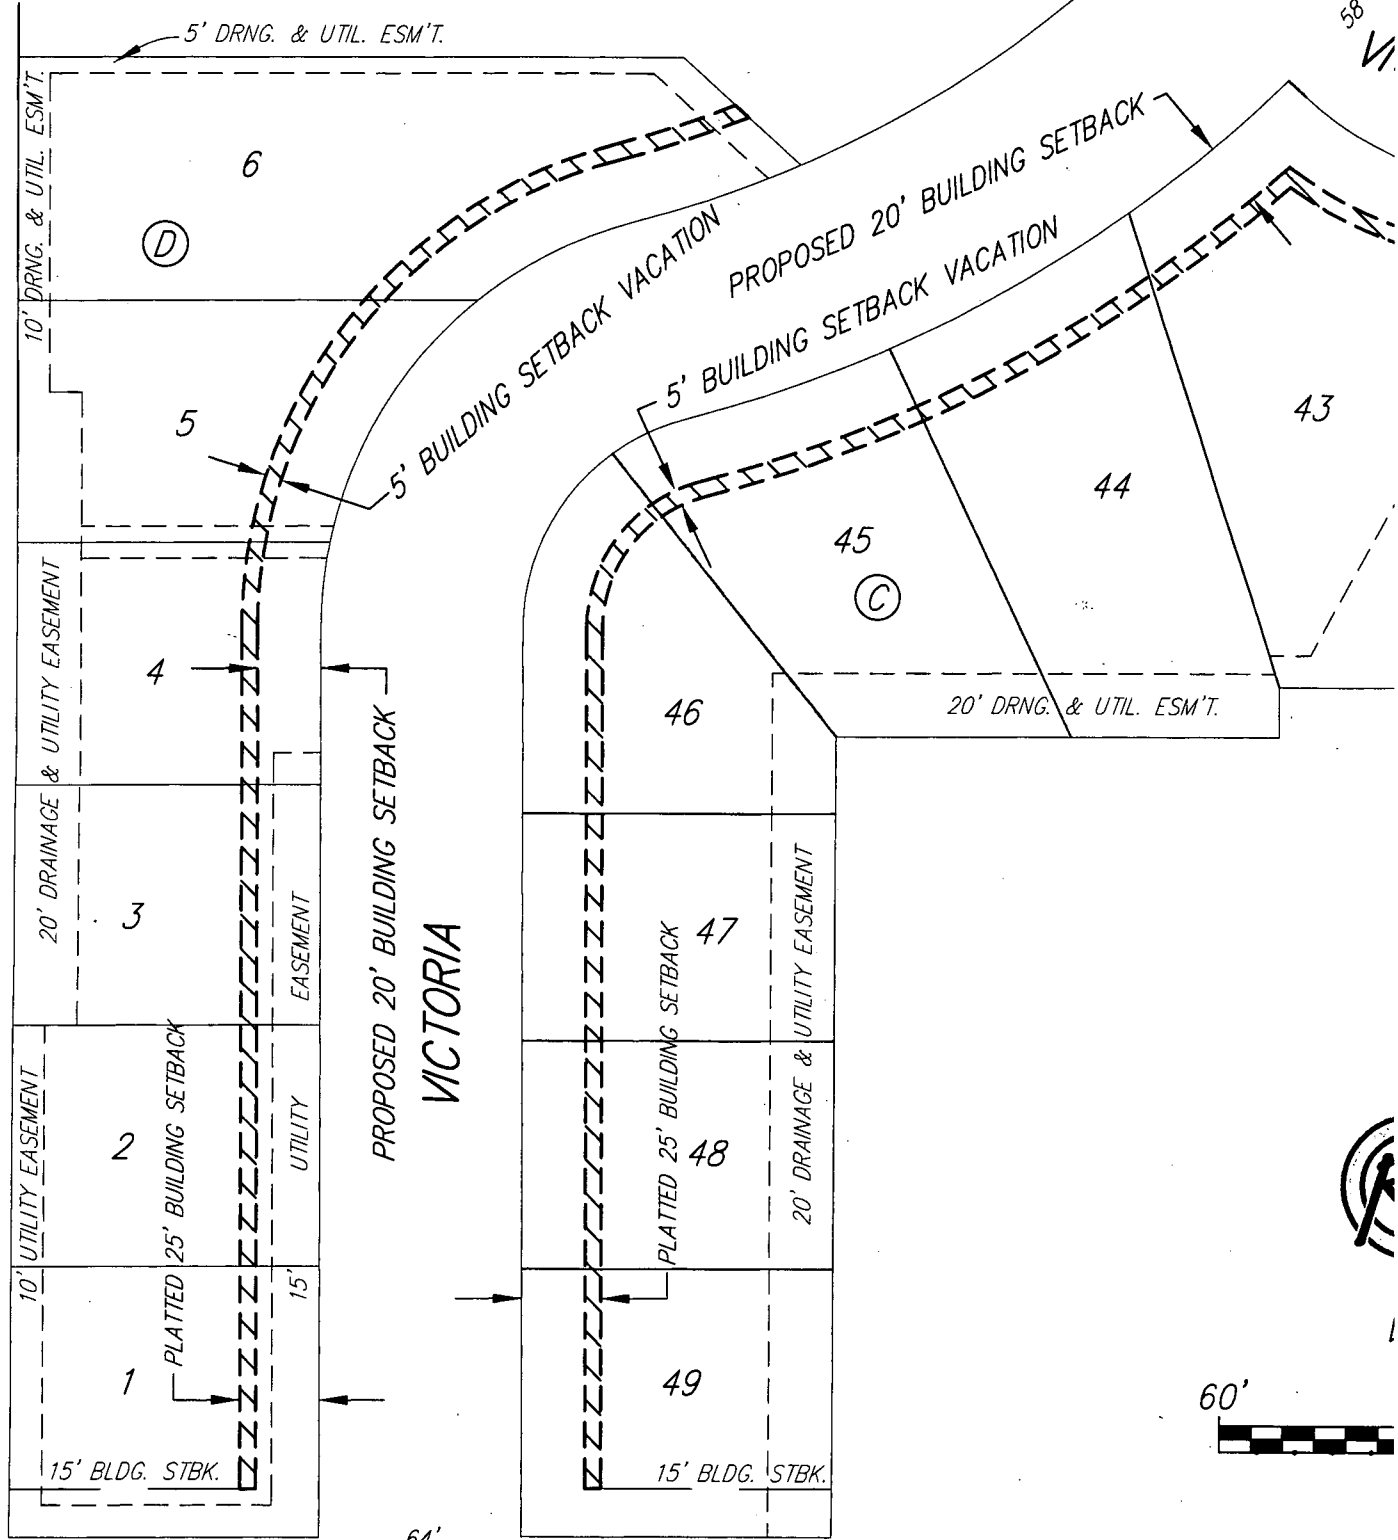

55TH ST. S.