



Wichita-Sedgwick County Metropolitan Area Planning Department

November 28, 2016

Ruggles & Bohm, P.A
c/o Will Clevenger
934 N. Main
Wichita, KS 67203

Ref: VAC2016-00044 - Request to Vacate a Portion of Platted Setbacks on Property Generally Located South of West 37th Street North, West of North Hoover Road on Both Sides of Venice Court (District V)

Dear Mr. Clevenger:

At its regular meeting on Tuesday, November 22, 2016, the Wichita City Council considered the above-referenced request. The action of the City Council was to **APPROVE** subject to the recommendation by the MAPC.

If you have any questions about this matter, please call 268-4421.

Sincerely,

A handwritten signature in black ink, appearing to read 'Bill Longnecker', written over the typed name.


Bill Longnecker
Senior Planner

BL:klw


cc: Siena Lakes #2, LLC, c/o Jay Russell, PO Box 75337, Wichita, KS 67275

SITE PLAN

VENICE

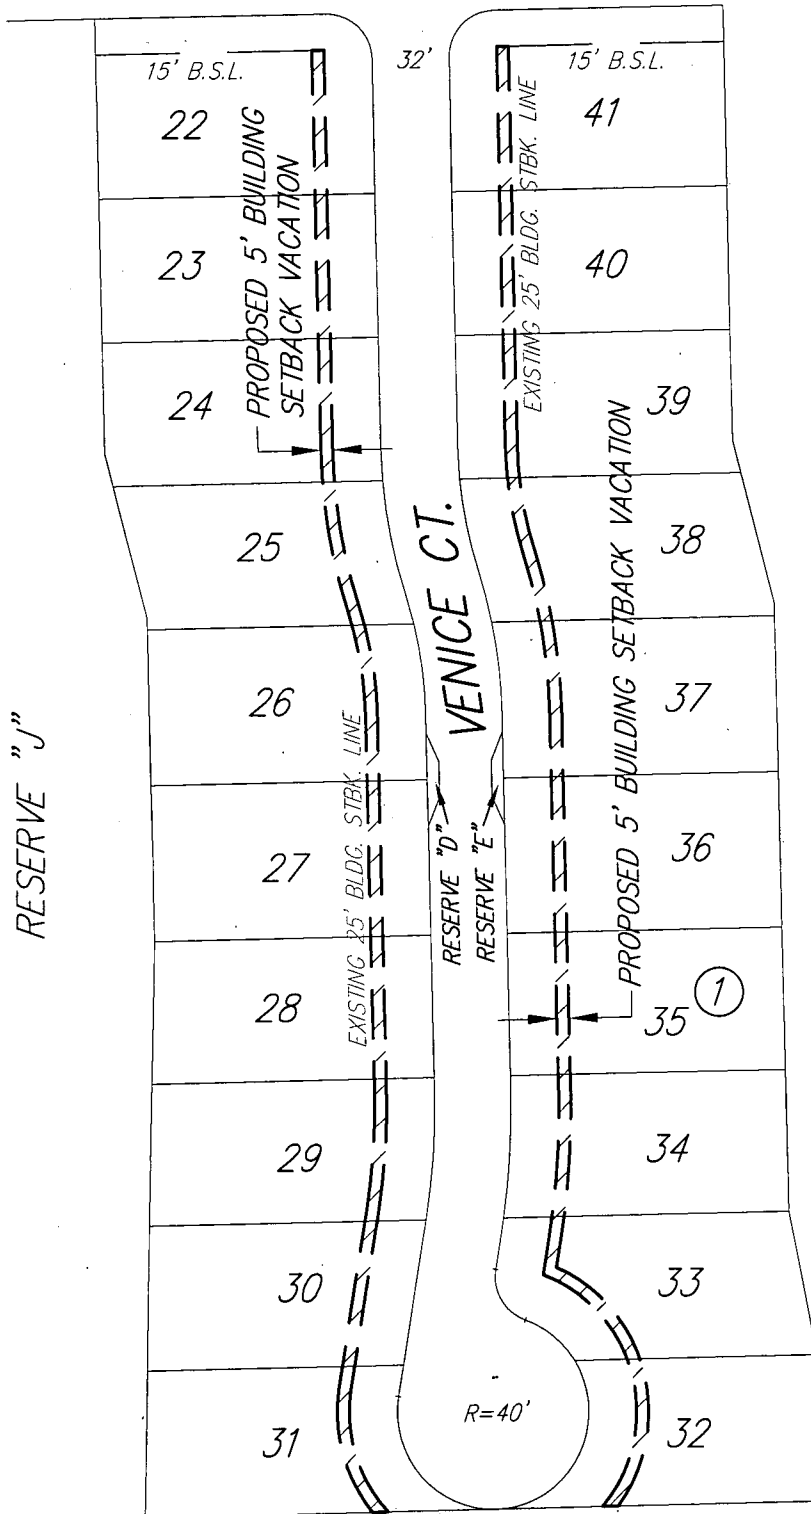

RESERVE "J"

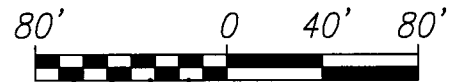

VA 2016-44