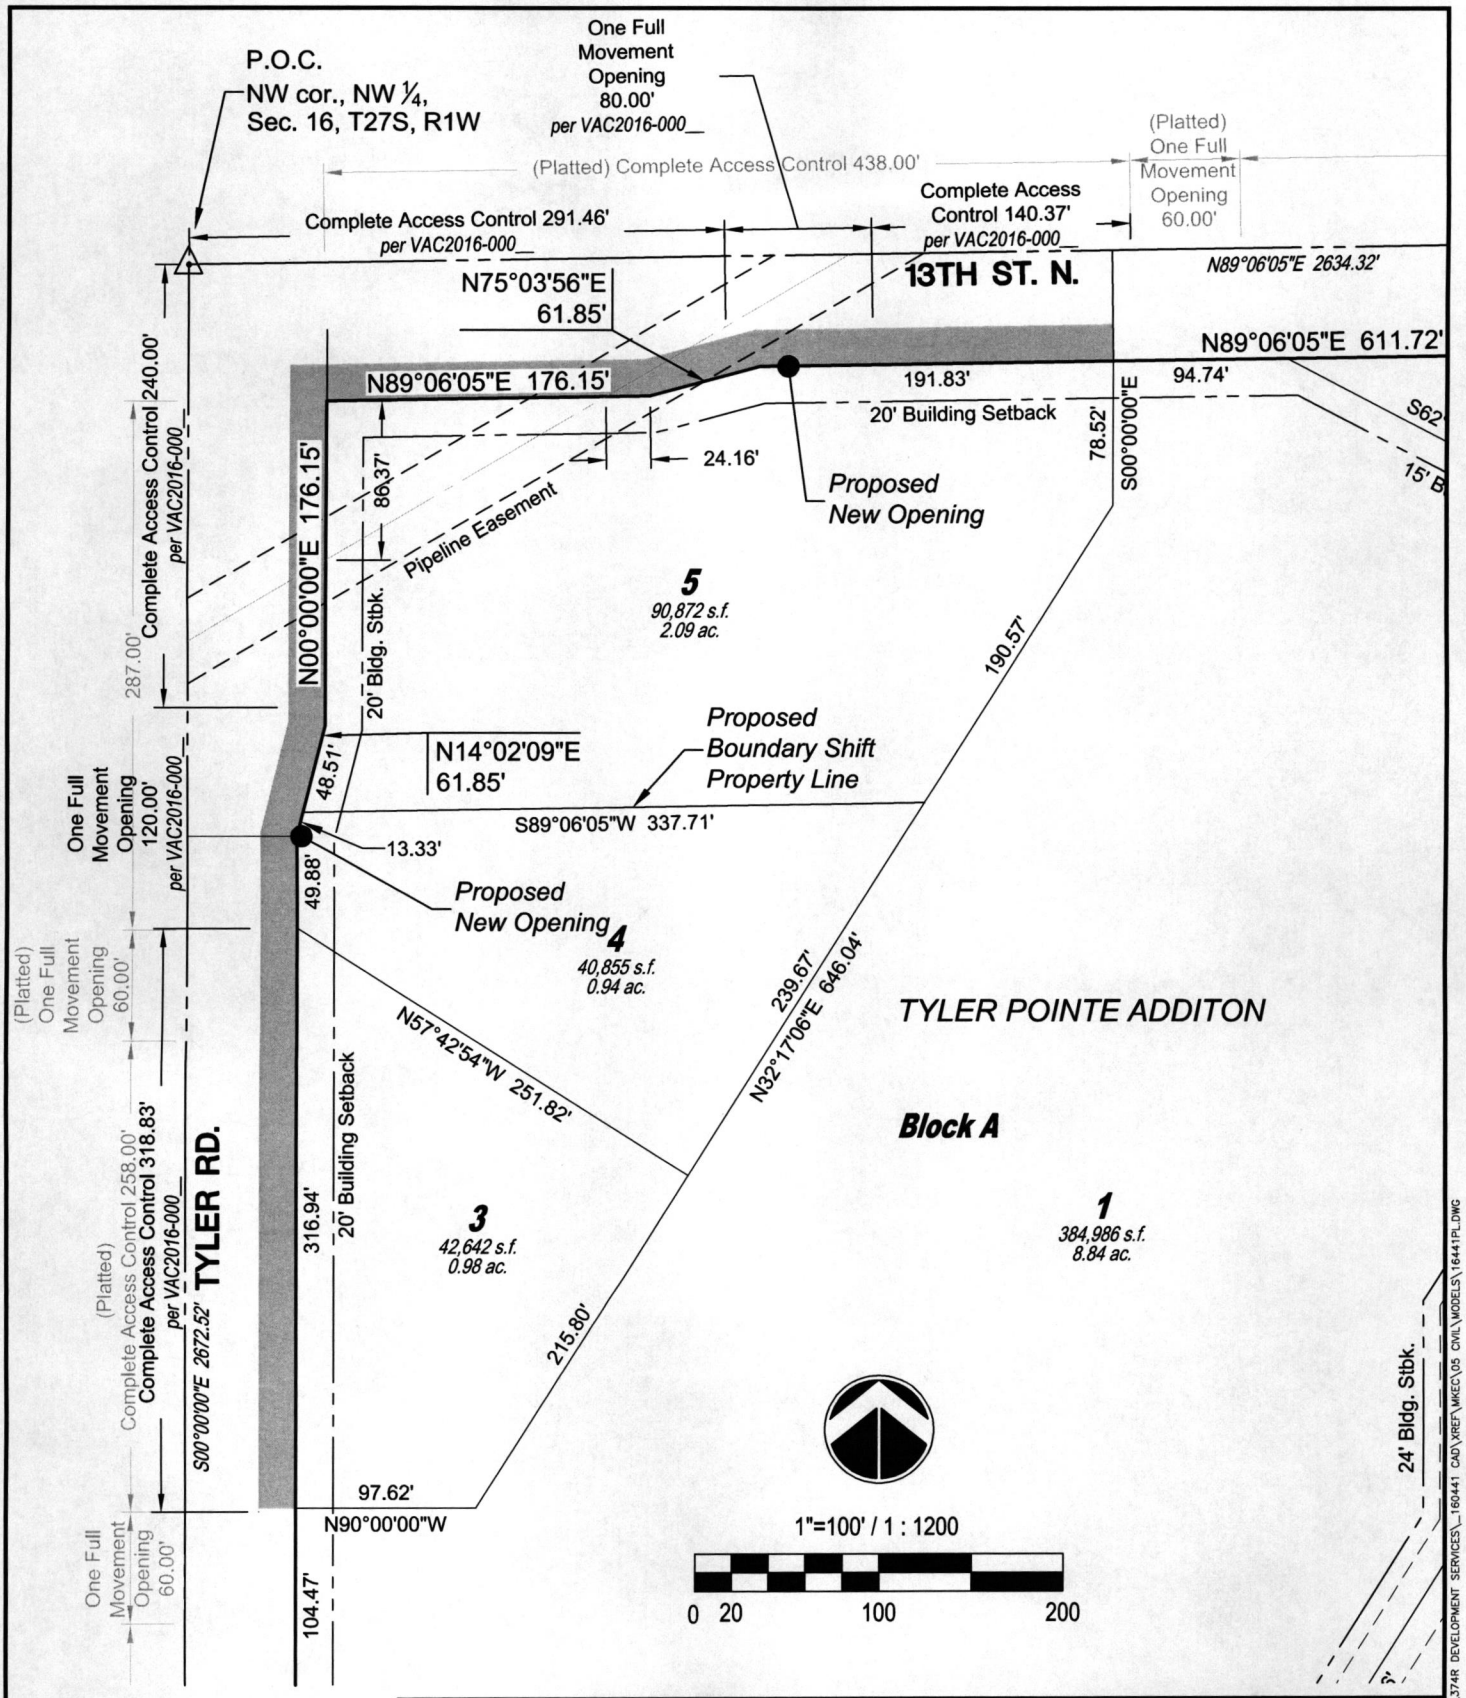

©2016
MKEC Engineering
All Rights Reserved
www.mkec.com
These drawings and their contents, including, but not limited to, all concepts, designs, & ideas are the exclusive property of MKEC Engineering (MKEC), and may not be used or reproduced in any way without the express consent of MKEC.

MKEC
Wichita, KS • 316.684.9600

VACATION CASE EXHIBIT
VAC2016-000__
TYLER POINTE ADDITION

PROJECT NO. 1501010321	DATE: OCTOBER 2015	SHEET NO.
DRAWN BY: JGD	DESIGNED BY: BDL	APPROVED BY: BDL	1 OF 1

J:\PROJECTS\2016\1601010441_OT_374R DEVELOPMENT SERVICES_160441 CAD\XREF\MKEC\05 CIVIL\MODELS\16441PL.DWG