

RIDGE PORT NORTH 4TH ADDITION

WICHITA, SEDGWICK COUNTY, KANSAS

UAC2016-51



- (M) = MEASURED
- (P) = PLATTED
- (C) = CALCULATED
- (D) = DESCRIBED
- (R) = REBAR
- (C-R) = CALCULATED PER REBAR DESCRIPTION
- (C-DEEM) = CALCULATED PER REBAR DESCRIPTION



NOTE:
A DRAINAGE PLAN HAS BEEN DEVELOPED FOR THE COMMERCIAL LOTS AND IS ON FILE WITH THE CITY OF WICHITA, KANSAS. DRAINAGE ADJUSTMENTS SHALL BE MADE AS NECESSARY TO MAINTAIN THE APPROVED FLOW OF THE CITY OF WICHITA, KANSAS. ANY CHANGES TO THE DRAINAGE PLAN SHALL BE APPROVED BY THE CITY ENGINEER OF THE CITY OF WICHITA, KANSAS.

A MASTER DRAINAGE PLAN FOR THE ADDITION HAS BEEN DEVELOPED FOR THE RESERVES AND IS ON FILE WITH THE CITY OF WICHITA, KANSAS. ALL DRAINAGE ADJUSTMENTS, RIGHTS-OF-WAY, OR RESERVES SHALL REMAIN AS ESTABLISHED UNLESS OTHERWISE APPROVED BY THE CITY ENGINEER OF THE CITY OF WICHITA, KANSAS. ANY CHANGES TO THE MASTER DRAINAGE PLAN SHALL BE APPROVED BY THE CITY ENGINEER OF THE CITY OF WICHITA, KANSAS.

BENCHMARK:



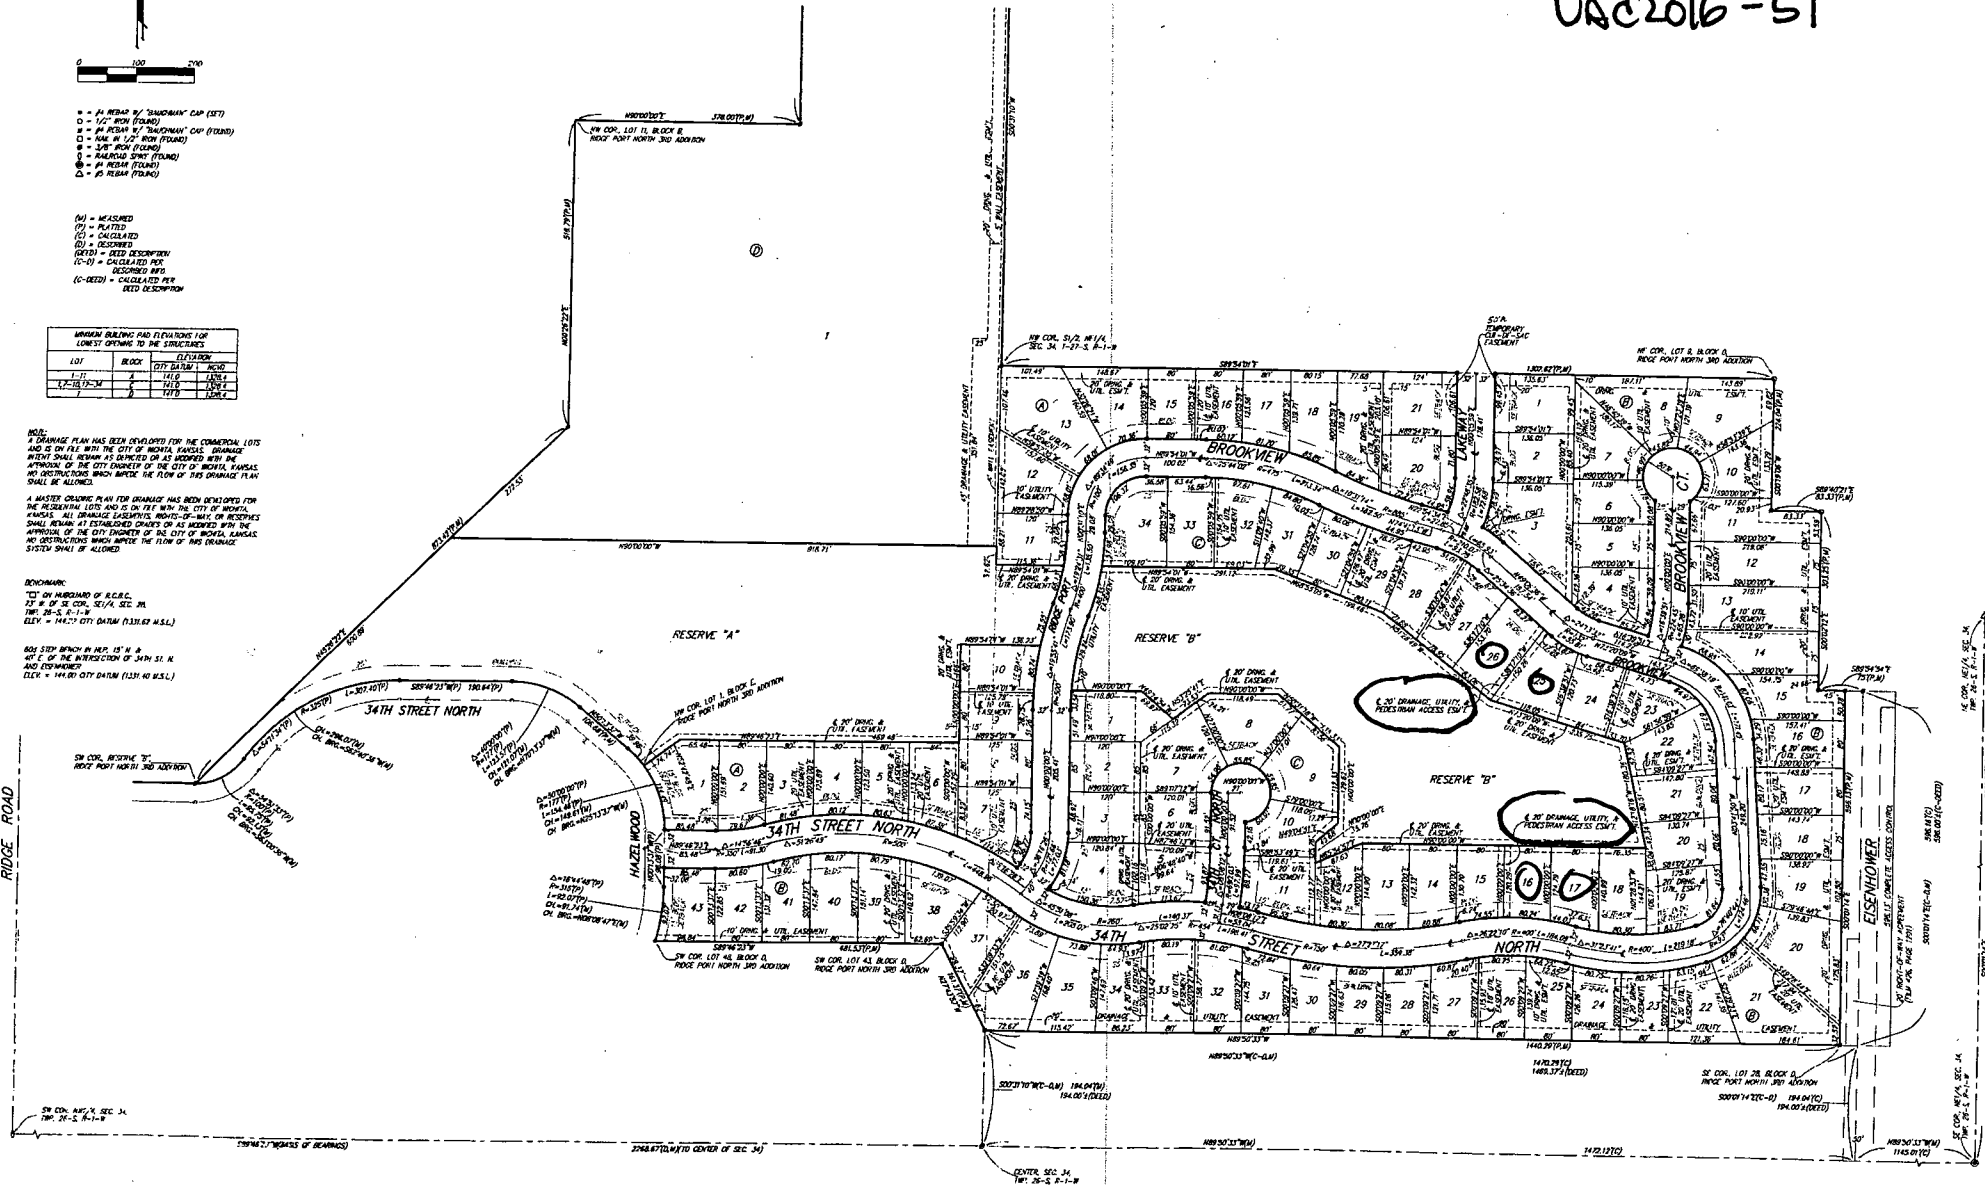

BENCHMARK:
 "C" ON HUBGUARD OF R.C.B.C.,
 73' W. OF SE COR., SE 1/4, SEC. 28,
 TWP. 26-S, R-1-W
 ELEV. = 144.22 CITY DATUM (1331.62 M.S.L.)

600 STEP BENCH IN H.P. 15' N. &
 40' E. OF THE INTERSECTION OF 34TH ST. N
 AND EISENHOWER
 ELEV. = 144.00 CITY DATUM (1331.40 M.S.L.)

VAC2016-51

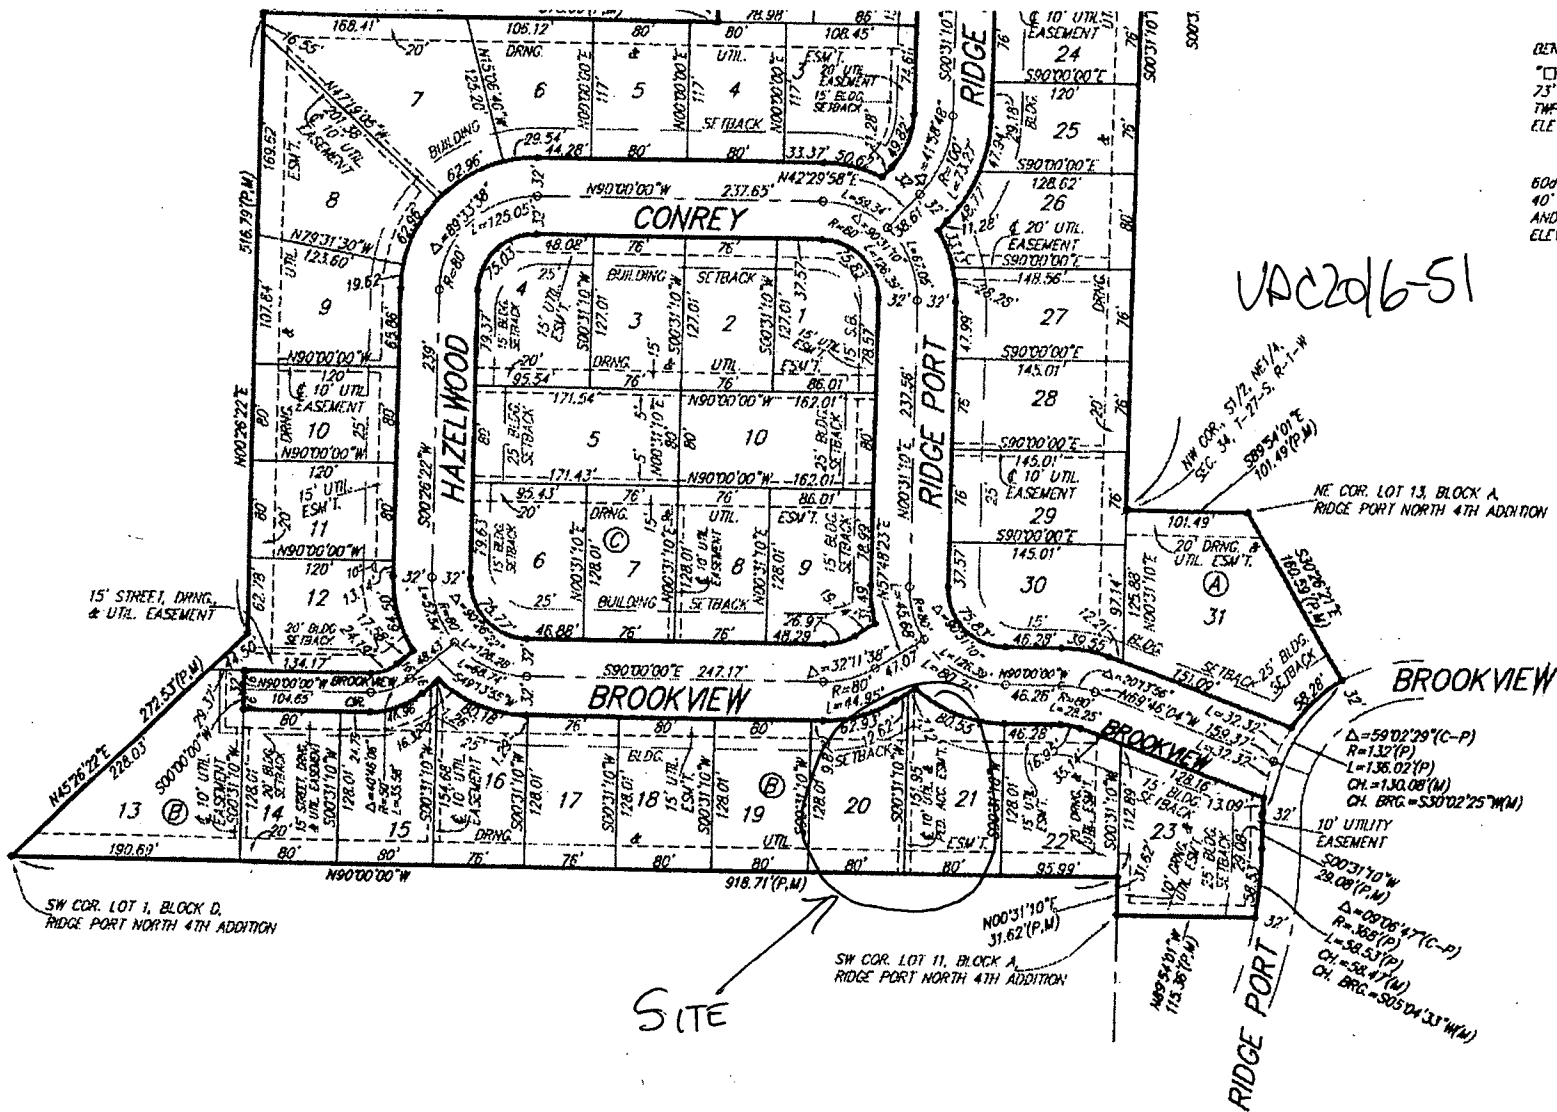

SW COR. LOT 1, BLOCK D,
 RIDGE PORT NORTH 4TH ADDITION

SW COR. LOT 11, BLOCK A,
 RIDGE PORT NORTH 4TH ADDITION

$\Delta = 59^{\circ}02'29''(C-P)$
 $R = 132'(P)$
 $L = 136.02'(P)$
 $CH = 130.08'(M)$
 $CH. BRG. = S50^{\circ}02'25''(M)$

$\Delta = 09^{\circ}06'47''(C-P)$
 $R = 100'(P)$
 $L = 58.53'(P)$
 $CH = 54.41'(M)$
 $CH. BRG. = S05^{\circ}04'33''(M)$

SITE

Ridge Port North 5th Add

NOTE:
 A master grading plan for drainage has been developed for this subdivision and is on file with the City of Wichita, Kansas. All drainage easements, rights-of-way, or reserves shall remain at established grades or as modified with the approval of the City Engineer of the City of Wichita, Kansas. No obstructions which impede the flow of this drainage system shall be allowed.