


EXHIBIT A SITE PLAN

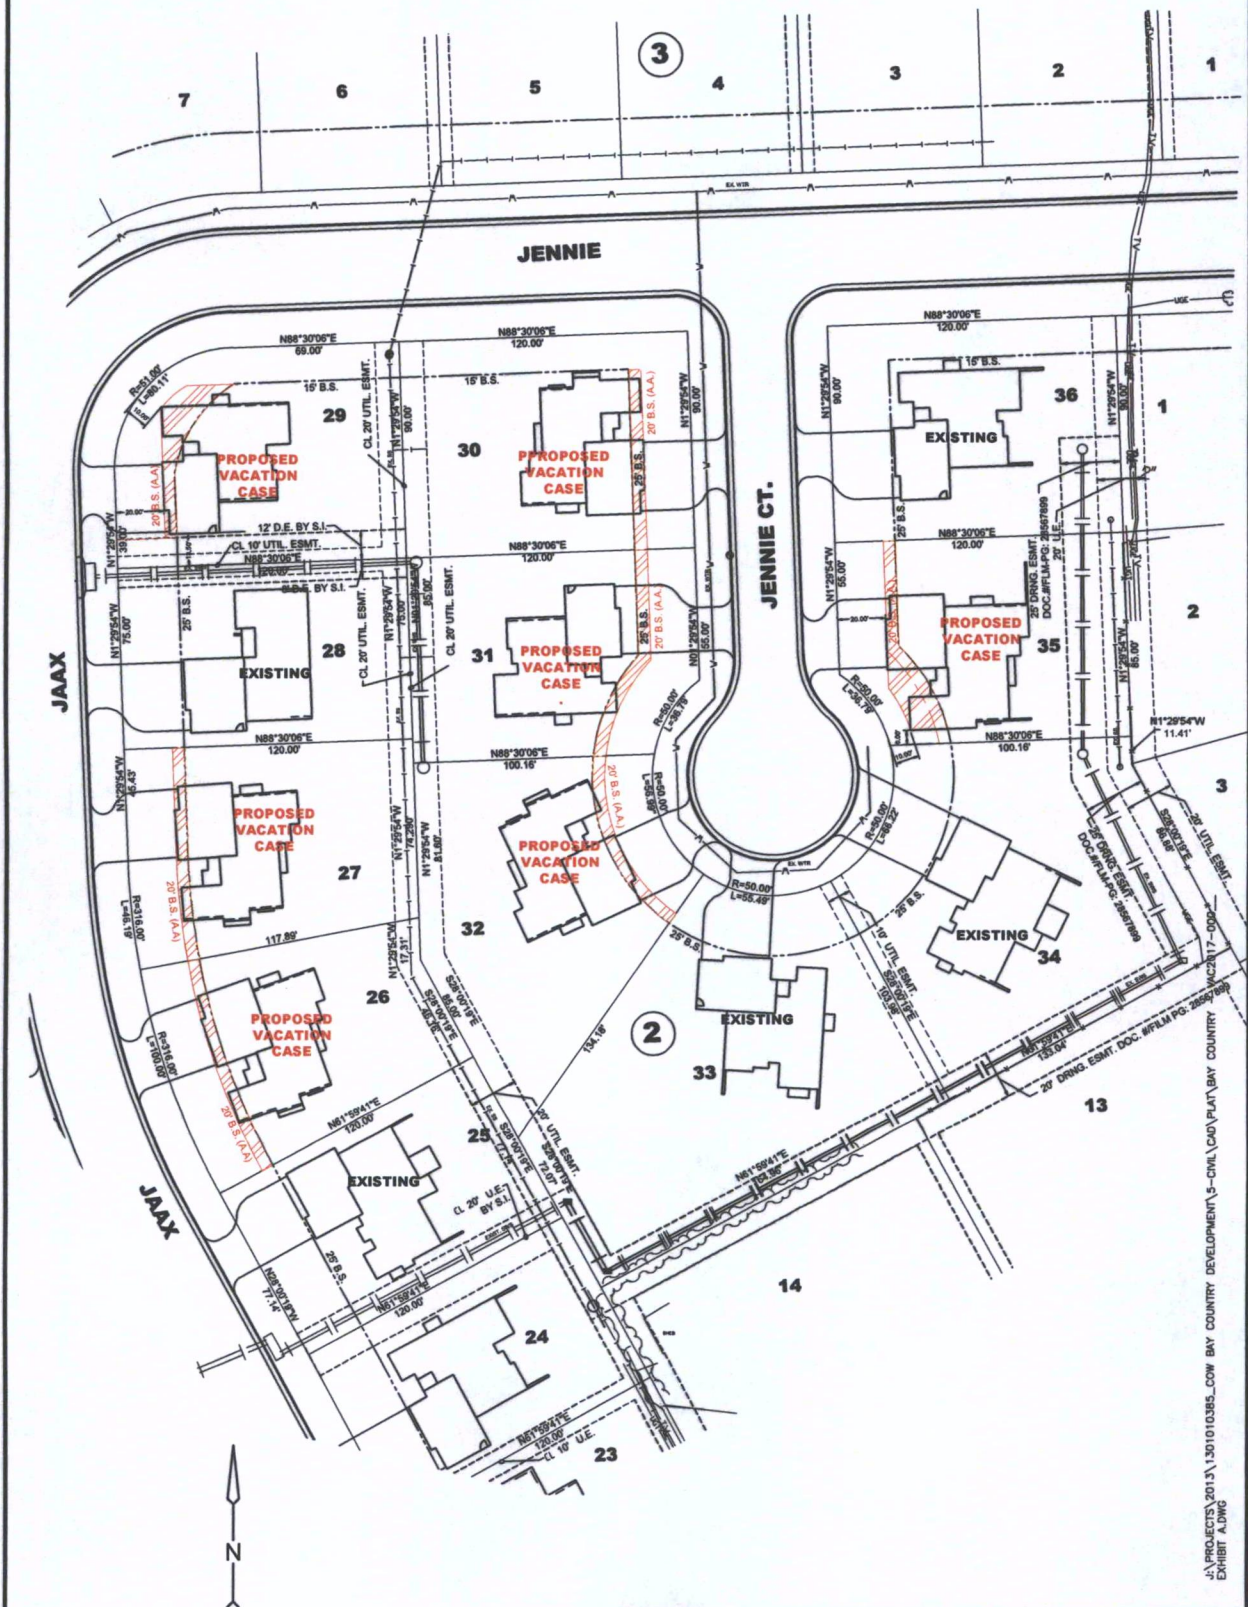

J:\PROJECTS\2011\1301010385L.COM BAY COUNTRY DEVELOPMENT\5-CIVIL\CD\PLAT\BAY COUNTRY EXHIBIT A.DWG

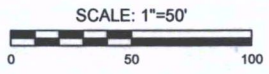


EXHIBIT A
SITE PLAN
BAY COUNTRY, BLOCK 2
LOTS 26, 27, 29, 30, 31, 32 & 35
FRONT YARD SETBACK REDUCTION
BY VACATION CASE