



Baughman
ENGINEERING | SURVEYING | PLANNING
LANDSCAPE ARCHITECTURE

(316)-282-7271 • 315 ELLIS • WICHITA, KANSAS 67211


State of Kansas)
County of Sedgwick) SS

Michaelis Real Estate
May 24, 2011


We, Baughman Company, P.A., Surveyors in aforesaid county and state do hereby certify that, under the supervision of the undersigned, we did on this 24th day of May, 2011, perform a survey of Lots 52, 54, 56, 58, 60, 62, 64, 66, 68, 70, and 72 on Sante Fe in Elliott Addition to Wichita, Kansas, Sedgwick County, Kansas.

The accompanying sketch is a true and correct exhibit of said survey based on actual field measurements where the monuments are of the character and occupy the positions as indicated.

Gregory F. Severns #876

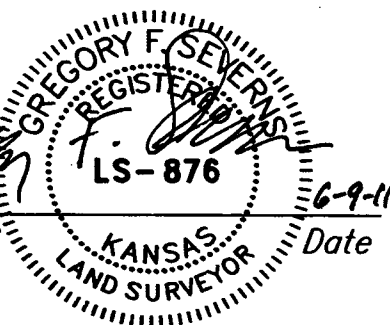


Date

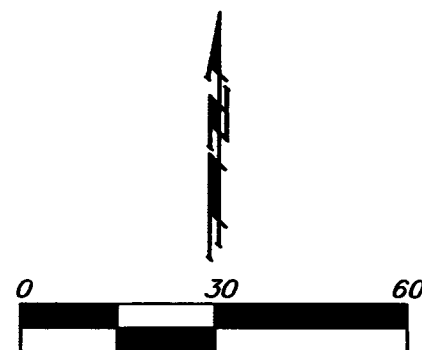

- X = CROSS (SET)
- ⊗ = 1/2" IRON IN THIMBLE (FOUND)
- = 1/2" IRON (FOUND)
- = #4 REBAR W/ "BAUGHMAN" CAP (SET)
- ⊘ = 3/4" IRON (FOUND)
- ⊙ = 1" IRON (FOUND)

- (M) = MEASURED
- (P) = PLATTED
- (CP) = CALCULATED PER PLATTED INFO.
- (CM) = CALCULATED PER MEASURED
- (PRO) = PRORATED

NOTE: Baughman Company, P.A. has not researched any title examination of subject property. An abstract or title insurance company would need to be contacted to research and provide to us any easements, rights-of-ways or dedications.

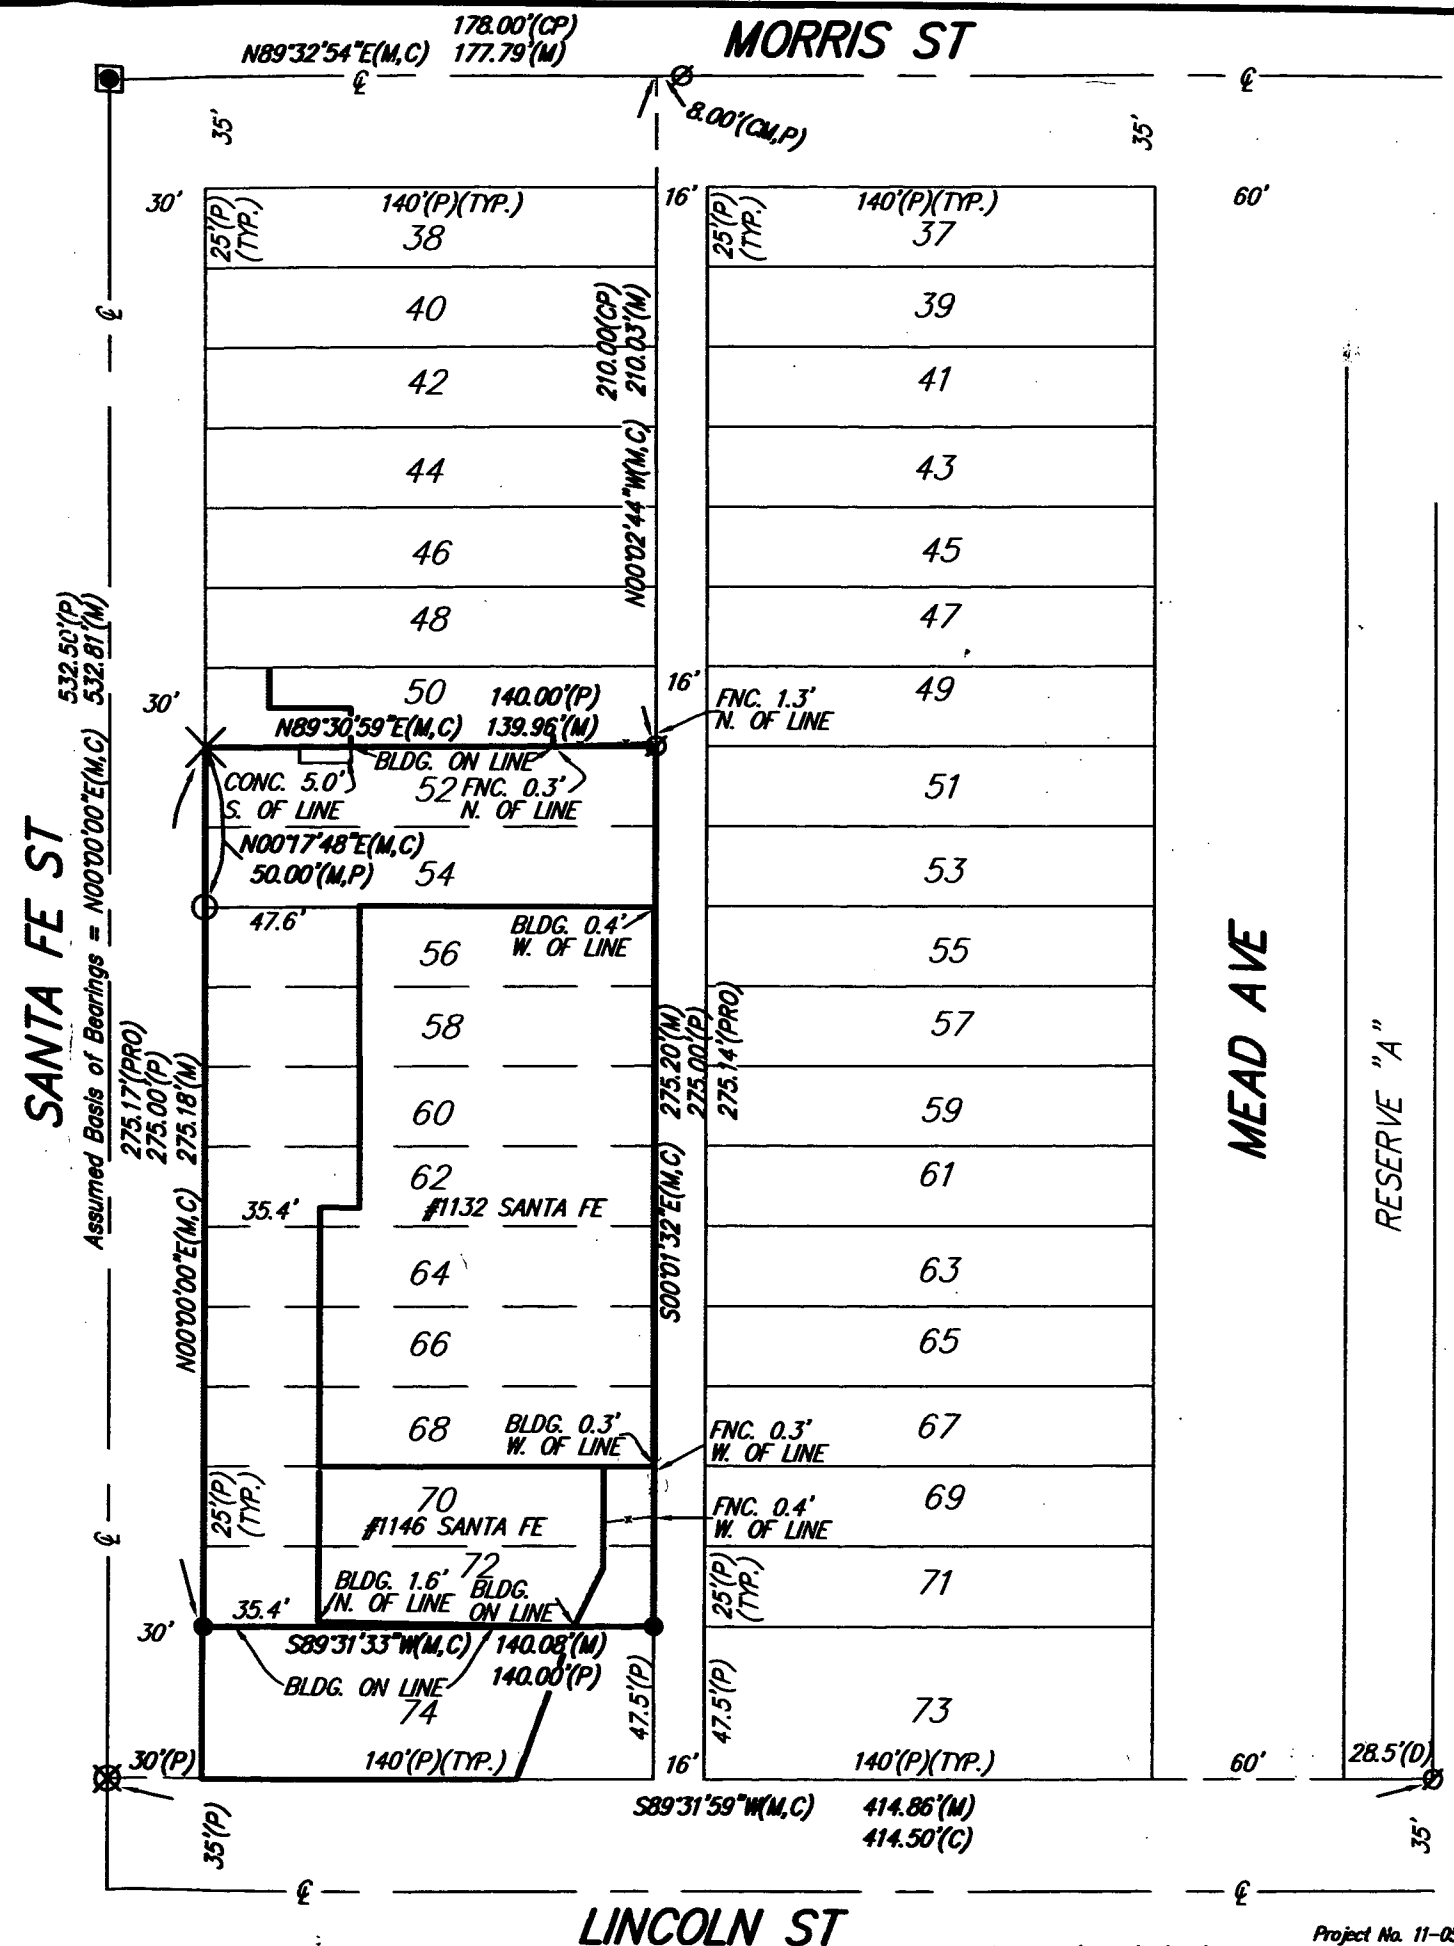

LINCOLN ST