


HYDRAULIC

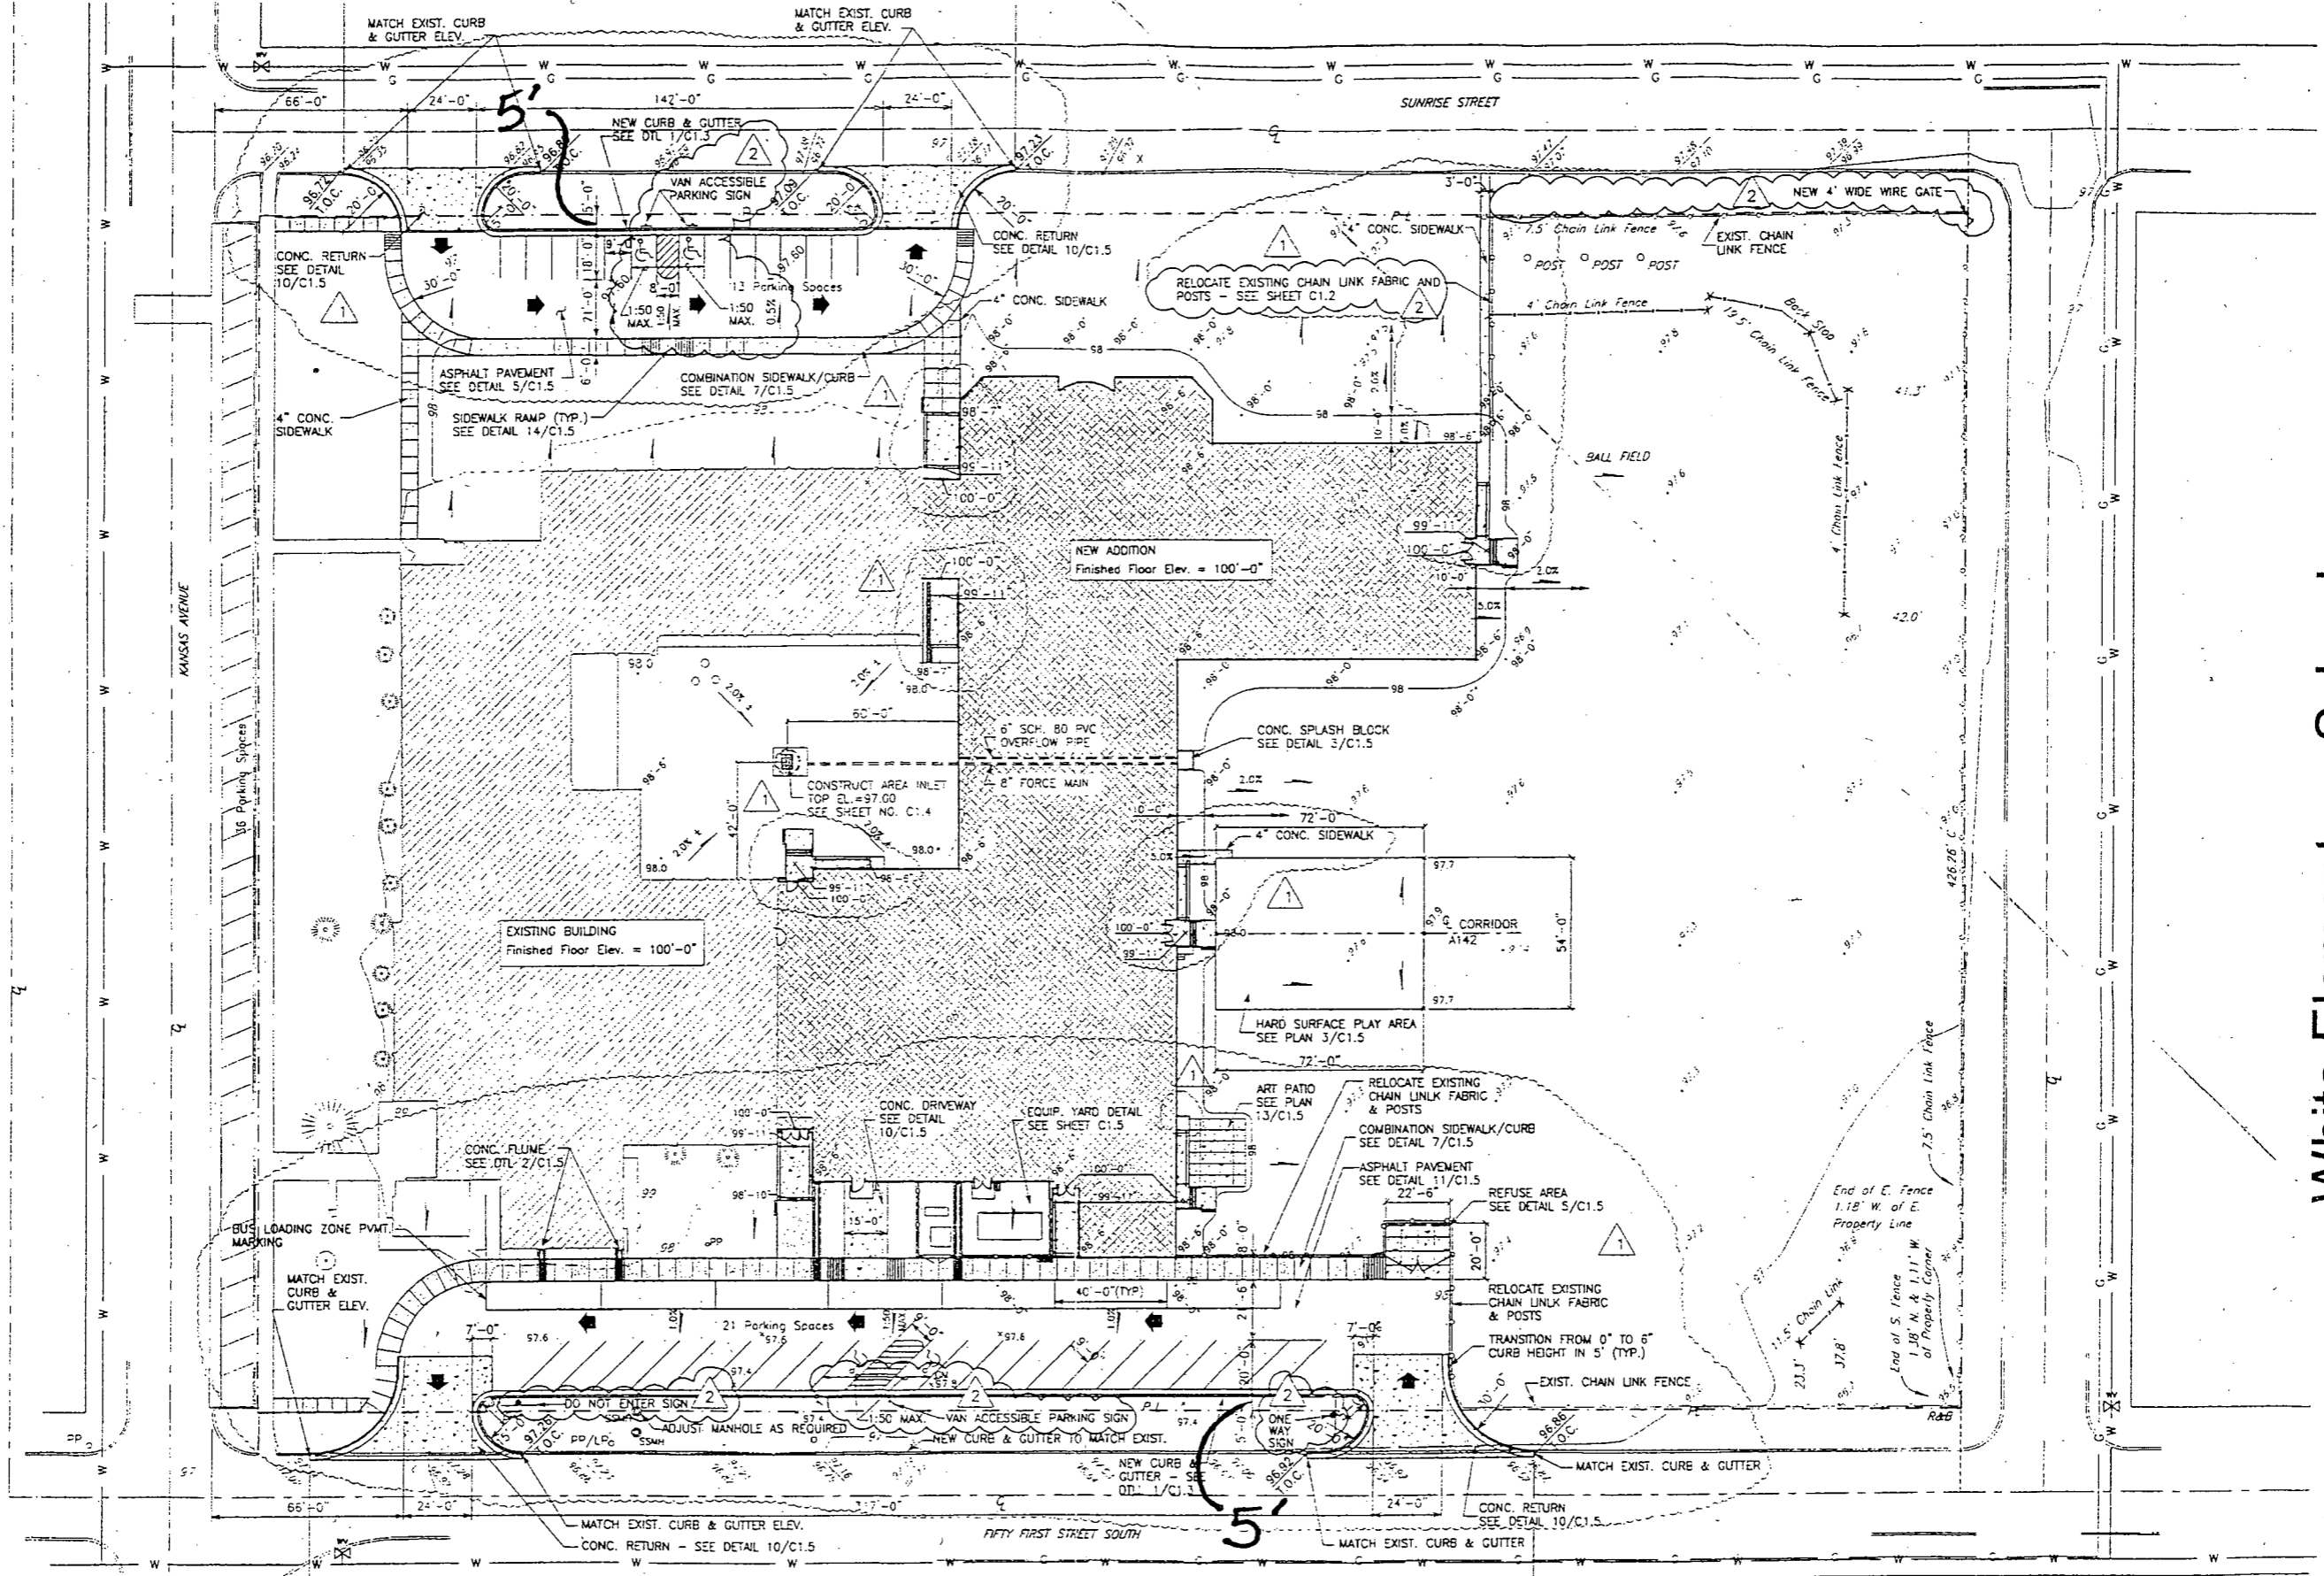

ALTERNATE #1 - ASPHALT DRIVE AND PARKING, CONCRETE RETURNS

SITE PLAN - BUILDING

SCALE: 1"=30'

White Elementary School