



Wichita-Sedgwick County Metropolitan Area Planning Department

September 20, 2019

Camilo & Elida Michel
4316 W. Emerald Bay
Wichita, KS 67205

RE: ZON2019-00028 and CON2019-00025 - City zone change from SF-5 Single-family Residential to TF-3 Two-family Residential and City Conditional Use request for multi-family development within the TF-3 Two-family Residential zoning district, generally located northeast of the intersection of W. Central Avenue and Zoo Boulevard (3320 W. Elm).

Dear Applicants:

At its regular meeting on **September 10, 2019**, the Wichita City Council Planning Commission considered the above captioned request. The action of the Wichita City Council was to **APPROVE** ZON2019-00028 and CON2019-00025, subject to the following conditions:

A. APPROVE the zone change (ZON2019-28) to TF-3 Two-family Residential (TF-3)

B. APPROVE the Conditional Use Request (CON2019-25), subject to the following conditions:

1. The site shall be limited to nine duplexes and 18 total dwelling units.
2. Prior to the issuance of a building permit, a site plan will need to be provided that will determine the location of landscaping, parking, and building setbacks.
3. The site shall be developed in general conformance with the approved site plan.
4. Provide a no protest petition for the Paving of Elm Street, to be recorded with Public Works.
5. Development on the site shall conform to all applicable codes to include zoning, building, landscape, housing, and health codes.
6. If the Zoning Administrator finds that there is a violation of any of the conditions of the Conditional Use, the Zoning Administrator, in addition to enforcing the other remedies set forth in the Unified Zoning Code, may, with the concurrence of the Planning Director, declare that the Conditional Use is null and void.

Please provide a final site plan for approval by the Metropolitan Area Planning Department and a copy of the recorded No Protest Petition for the paving of Elm Street filed with City of Wichita Department of Public Works, Traffic Engineering.

Sincerely,

A handwritten signature in cursive script that reads "Kathy L. Morgan".

Kathy L. Morgan, Senior Planner
Current Plans Division

Copies to: Cindy Claycomb, WCC VI, Mail Stop 1-13
Janet Johnson, Supervisor, Mail Stop 1-135
Jeff Van Zandt, City Law, Mail Stop 1-72
MABCD
Julianne Kallman, City Engineering, Mail Stop 1-71

OCA 150004

PUBLISHED IN THE WICHITA EAGLE ON Sept. 20, 2019

ORDINANCE NO. 51-108

AN ORDINANCE CHANGING THE ZONING CLASSIFICATIONS OR DISTRICTS OF CERTAIN LANDS LOCATED IN THE CITY OF WICHITA, KANSAS, UNDER THE AUTHORITY GRANTED BY THE WICHITA-SEDGWICK COUNTY UNIFIED ZONING CODE, SECTION V-C, AS ADOPTED BY SECTION 28.04.010, AS AMENDED.

BE IT ORDAINED BY THE GOVERNING BODY
OF THE CITY OF WICHITA, KANSAS.

SECTION 1. That having received a recommendation from the Planning Commission, and proper notice having been given and hearing held as provided by law and under authority and subject to the provisions of The Wichita-Sedgwick County Unified Zoning Code, Section V-C, as adopted by Section 28.04.010, as amended, the zoning classification or districts of the lands legally described hereby are changed as follows:

Case No. ZON2019-00028


City zone change from SF-5 Single-Family Residential to TF-3 Two-Family Residential zoning lot described as:

Lots 29 and 30, Davis Gardens Addition, Wichita, Sedgwick County, Kansas.

SECTION 2. That upon the taking effect of this ordinance, the above zoning changes shall be entered and shown on the "Official Zoning Map" previously adopted by reference, and said official zoning map is hereby reincorporated as a part of the Wichita -Sedgwick County Unified Zoning Code as amended.


SECTION 3. That this Ordinance shall take effect and be in force from and after its adoption and publication in the official City paper.

ATTEST:

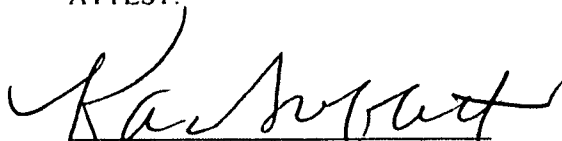


Karen Sublett, City Clerk



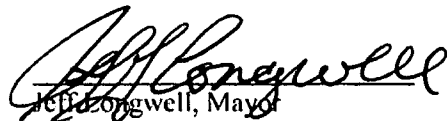

Jeff Longwell, Mayor

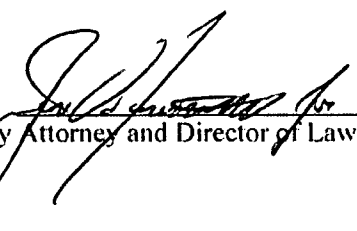Approved as to form: 

Jennifer Magaña, City Attorney and Director of Law

Resolution No. 19- 342

CONDITIONAL USE CON2019-00025

WHEREAS, Camilo and Elida Michel (Owners); pursuant to Section V-D of the Wichita-Sedgwick County Unified Zoning Code (herein referred to as Unified Zoning Code), requests a Conditional Use for multi-family development on 1.37 acres zoned TF-3 Two-family Residential (“TF-3”) described as:

Lots 29 and 30, Davis Gardens Addition, Wichita, Sedgwick County, Kansas. Generally located northeast of the intersection of West Central Avenue and Zoo Boulevard.

WHEREAS, proper notice as required by the Unified Zoning Code and by the policy of the Metropolitan Area Planning Commission (hereinafter referred to as MAPC) has been given; and

WHEREAS, the MAPC did, at the meeting of August 8, 2019, consider said application; and

WHEREAS, the MAPC has authority to permit a Conditional Use, subject to any special conditions deemed appropriate in order to assure full compliance with the criteria of the Unified Zoning Code.

NOW, THEREFORE, BE IT RESOLVED by the Metropolitan Area Planning Commission that this application be approved to allow a Conditional Use for multi-family development on 1.37 acres zoned TF-3 Two-family Residential (“TF-3”) legally described as:


Lots 29 and 30, Davis Gardens Addition, Wichita, Sedgwick County, Kansas

Approved subject to the following conditions:

B. APPROVE the Conditional Use Request (CON2019-25), subject to the following conditions:

1. The site shall be limited to nine duplexes and 18 total dwelling units.
2. Prior to the issuance of a building permit, a site plan shall be provided that will determine the location of landscaping, parking, and building setbacks.
3. The site shall be developed in general conformance with the approved site plan.
4. Provide a no protest petition for the Paving of Elm Street, to be recorded with Public Works.
5. Development on the site shall conform to all applicable codes to include zoning, building, landscape, housing, and health codes.
6. If the Zoning Administrator finds that there is a violation of any of the conditions of the Conditional Use, the Zoning Administrator, in addition to enforcing the other remedies set forth in the Unified Zoning Code, may, with the concurrence of the Planning Director, declare that the Conditional Use is null and void.


Adopted this 10th Day of September 2019

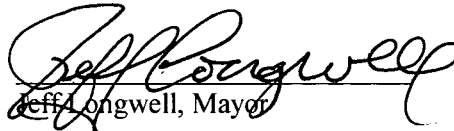
Jeff Longwell, Mayor

ATTEST.


Karen Sublett, City Clerk

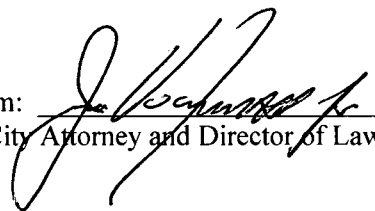

Approved as to form: 
Jennifer Magaña, City Attorney and Director of Law

03

landscape

Preliminary Site Plan
Lots 29 and 30 David Gardens Addition

LEGEND

total of Acres = 1.37

Total of Units = 8

Building Phase = 5.84/Acre

Landscape Area = 17,811 Sq.F.

Existing Zoning = Single Family (SF-5)

proposed zoning = two family (TF-3)

APPROVED



ZON 2019-28 CON 2019-25

SITE PLAN

APPROVED 12-11-84 *R. M. Morgan*

3320 W. Elm

Michel

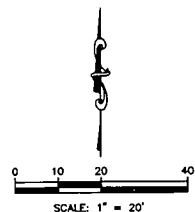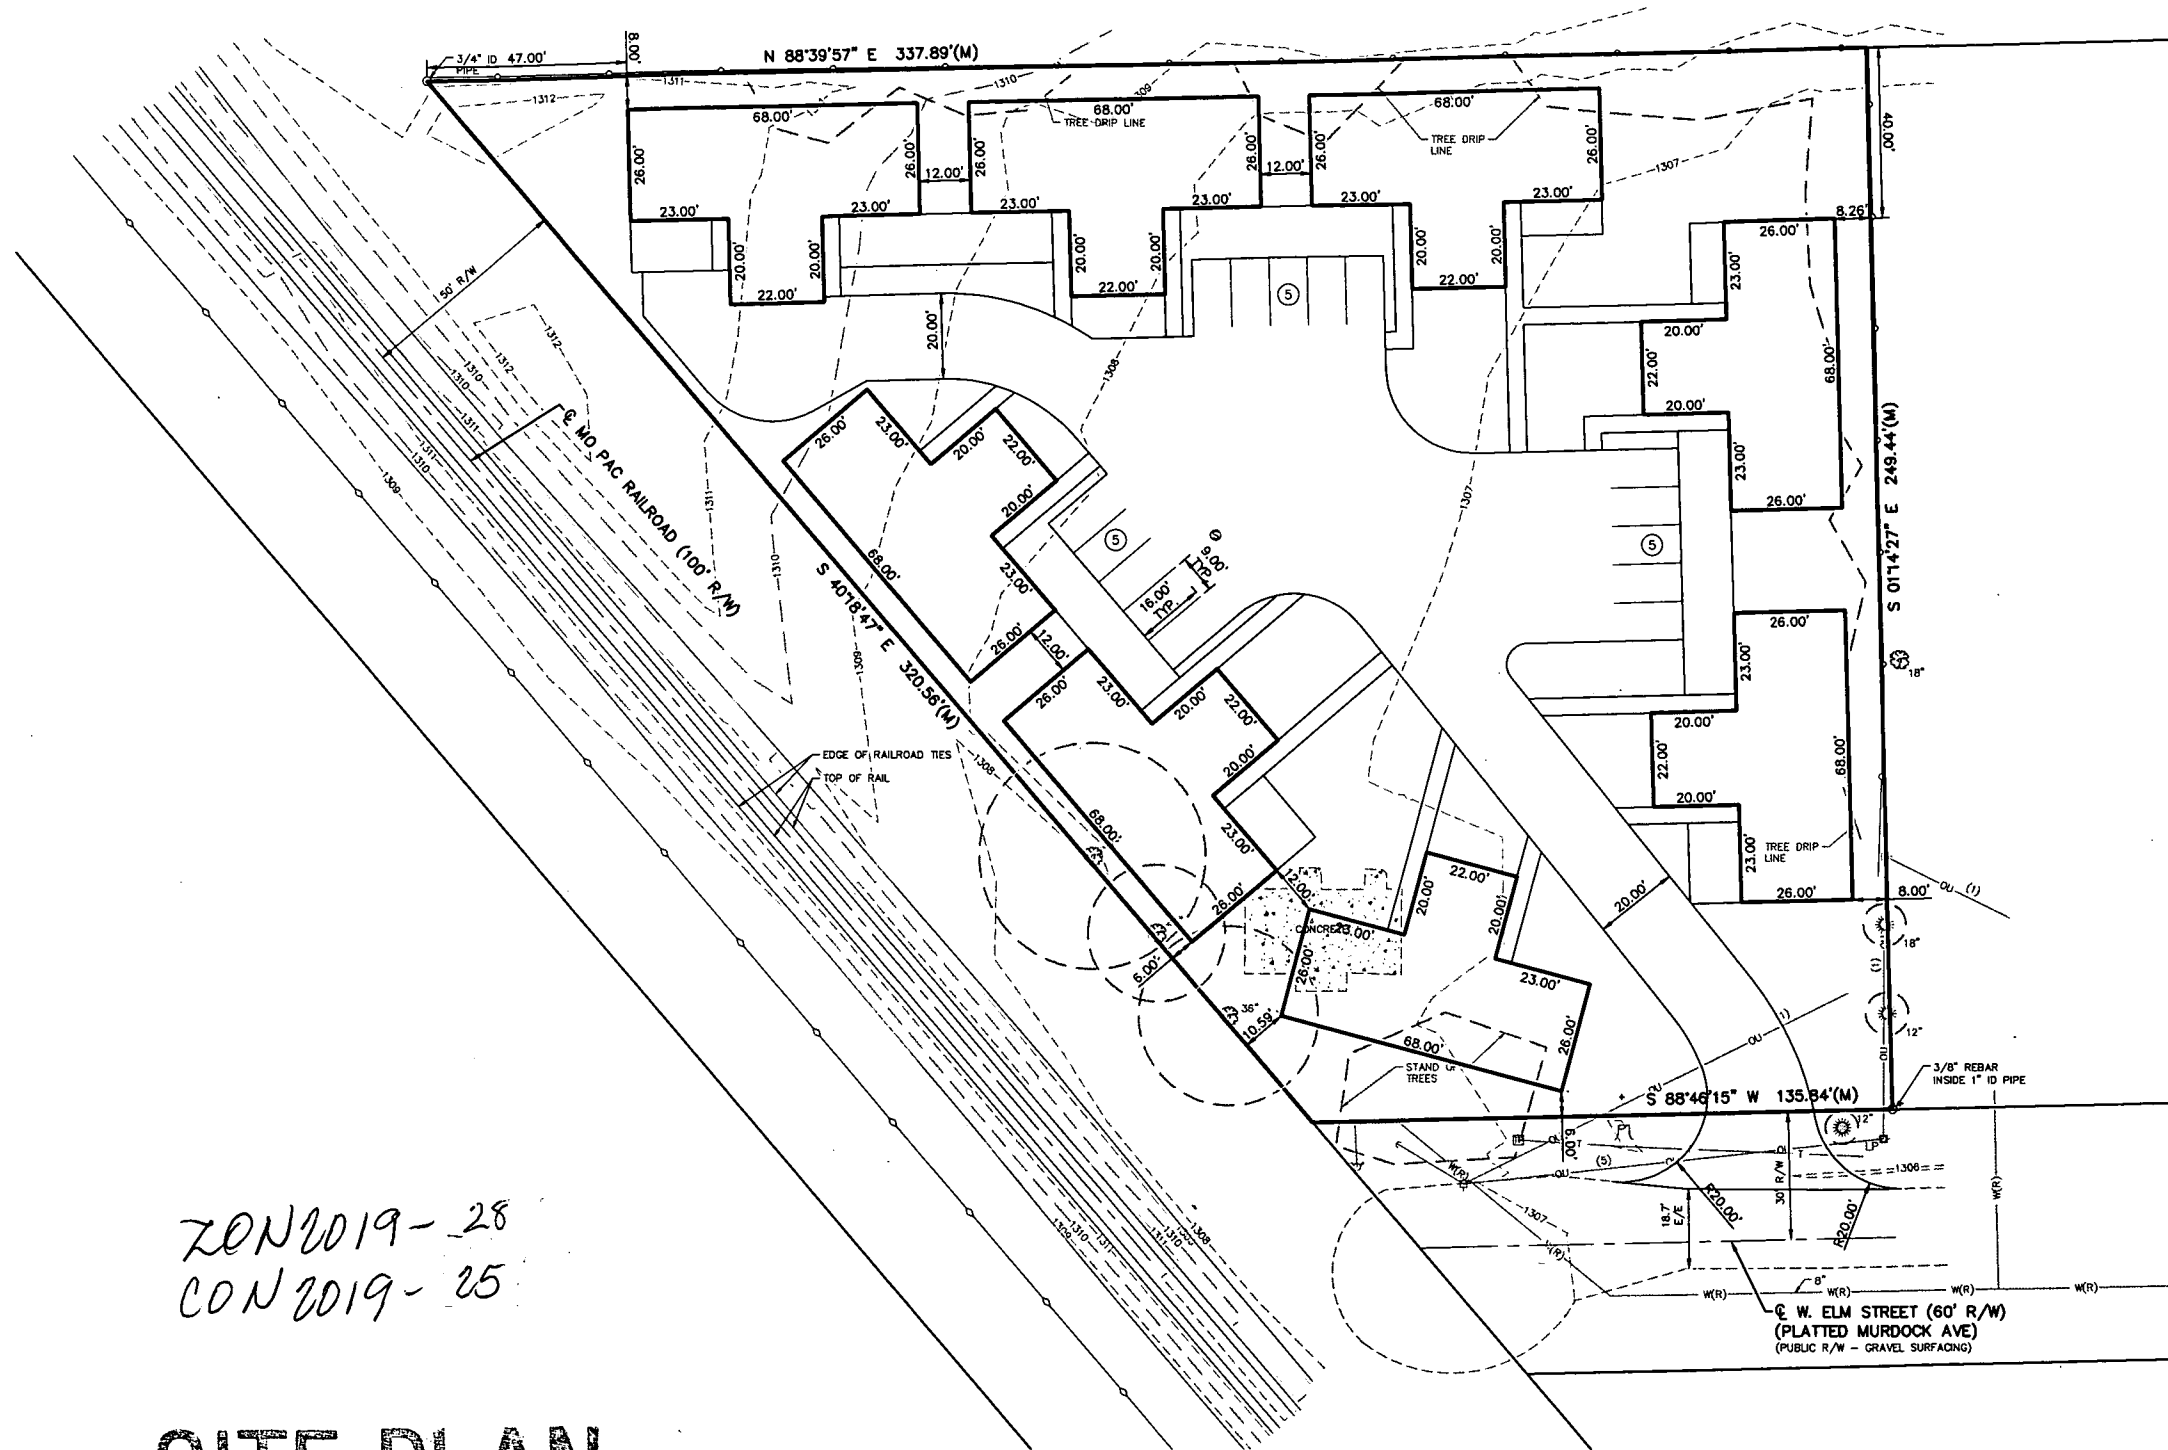

ZON 2019-28
CON 2019-25

SITE PLAN

APPROVED 2/28/2020 *[Signature]*

WEST ELM DUPLEXES 3220 W. ELM WICHITA, KANSAS		SKETCH PLAN	
PROJ. NO.	G20-1351	DESIGNER	HHH
CFN	1351PBASE	DRAWN BY	ST
SHEET	LAYOUT1	REV	
KAW VALLEY ENGINEERING		REV	DATE
2310 N. JACKSON P.O. BOX 1304 JUNCTION CITY, KANSAS 66441 PH. (785) 782-5040 FAX (785) 782-7144 joe@kvweng.com www.kvweng.com		DSN	DWN
		CHK	