



Wichita-Sedgwick County Metropolitan Area Planning Department

October 28, 2020

Barbara Girrens
1001 S. Blackwill Street
Wichita, KS 67207

Wichita Home Works, LLC
Attn: Cody Jessup
4827 S. Fern Circle
Wichita, KS 67217

Re: BZA2020-00053: Administrative Adjustment to reduce the Street Side Setback from 15-feet to 12-feet property zoned SF-5 Single-Family Residential.

Legal Description: Lot 17, Block 4, Sonnybrook 2nd Addition, Wichita, Sedgwick County, Kansas (1001 South Blackwill Street)

Dear Applicant,

We have reviewed your request for a Zoning Adjustment to reduce the Street Side Setback from 15-feet to 12 feet for a detached one-car garage on the aforementioned property. From reviewing the application, we understand that you desire to construct a one-story, detached garage.

Section V-1.2.a of the Unified Zoning Code ("UZC") allows reducing minimum Street (required by the property development standards of the zoning District) by up to 20 percent. This adjustment is permissible when the provisions of the Zoning Adjustment Criteria of Section V-1.6 are met. We find that the reduction of the Street Side Setback for the detached garage as proposed meets the provisions of Section V-1.2.a and the four criteria required by Section V-1.6 as set out below:


- 1) Impact on safety and convenience of vehicular and pedestrian circulation: Reduction of the Street Side Setback from 15-feet to 12-feet will have no impact on the safety and convenience of vehicular and pedestrian circulation in the vicinity as right-of-way and driveways are not affected.
- 2) Impact on existing uses in surrounding areas: There will be no impact on the existing uses in surrounding areas as a result of the building setback reduction. Street visibility will be unchanged for neighboring properties.
- 3) Compatibility with existing or permitted uses on abutting sites: The properties to the north, east south and west are zoned SF-5 and are developed with single-family residences. The setback reduction will not have a negative impact on existing or permitted uses.
- 4) Effect on public health, safety or welfare: There will be no encroachment into public utility easements or rights-of-way. There will be no negative impact on the public health, safety or welfare, nor will properties or improvements in the vicinity be materially injured.

Our signatures below indicate that a Zoning Adjustment to reduce the Street Side Setback from 15-feet to


12-feet is hereby **GRANTED** for the aforementioned property, subject to the following conditions:

- 1) The Street Side Setback reduction shall apply only to the location of the detached garage as illustrated on the approved site plan. All other structures or additions on the subject property shall conform to the setbacks permitted by the Unified Zoning Code unless a separate Zoning Adjustment or Variance is granted.
- 2) If the Zoning Administrator finds that there is a violation of any of the conditions of the Zoning Adjustment, the Zoning Administrator, in addition to enforcing the other remedies set forth in the Unified Zoning Code, may, with the concurrence of the Planning Director, declare that the Zoning Adjustment is null and void.

The "Development Application" sign should now be removed from the property.

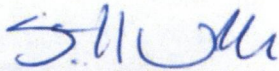


Scott Wadle, Director
Metropolitan Area Planning Department

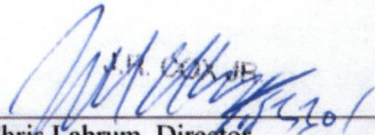

Chris Labrum, Director
Metropolitan Area Building and Construction
Department

cc: MABCD
Becky Tuttle, CM District II
Cory Buchta, Community Service Representative, District II

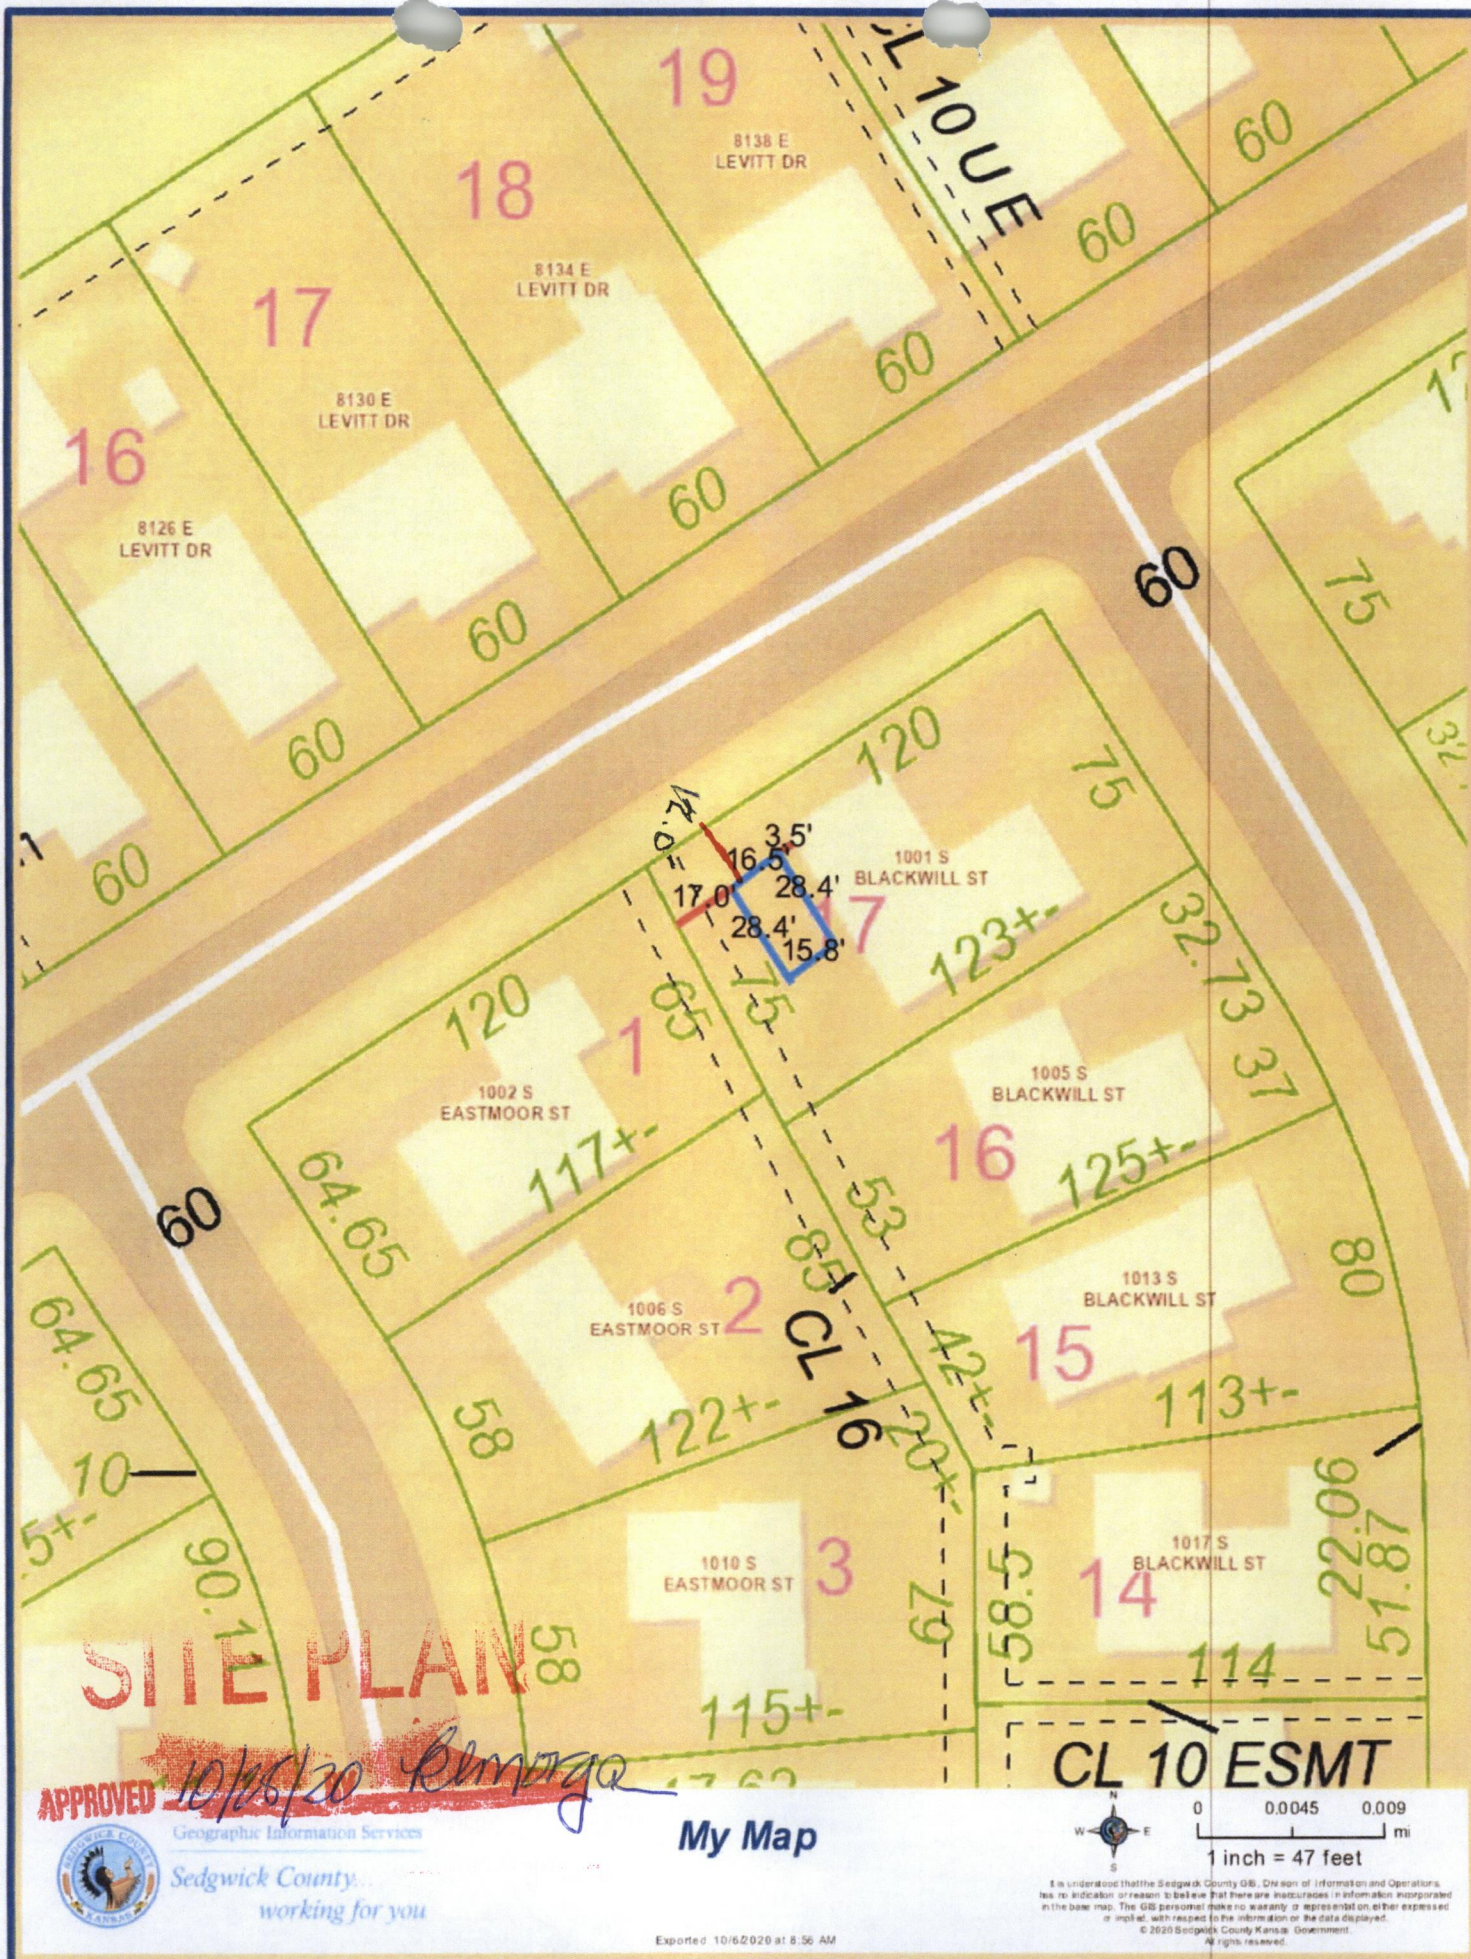


SITE PLAN

APPROVED 10/26/20 *R. Mingo*



Geographic Information Services
Sedgwick County
working for you

My Map

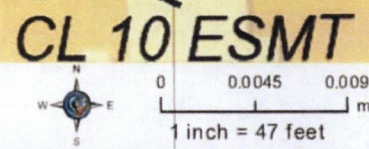

It is understood that the Sedgwick County GIS, Division of Information and Operations, has no indication or reason to believe that there are inaccuracies in information incorporated in the base map. The GIS personnel make no warranty or representation on either expressed or implied, with respect to the information or the data displayed.
© 2020 Sedgwick County Kansas Government.
All rights reserved.