



Wichita-Sedgwick County Metropolitan Area Planning Department

October 26, 2020

Richard Noel
3254 South Fern Avenue
Wichita, KS 67217

Re: BZA2020-00054: Administrative Adjustment to reduce the Interior Side Setback from 6-feet to 4-feet 8-inches on the north property line to build a new carport on property zoned SF-5 Single-Family Residential.

Legal Description: Lot 5, Block 2, Carlans Addition, Wichita, Sedgwick County, Kansas (3254 S. Fern Avenue)

Dear Applicants,

We have reviewed your request for a Zoning Adjustment to reduce the Interior Side Setback from 6-feet to 4-feet 8-inches on the north property line to build a new carport on property zoned SF-5 Single-Family Residential.

Section V-1.2.a of the Unified Zoning Code ("UZC") allows the reduction of the Interior Side Setback up to 20%. This adjustment is permissible when the provisions of the Zoning Adjustment Criteria of Section V-1.6 are met. We find that the Interior Side Setback reduction from 6-feet to 4-feet 8-inches meets the provisions of Section V-1.2.a and the four criteria required by Section V-1.6 as set out below:

- 1) Impact on safety and convenience of vehicular and pedestrian circulation: Reduction of the Interior Side Setback will have no impact on the safety and convenience of vehicular and pedestrian circulation in the vicinity as right-of-way and driveways are not affected.
- 2) Impact on existing uses in surrounding areas: There will be no impact on the existing uses in surrounding areas as a result of these changes. Street visibility will be unchanged for neighboring properties.
- 3) Compatibility with existing or permitted uses on abutting sites: The properties to the north, south, east, and west are zoned SF-5 and are developed with single-family residences.
- 4) Effect on public health, safety or welfare: There will be no encroachment into public utility easements or rights-of-way. There will be no negative impact on the public health, safety or welfare, nor will properties or improvements in the vicinity be materially injured.


Our signatures below indicate that a Zoning Adjustment to reduce the Interior Side Setback from 6-feet to 4-feet 8-inches on the north property line to build a new carport on the aforementioned property is hereby **GRANTED**, subject to the following conditions:

- 1) Reduction of the Interior Side Setback from 6-feet to 4-feet 8-inches on the north property line is


granted. All other structures or additions on the subject property shall conform to the setbacks permitted by the Unified Zoning Code unless a separate Zoning Adjustment or Variance is granted.

- 2) The applicant shall obtain a building permit and complete construction within one year of the Administrative Adjustment approval. The site shall conform to all codes including but not limited to building, health and fire.
- 3) If the Zoning Administrator finds that there is a violation of any of the conditions of the Zoning Adjustment, the Zoning Administrator, in addition to enforcing the other remedies set forth in the Unified Zoning Code, may, with the concurrence of the Planning Director, declare that the Zoning Adjustment is null and void.

The "Development Application" sign should now be removed from the property.

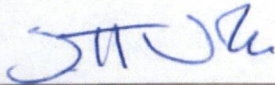


Scott Wadle, Director
Metropolitan Area Planning Department

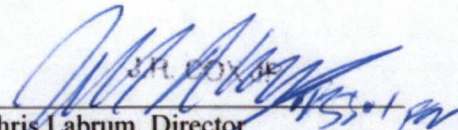


Chris Labrum, Director
Metropolitan Area Building and Construction
Department

cc: MABCD
Jeff Blubaugh, CM District IV
Rebecca Fields, Community Service Representative, District IV

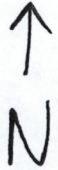

Car Port is 12' x 30'

SOUTH
FERN
STREET

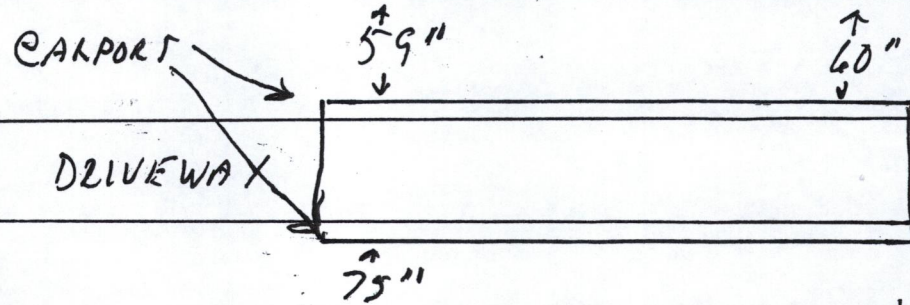

HOUSE

3254

S. FERN ST.

WICHITA, KS 67217

SITE PLAN

APPROVED 10/26/20 BY *[Signature]*