12000	10400
7750	6460
3500	3076
1200	500
640	7360
640	27,796 sq ft. of parking space
640	
640	
640	
640	
69930 sq ft.	
12,000 sq ft.	
57,930	

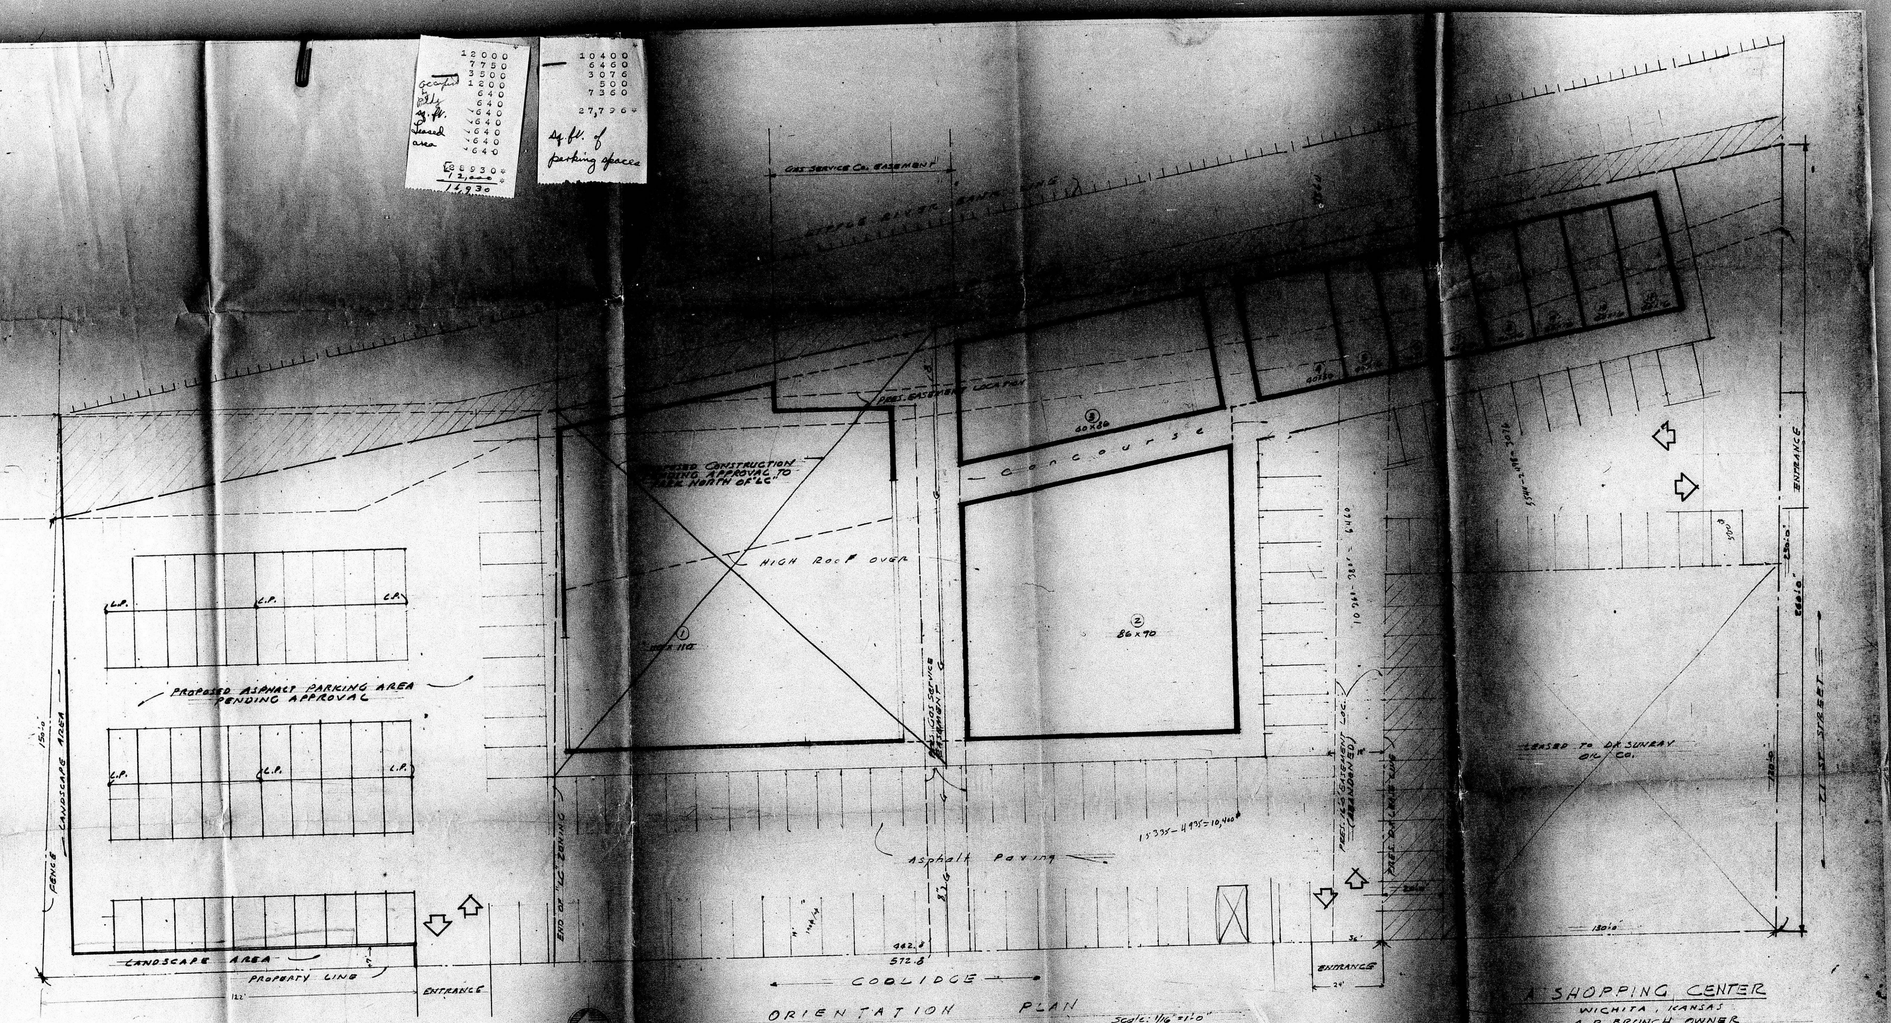

MARKET	12,000 SF	7 CLEANERS	600 SF	GROSS LAND AREA	
	7,750 SF	8 DOCTOR	600 SF	GROSS LEASE AREA	
	3500 SF	9 DENTIST	600 SF	PARKING & TRAFFIC	
	1200 SF	10 HAMBURGER	600 SF	RATIO - BLDG. TO TRAFFIC	
WEAR	640 SF	11 LIQUOR	600 SF	Parking only	
- BEAUTY	600 SF			Total Bldg area	
				Exclusive #1	

A SHOPPING CENTER
WICHITA, KANSAS
A R BRUNCH OWNER

WARREN A. MILLER
ASSOCIATES
ARCHITECTS
WICHITA KANSAS

FILMED FROM THE BEST AVAILABLE COPY