
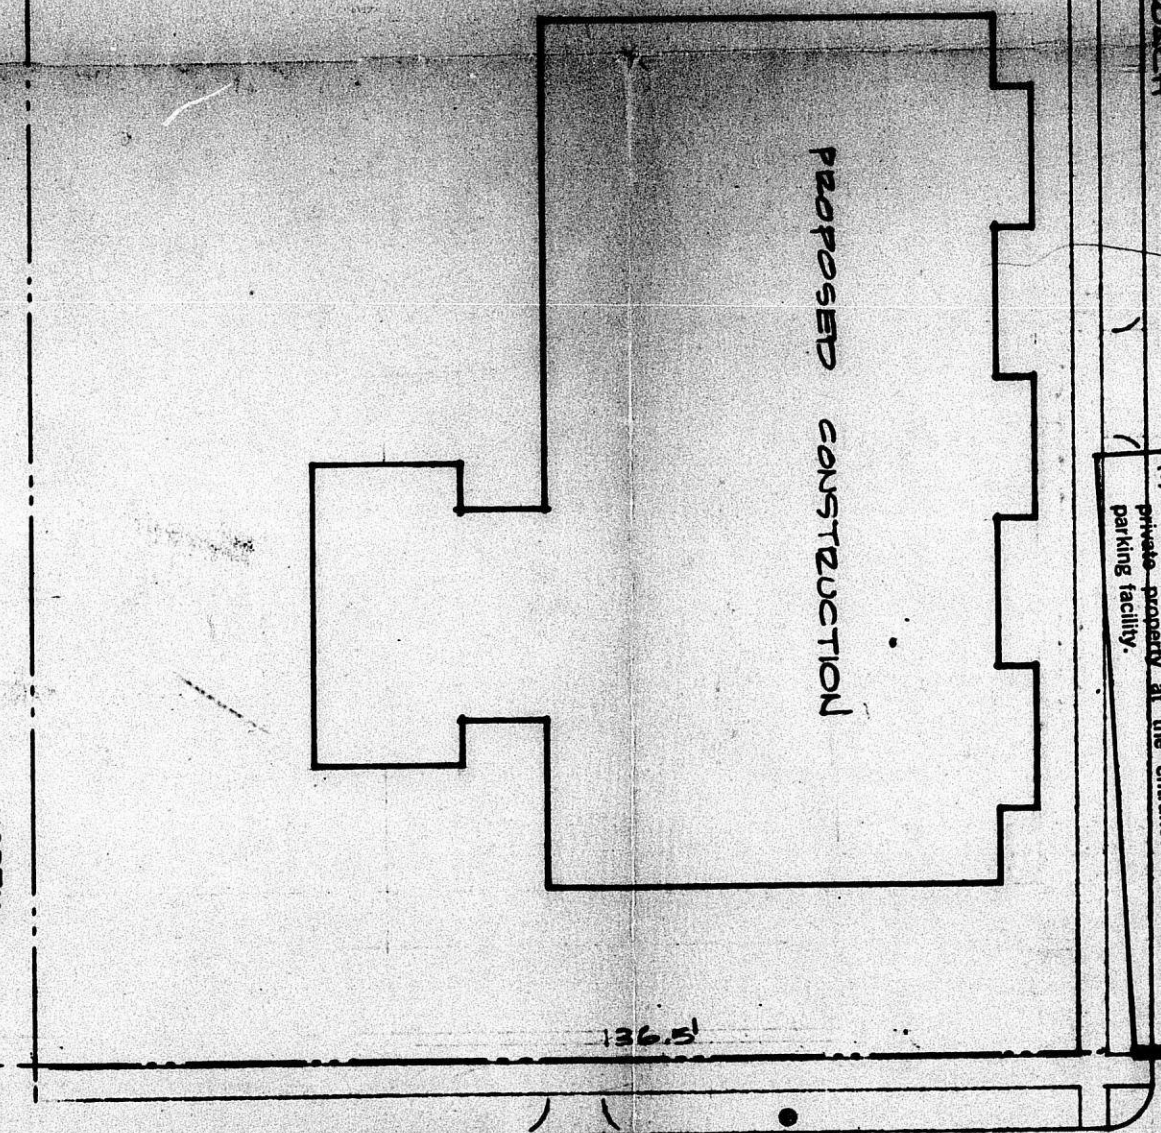


Prop. alley for ingress and egress to Bancroft back out

SITE PLAN
SCALE: 1" = 20'

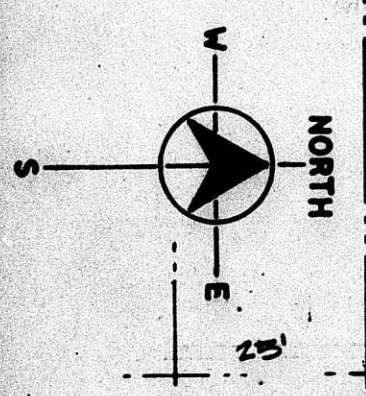

TRAFFIC-ENGINEERING DIVISION APPROVED
Date: 2-27-70
1/27/70
(A) Parking barriers shall be installed at all locations adjacent to public ways and shall have a minimum height of 42" and a minimum cross section of 4" x 4".
(B) Stall lines shall be painted and 4" or greater in width.
(C) Proper ingress and egress signs shall be installed and placed conspicuously at the entrance and exit of the parking facility.

EXISTING APPROACH
8 TH STREET

NORTH HILLSIDE


SUPERSEDED

02-5-1229

of 1 sheet
 MEDICAL CLINIC
 8 TH HILLSIDE
 WICHITA

FILMED FROM THE BEST AVAILABLE COPY



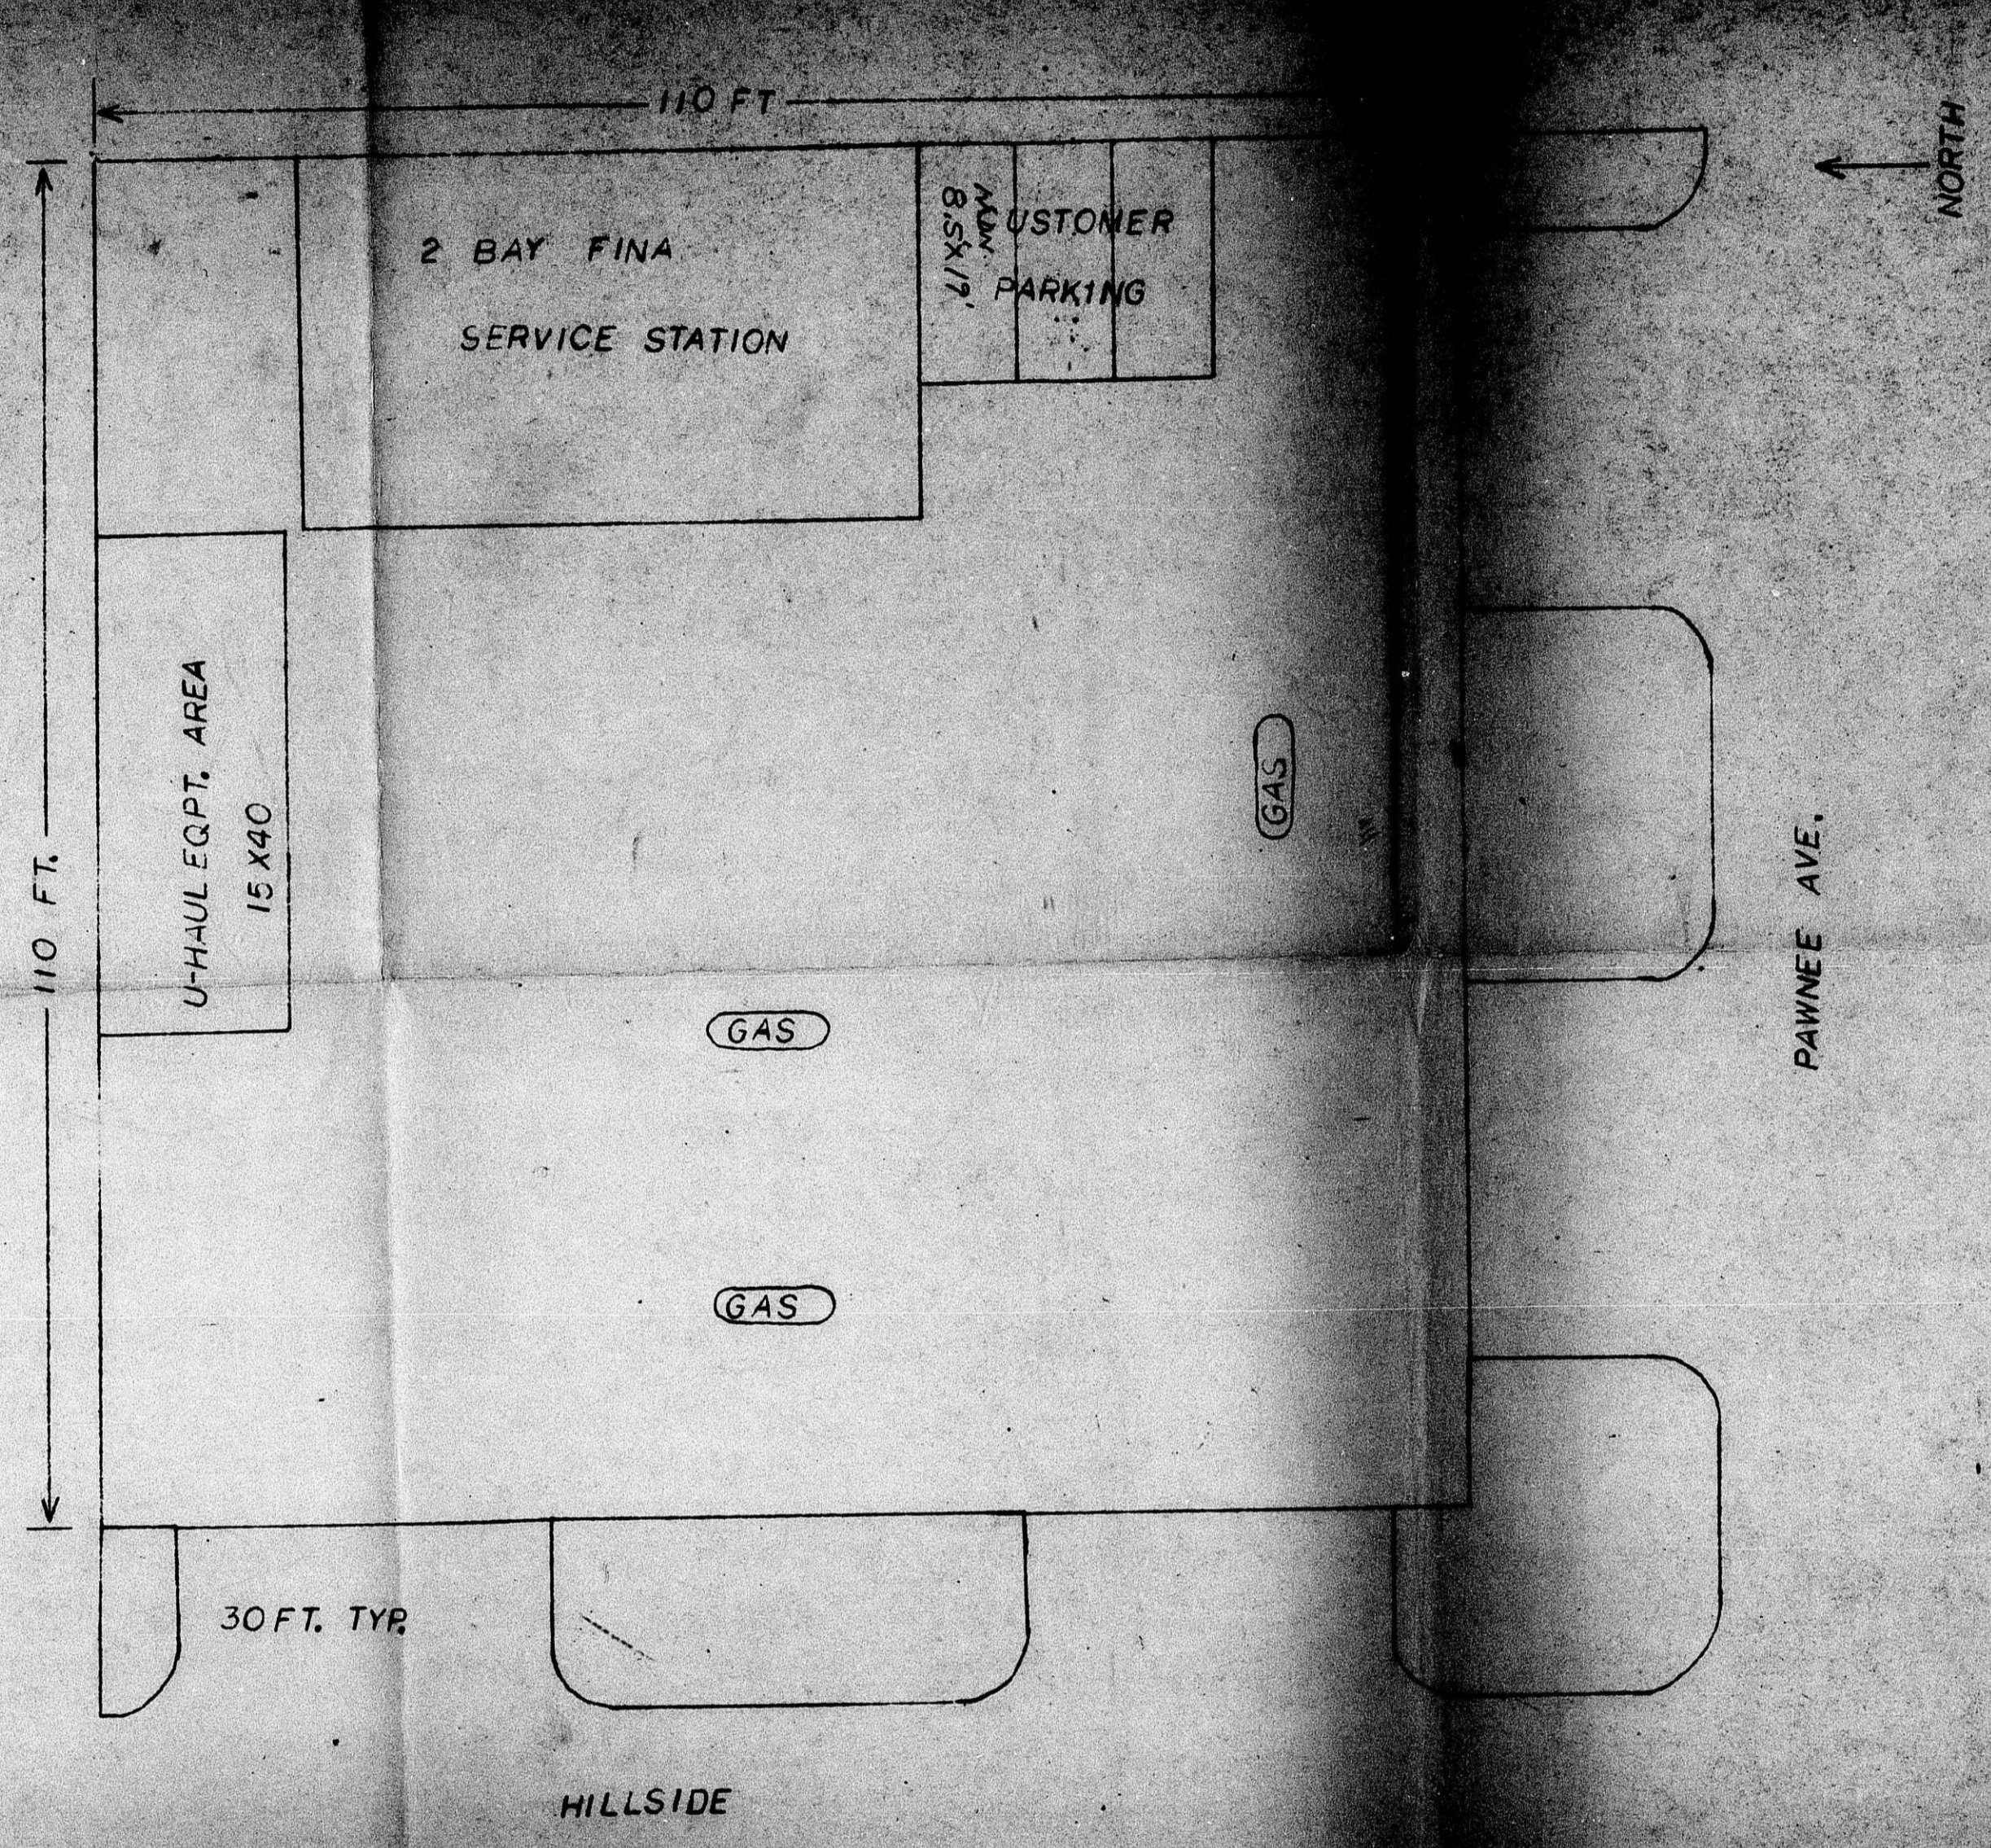

NOTES:
 ALL DRIVEWAYS 30 FT.
 SCALE - 1" = 10 FT.