


SITE AND FLOOR PLAN  
SCALE: 1" = 20'-0"

*Entry Marked  
Ch. R. BZA  
1-18-88*

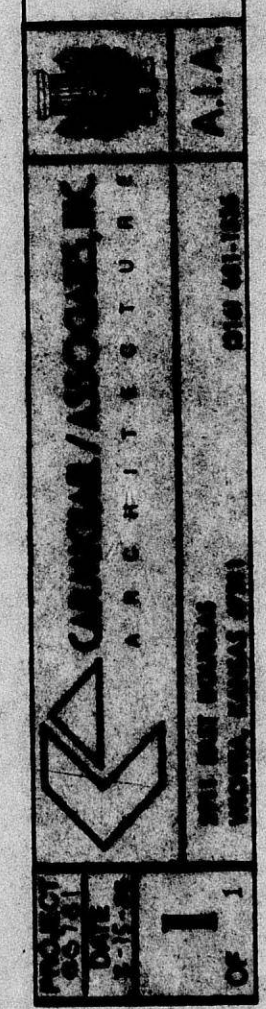

GRACE PRESBYTERIAN CHURCH PRE-SCHOOL  
BLECKLEY DRIVE & EAST DOUGLAS AVE.  
WICHITA, KANSAS

BZA 10-88