



PANTEE RANCH ADDITION
WICHITA KANSAS
COMMERCIAL AREA

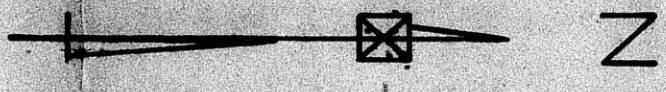

Scale 1" = 30'

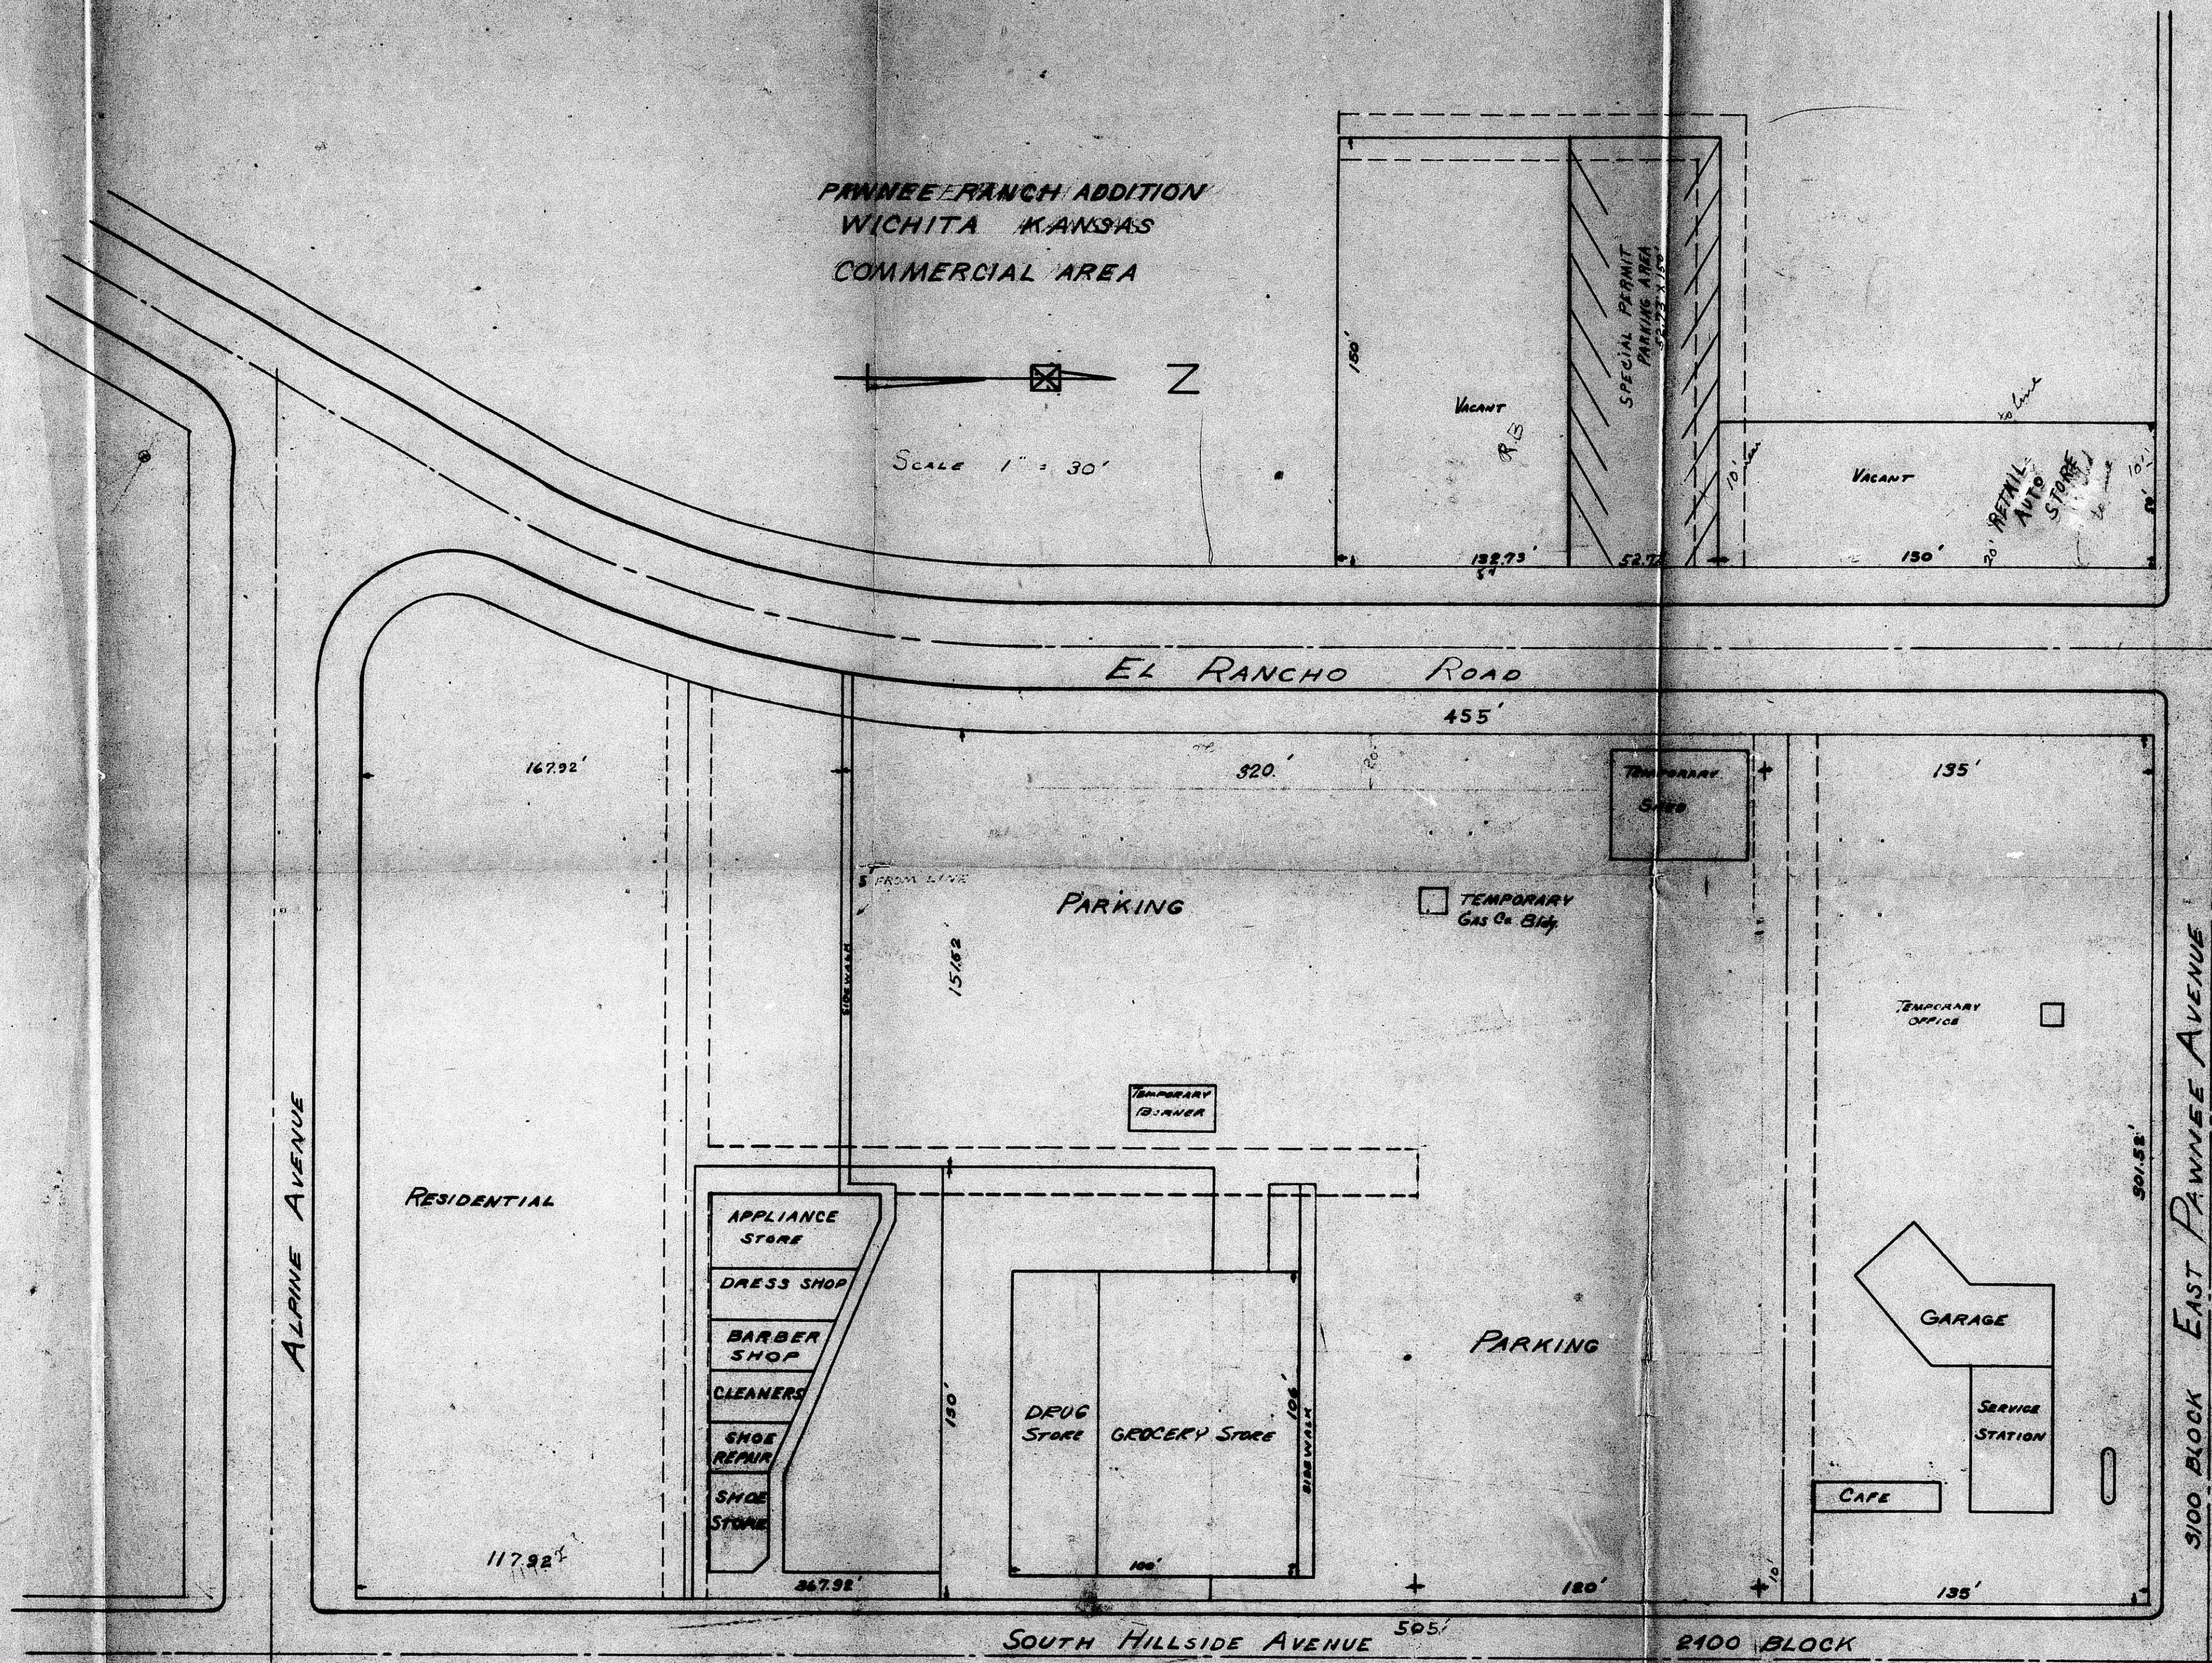

11-54

FILMED FROM THE BEST
AVAILABLE COPY