

TRAFFIC ENGINEERING DIVISION APPROVED
 Date: 0 5-28-71
 (A) Parking barriers shall be installed at all locations that are adjacent to public property (so that vehicles will not obstruct public property) and have a minimum length of 6 feet and a minimum cross section of 4" x 4".
 (B) Stall lines shall be painted and 4" or greater in width.
 (C) Proper ingress and egress signs shall be installed on private property at the entrances and exits of the parking facility.

Handwritten notes:
 Mike...
 5-28-71




BZA 11-71

ALAN M. MAHONEY ARCHITECT
 CENTURY PLAZA BUILDING 265-1576

BOOY'S TOYS

CHITA INC.

REMOVED FROM THE...
 (Stamp)

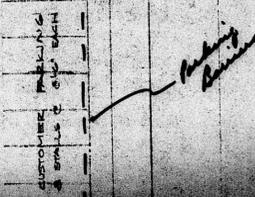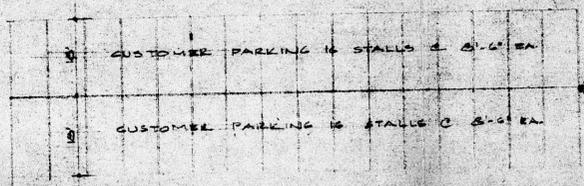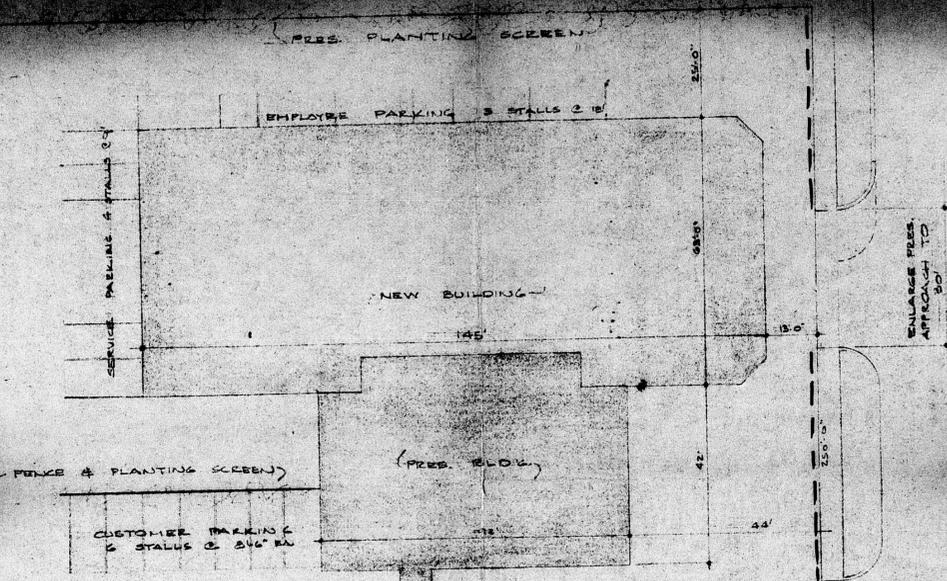

69-11-71
 (A) Parking barriers shall be installed at all locations that are adjacent to public property (so that vehicles will not obstruct public property) and have a minimum length of 6 feet and a minimum cross section of 4" x 4".
 (B) Stall lines shall be painted and 4" or greater in width.
 (C) Proper ingress and egress signs shall be installed on private property at the entrances and exits of the parking facility.

BZA 11-71

ALAN M. MAHONEY
 CENTURY PLACE BUILDING

EDDY'S TOYOTA OF WICHITA INC.

FILMED FROM THE
 ORIGINAL COPY