BZA 11-75

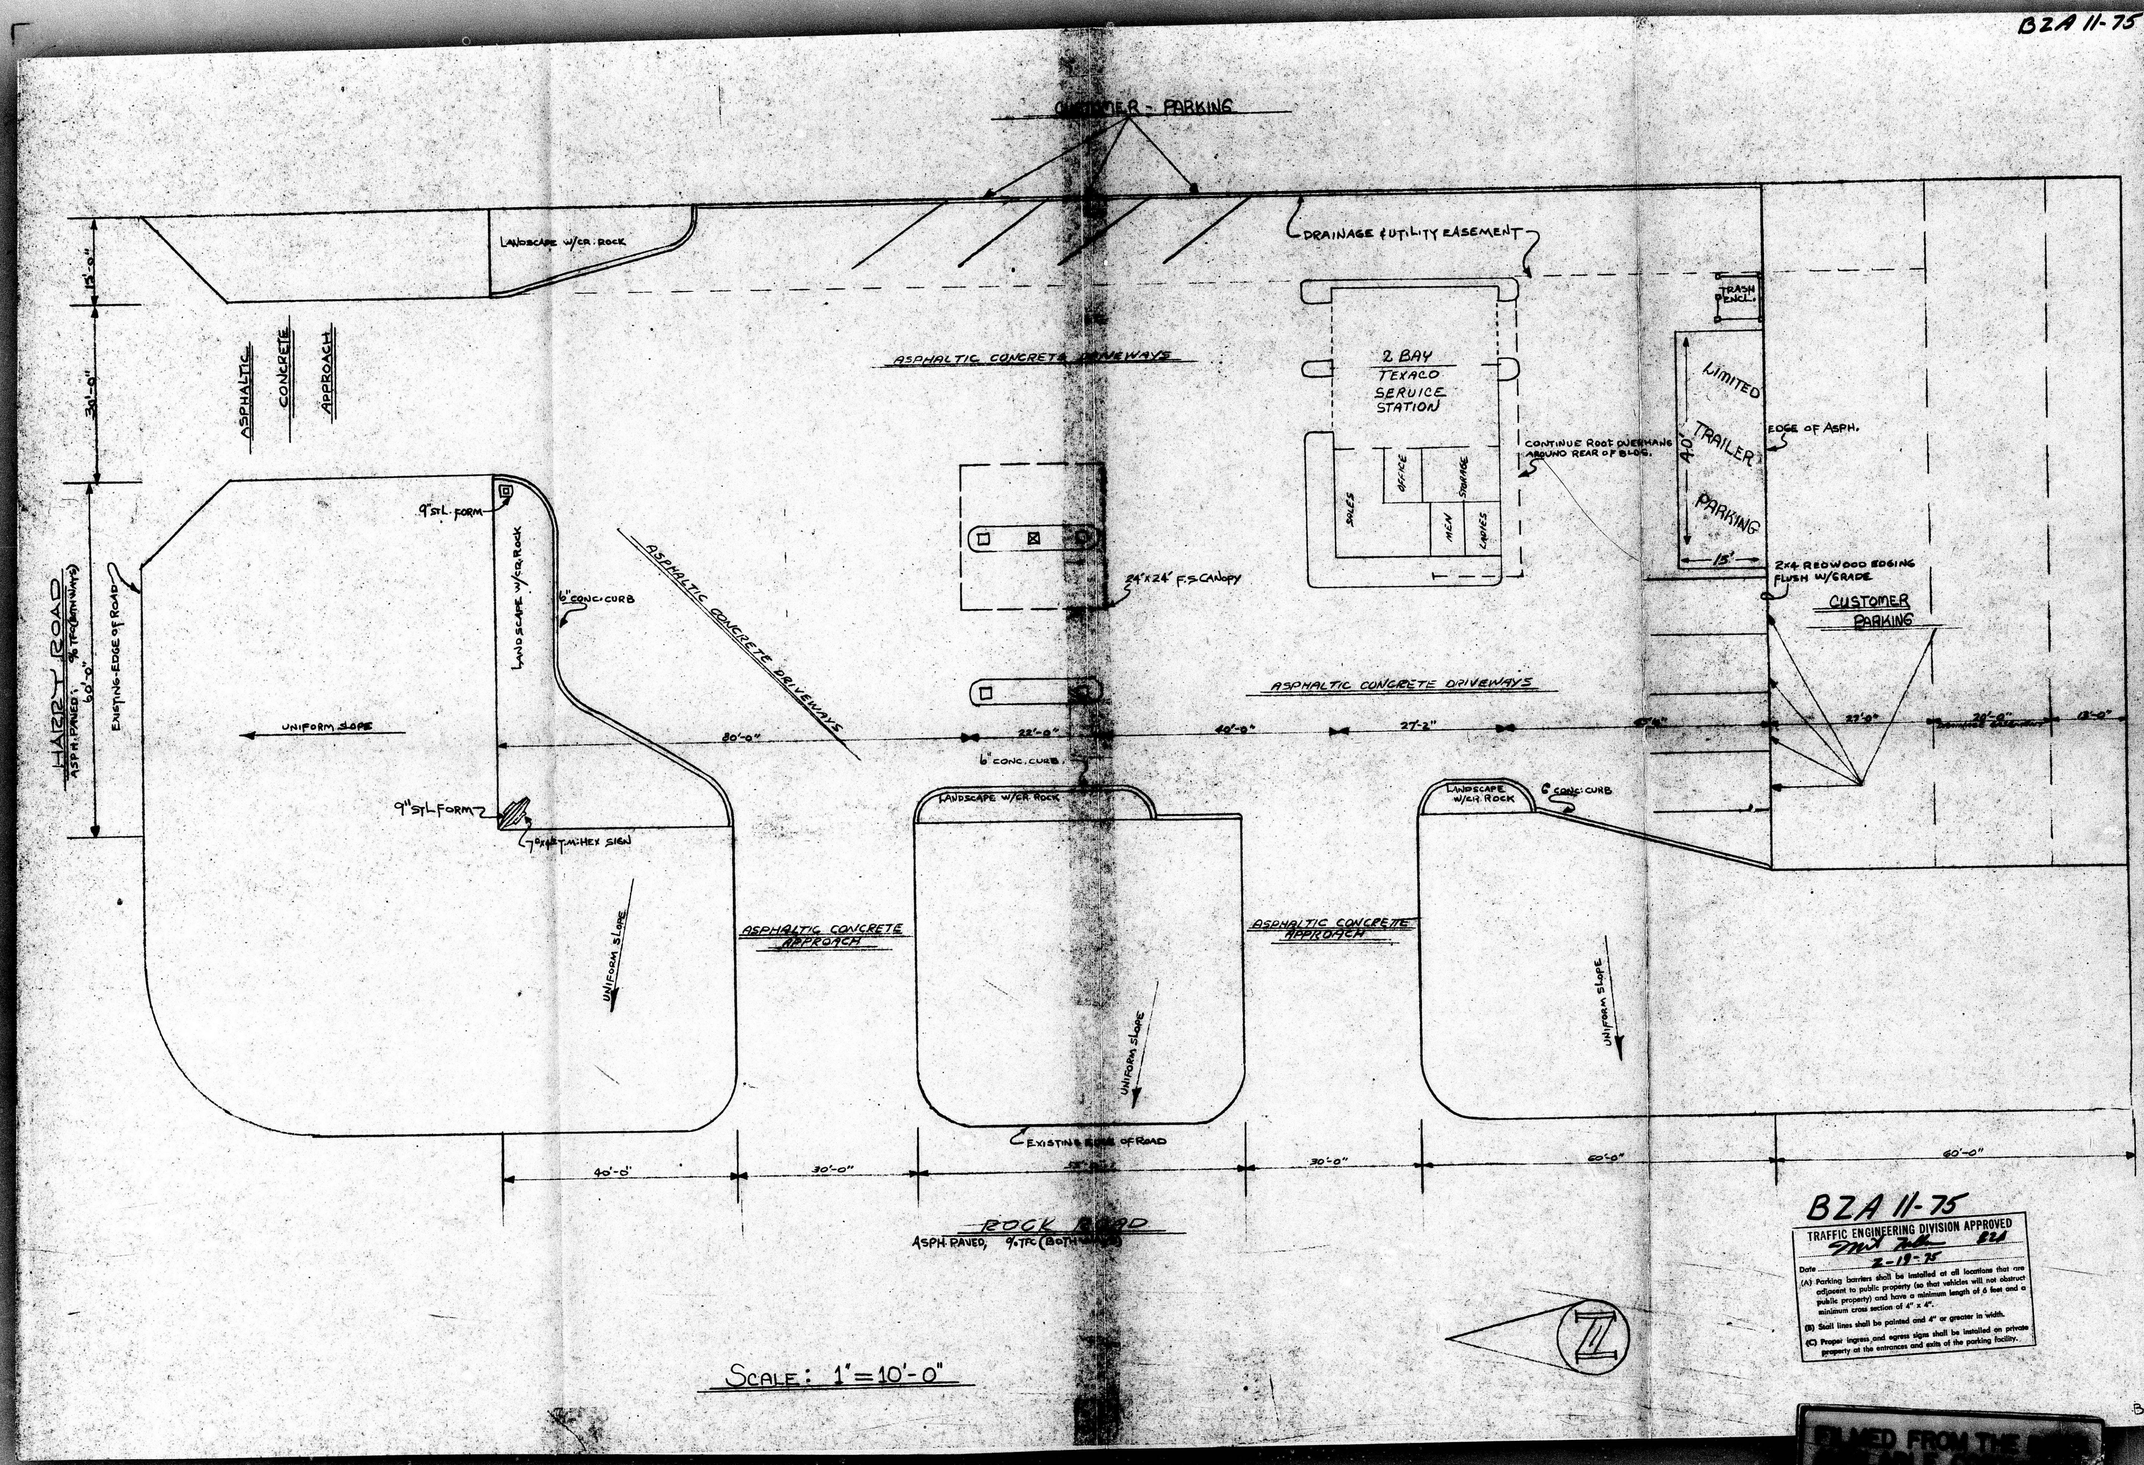

SCALE: 1" = 10'-0"

BZA 11-75

TRAFFIC ENGINEERING DIVISION APPROVED

Date 2-19-75

(A) Parking barriers shall be installed at all locations that runs adjacent to public property (so that vehicles will not obstruct public property) and have a minimum length of 6 feet and a minimum cross section of 4" x 4".

(B) Stall lines shall be painted and 4" or greater in width.

(C) Proper ingress and egress signs shall be installed on private property at the entrances and exits of the parking facility.

B.C.

FILMED FROM THE BEST AVAILABLE COPY