


LOCATION: 8330 E KELLOGG

BZA 14-75

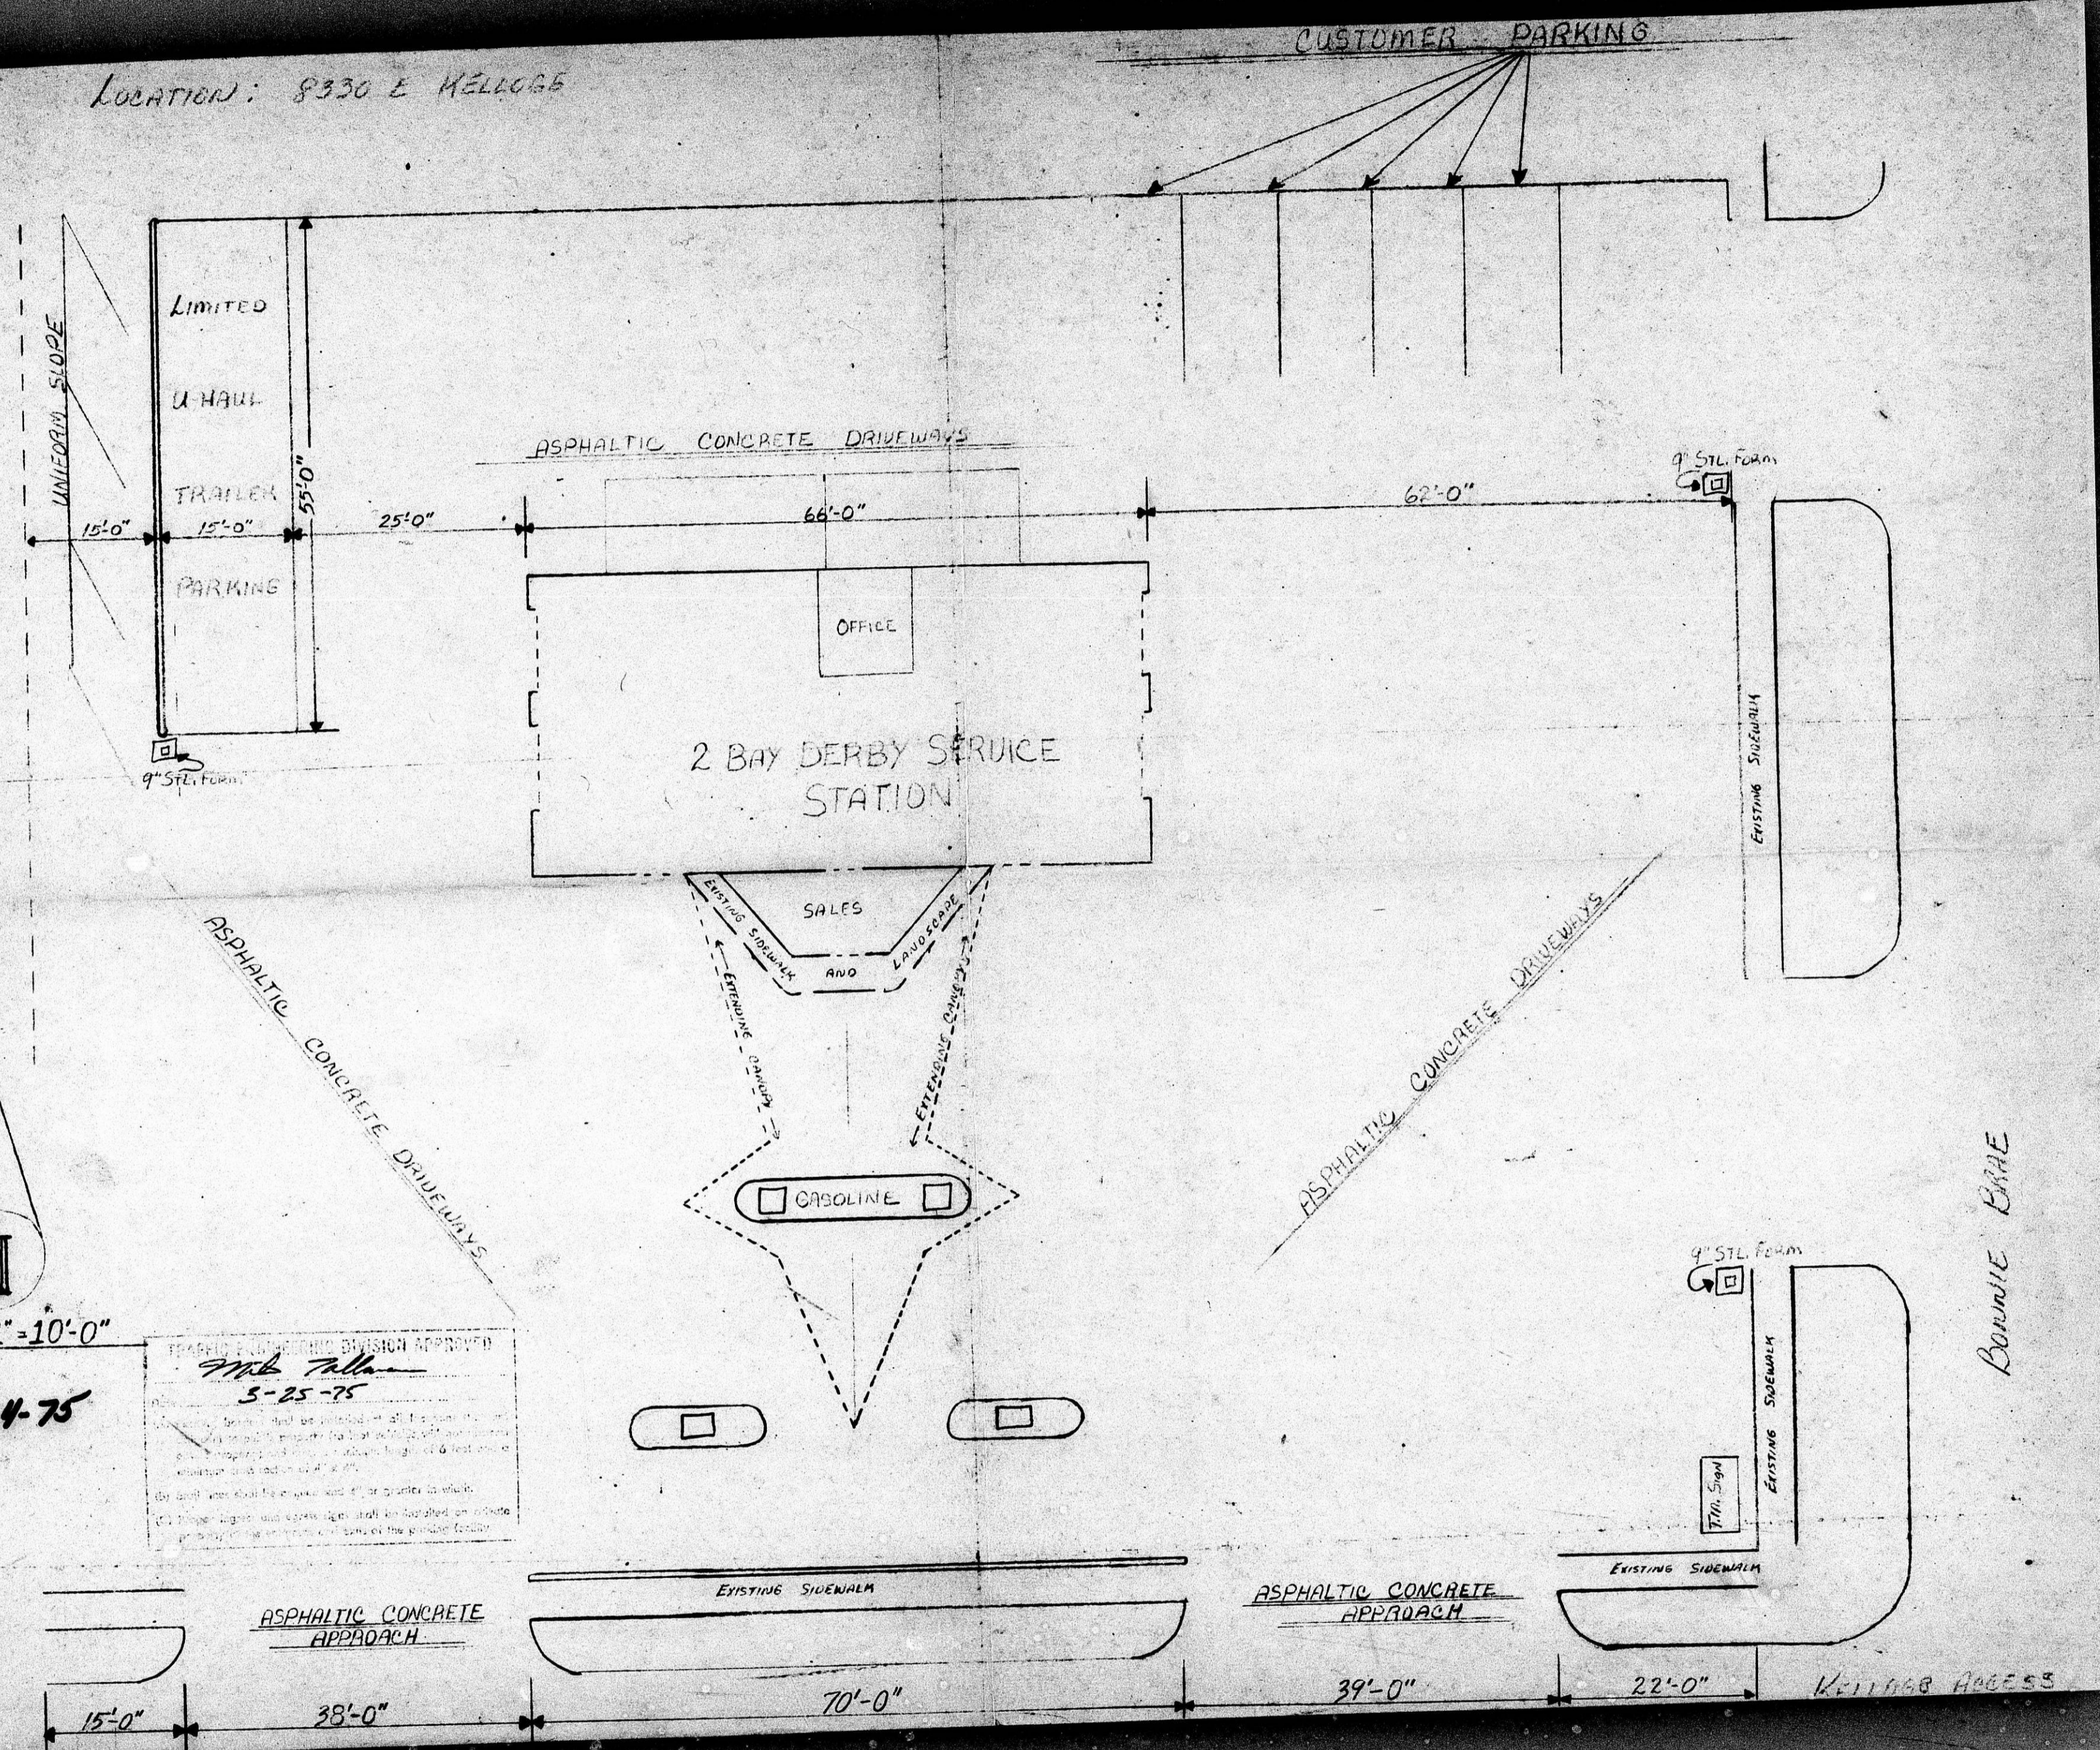

SCALE: 1"=10'-0"

BZA 14-75



5-25-75






BLANK FROM THE

LOCATION: 8330 E HELLOGG

BZA 14-75

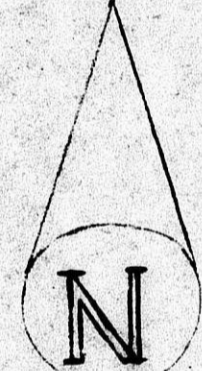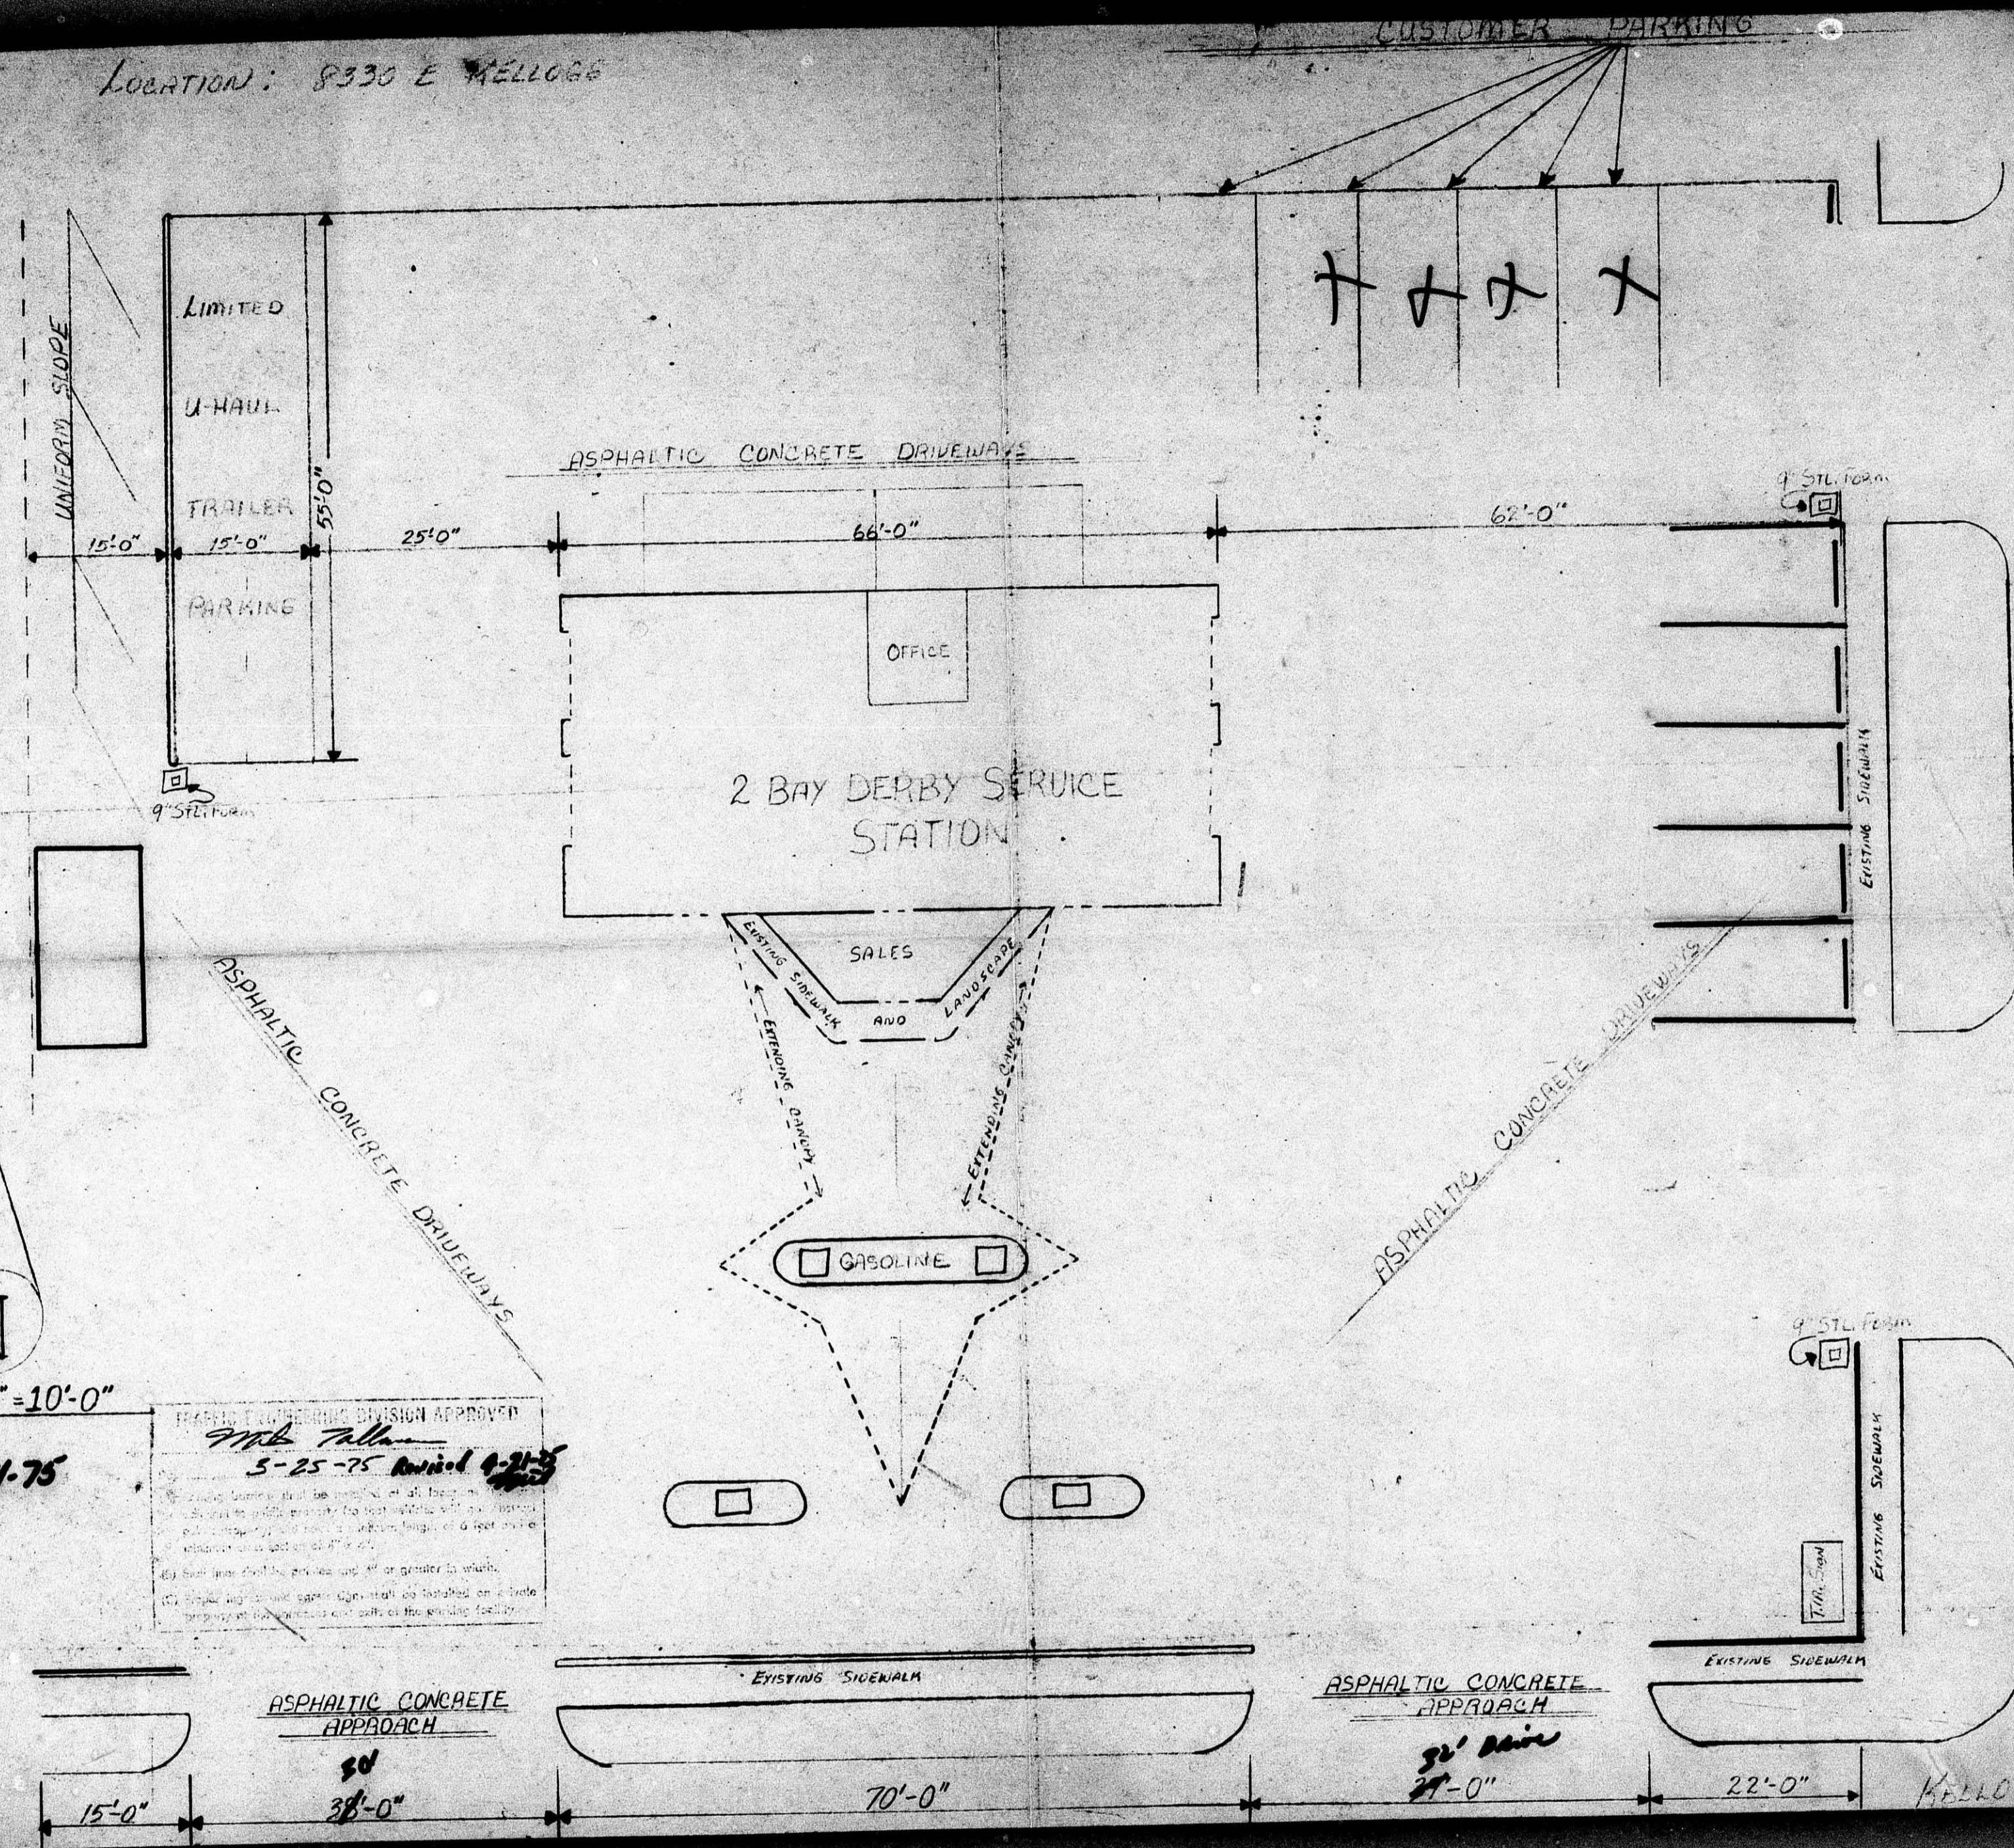

SCALE: 1" = 10'-0"
 BZA 14-75


 5-25-75
 5-25-75




LOCATION: 8330 E HELLOGA

BZA 14-75

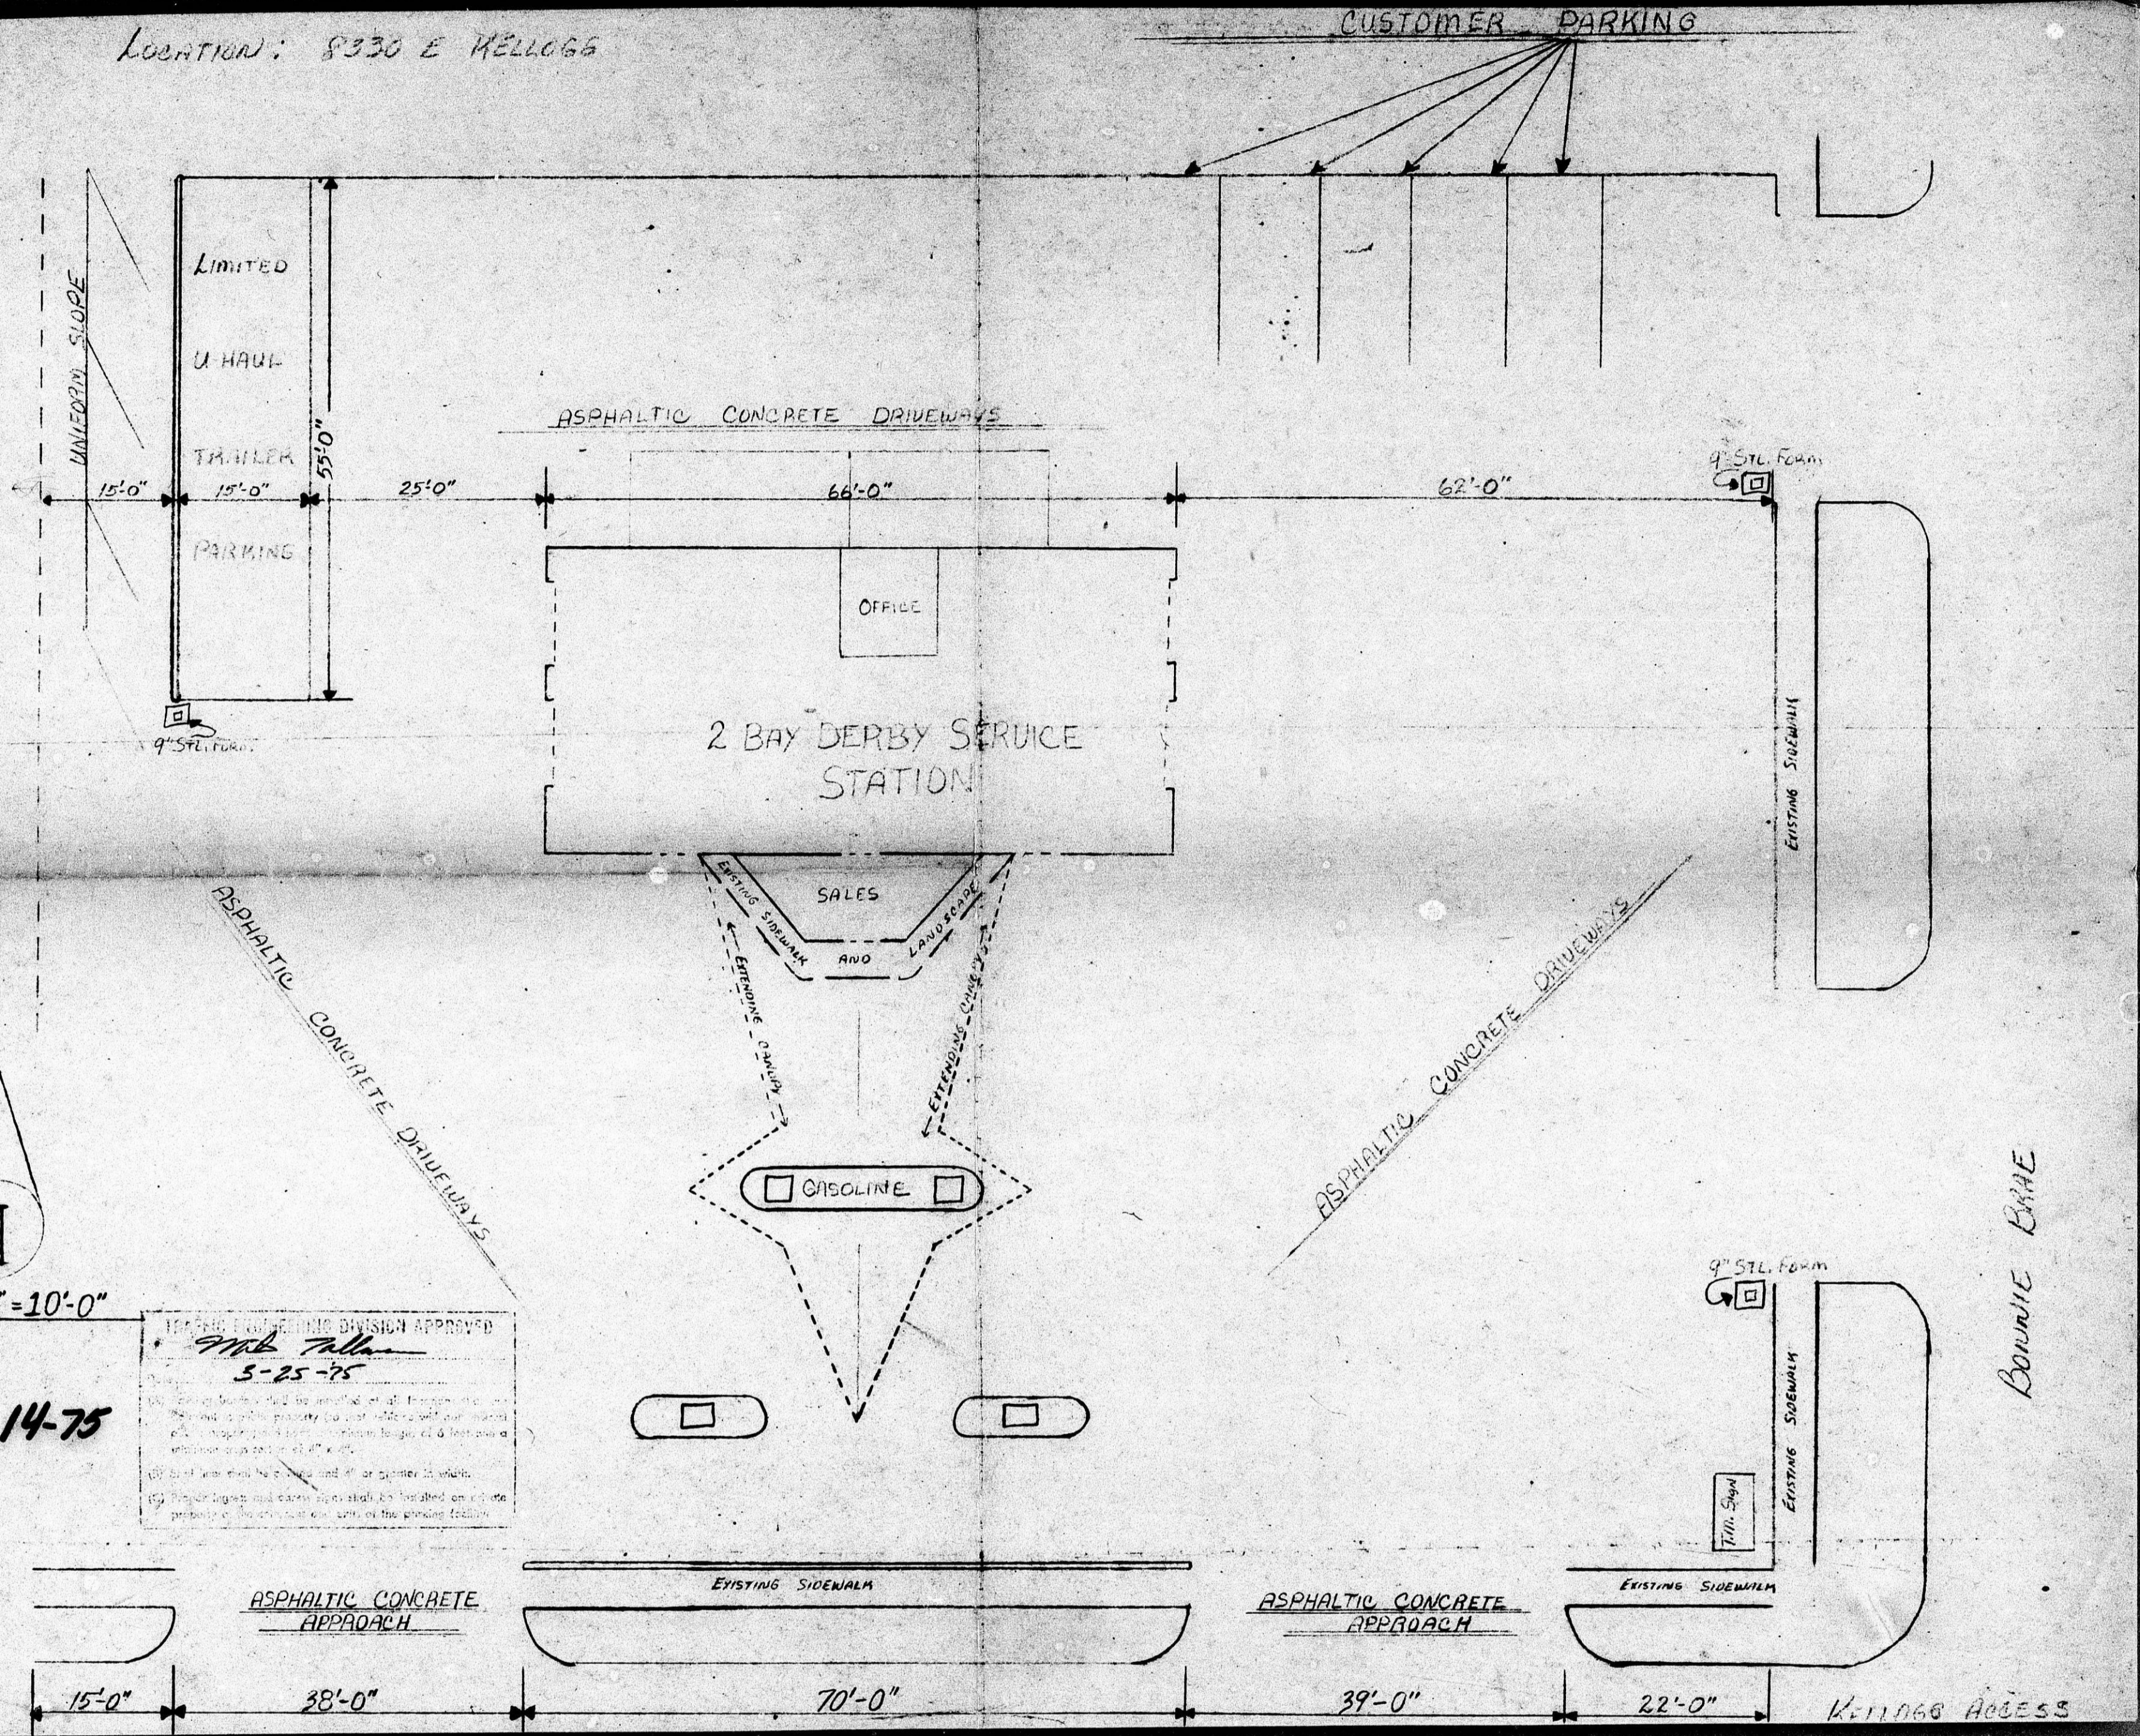

SCALE: 1"=10'-0"

BZA 14-75

 5-25-75

MADE FROM THE
 ORIGINAL PLAN