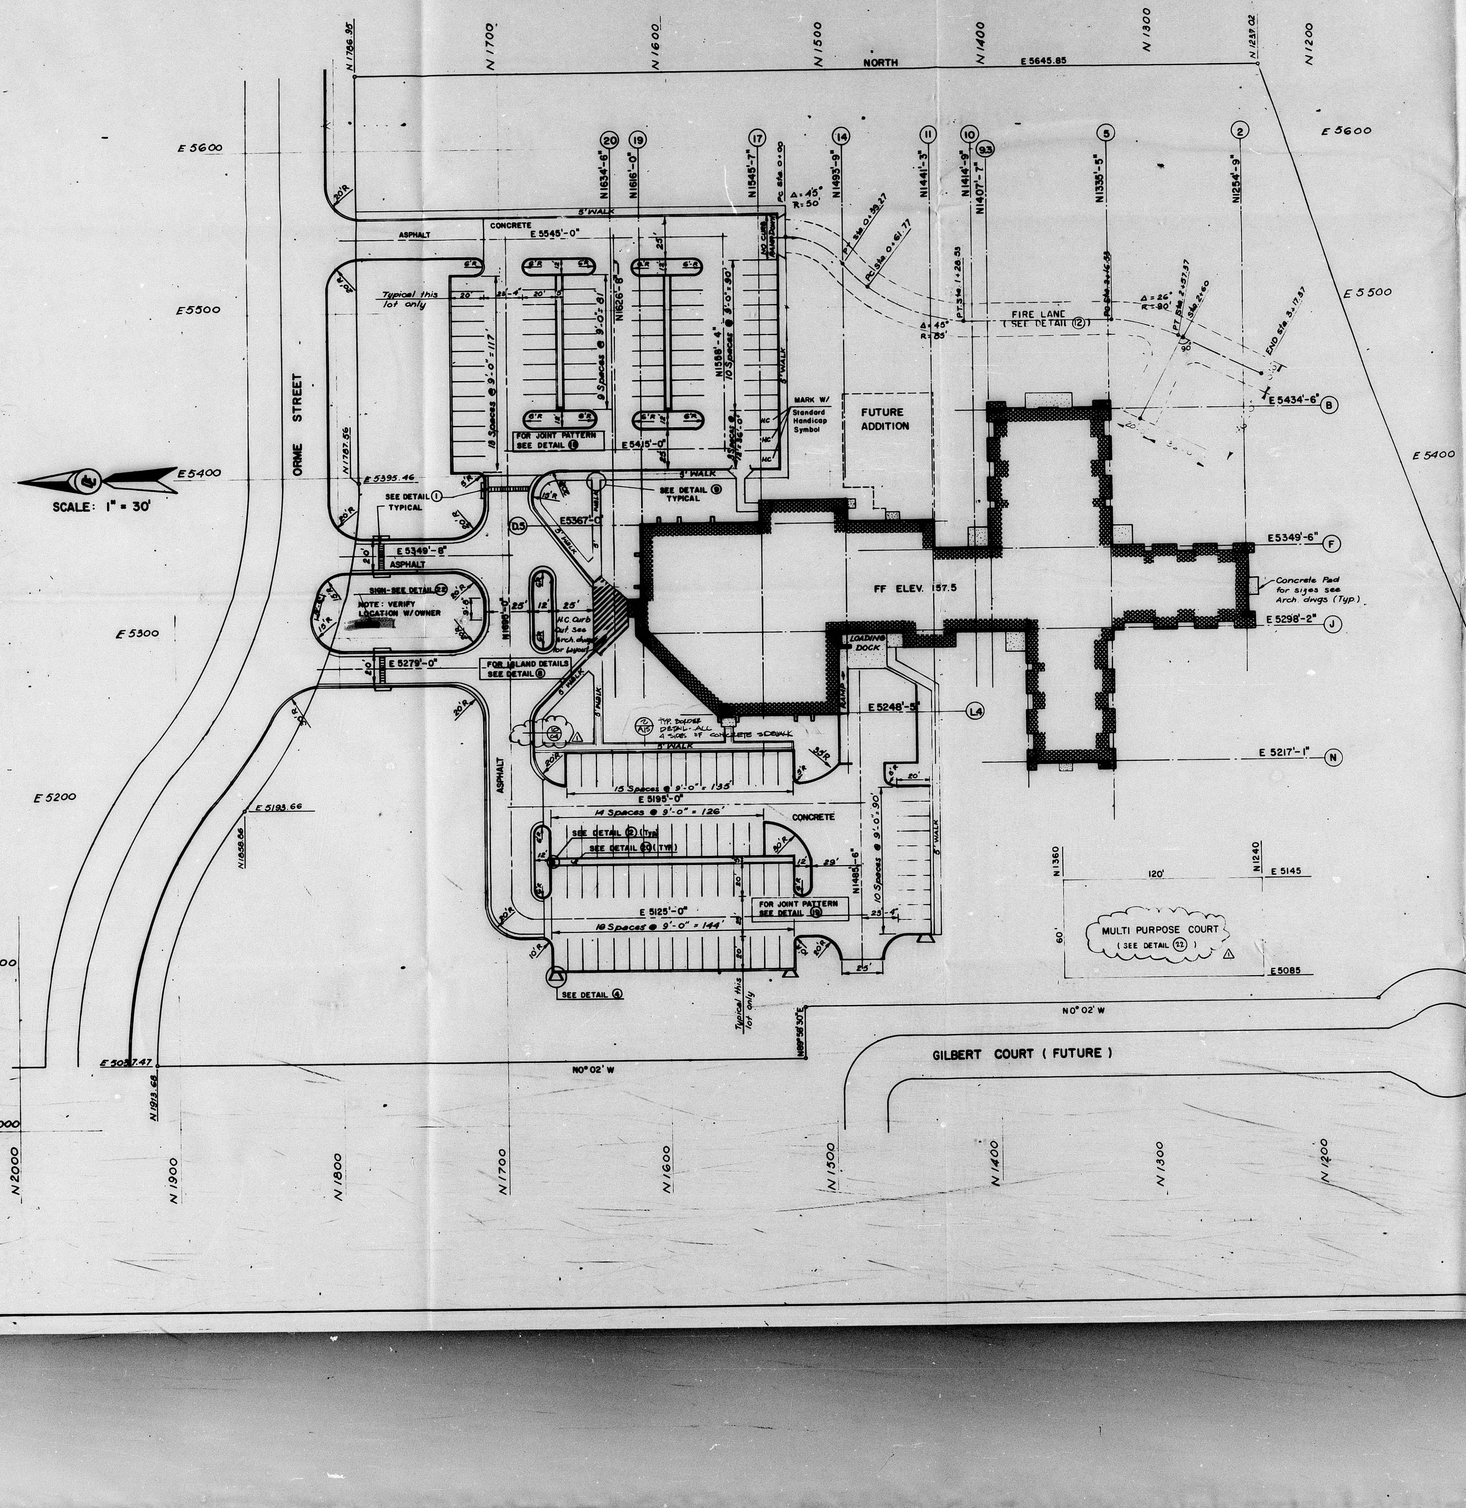

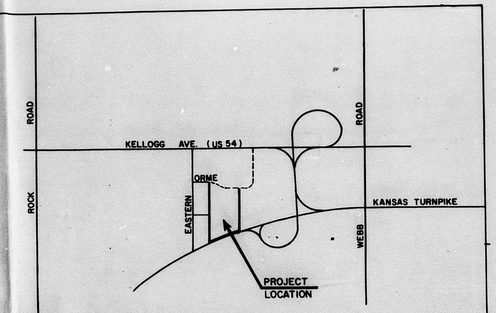

PROJECT LOCATION PLAN
NOT TO SCALE

INDEX TO DETAILS

1 - U-DRAIN
2 - CURB DRAIN
3 - CATCHBASIN
4 - FLUME
5 - STORM SEWER MANHOLES
6 - ASPHALT PAVEMENT
7 - U-DRAIN GRATE AND FRAME
8 - ISLAND SECTION
9 - ABUTTING SIDEWALK SECTION
10 - SIDEWALK SECTION
11 - STORM SEWER OUTLET
12 - FIRE LANE
13 - CONCRETE PAVEMENT
14 - MONOLITHIC CURB
15 - SAWED JOINT
16 - KEYED JOINT
17 - SEALED JOINT
18 - EAST PARKING LOT
19 - WEST PARKING LOT
20 - SIDEWALK AT PARKING
21 - HANDICAP CURB CUT
22 - MULTI-PURPOSE COURT
23 - MULTI-PURPOSE COURT FENCE
24 - SIGN BASE

BZA 14-86

△1 GENERAL REVISION: 12-18-85

CHARTER HOSPITAL OF WICHITA	REVISIONS:
SITE PLAN	△1 General Revision 11/11/85
DELAMATER ENGINEERS INCORPORATED AND CASTLE & ASSOCIATES ENGINEERS WICHITA, KANSAS CIVIL ENGINEERS	DATE NOV. 1, 1985 SCALE 1" = 30' DWG. NO. 1021-A-1 FILE SHEET 1 OF 8
	C-1

FILMED FROM THE BEST AVAILABLE COPY

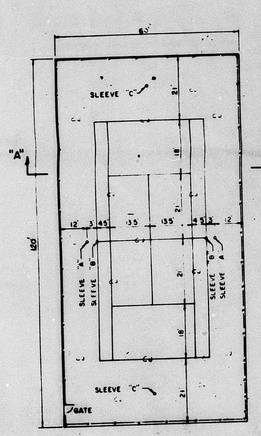

PLAN MULTI-PURPOSE COURT
NOT TO SCALE

ALL ATHLETIC SURFACE WARNING PAINT SHALL BE 2" WIDE AND OF AN APPROPRIATE EXTERIOR GRADE COLOR SELECTION BY OWNER

MARK COURT FOR TENNIS, BASKETBALL AND VOLLEYBALL PLAY

INSTALL "FLEX-PAVE" SURFACING PER MFG SPECIFICATIONS

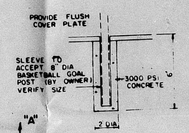

SLEEVE "C"
SCALE 1" = 4'

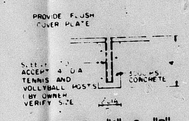

SLEEVE "A" & "B"
SCALE 1" = 4'

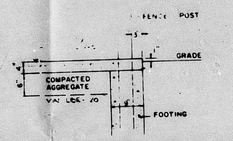

TYPICAL EDGE DETAIL
SCALE 1" = 1'

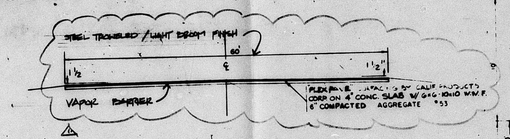

CROSS - SECTION "A - A"
SCALE 1" = 10'

DETAIL 22

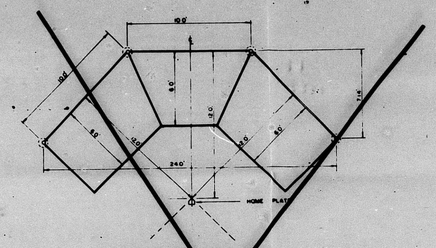

BACKSTOP - PLAN VIEW
SCALE 1" = 4'

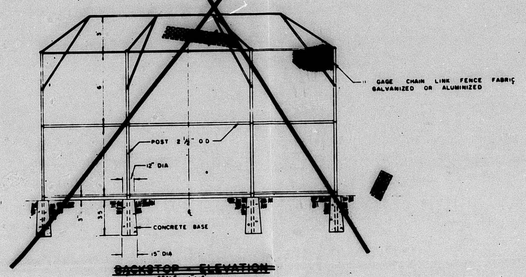

~~BACKSTOP - ELEVATION~~
SCALE 1" = 4'
NOT USED

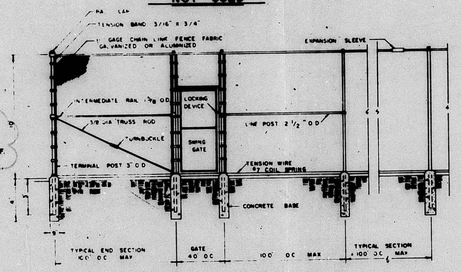

MULTIPURPOSE COURT FENCE - ELEVATION
SCALE 1" = 4'

DETAIL 23

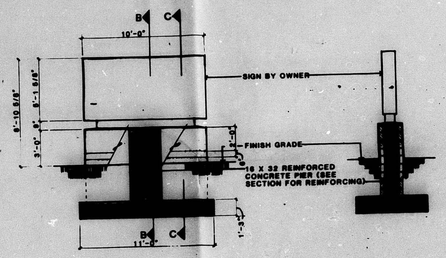

ELEVATION

SECTION THRU PIER

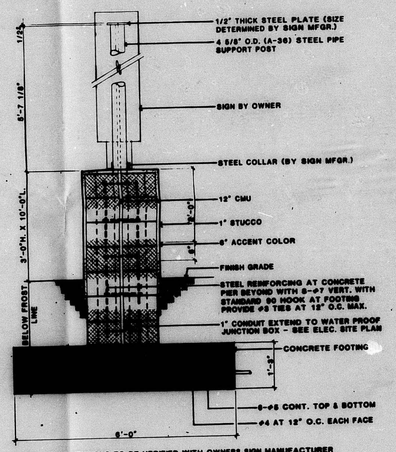

NOTE: ALL DIMENSIONS TO BE VERIFIED WITH OWNERS SIGN MANUFACTURER

SECTION AT SIGN BASE

DETAIL 24
SIGN BASE

BZA1486


CHARTER HOSPITAL OF WICHITA	REVISIONS:
DELAMATER ENGINEERS INCORPORATED AND CASTLE & ASSOCIATES ENGINEERS WICHITA, KANSAS CIVIL ENGINEERS	DATE NOV. 1, 1985 SCALE AS SHOWN DWG. NO. 1081-A-8 FILE SHEET OF

C-8

FILMED FROM THE BEST AVAILABLE COPY