Note: Riverside Nursery School, Inc. maximum enrollment 54 children.

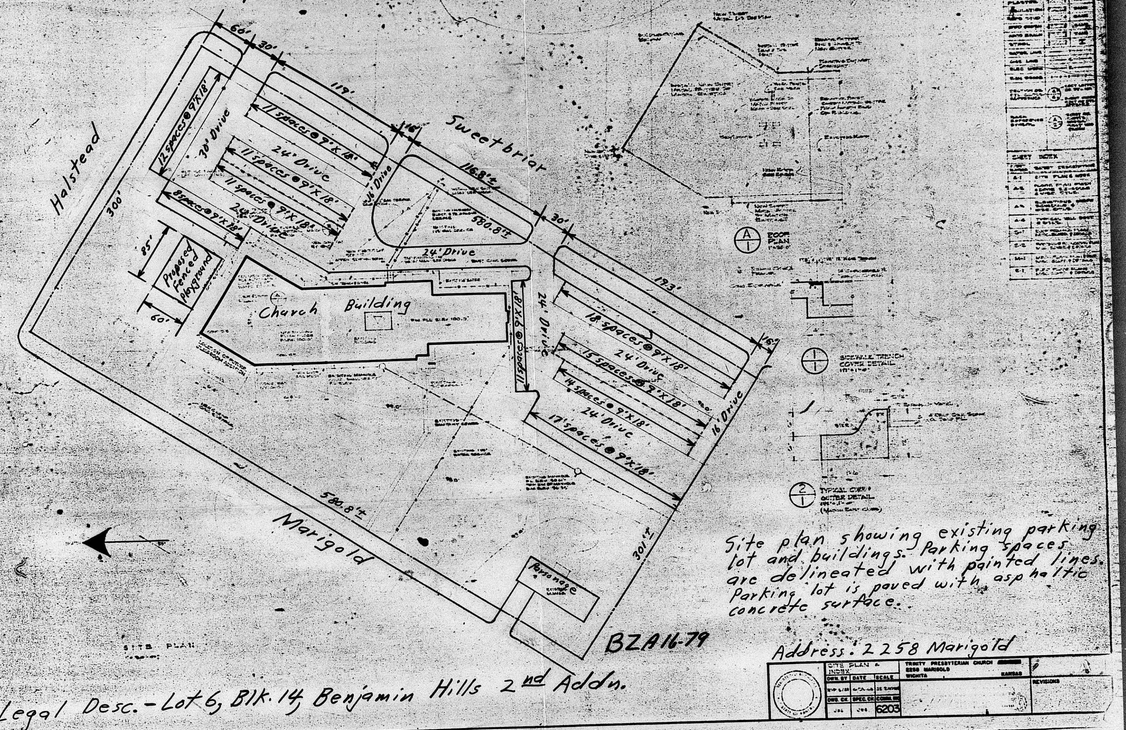

FILMED FROM THE BEST AVAILABLE COPY