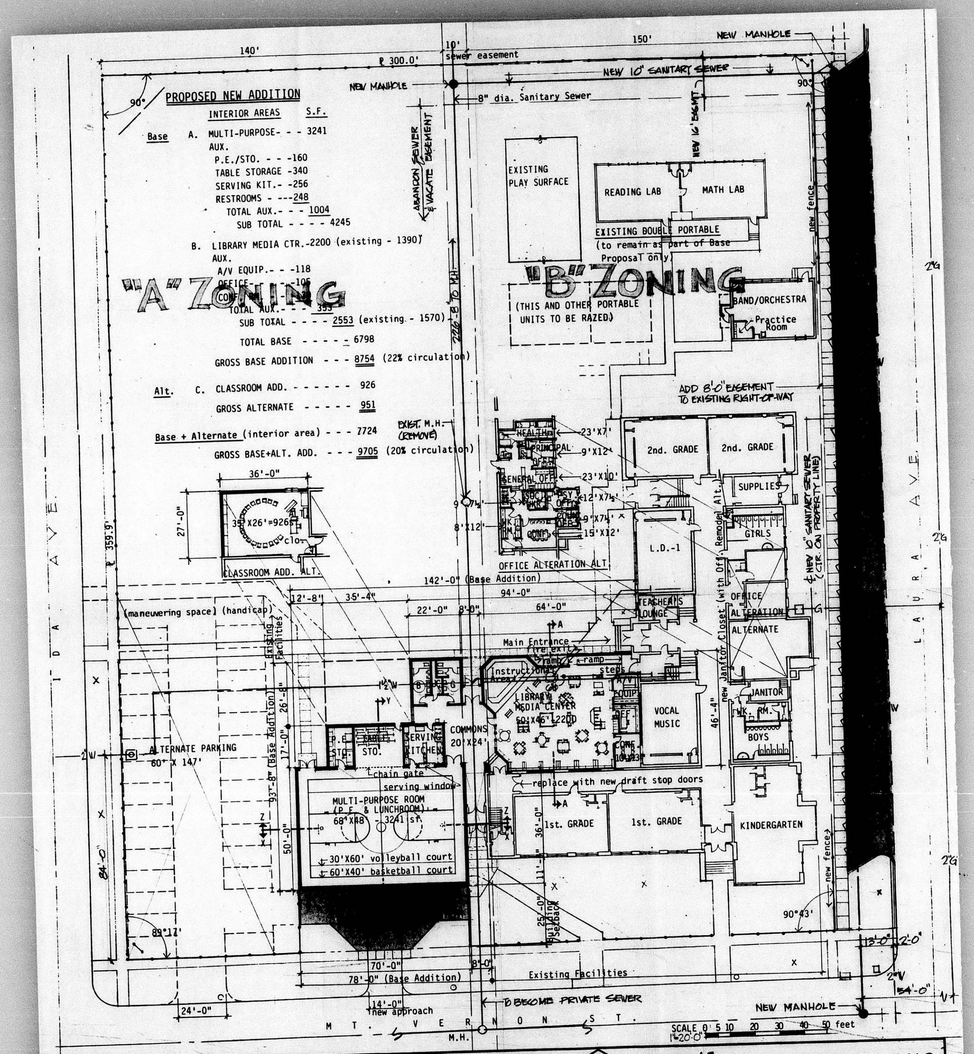


PROPOSED IMPROVEMENTS BZA 16-83 SITE/1ST FLOOR PLANS

GARDINER ELEMENTARY SCHOOL
UNIFIED SCHOOL DISTRICT NO. 259
WICHITA PUBLIC SCHOOLS

ADDITION & ALTERATIONS
SCHEMATIC/DESIGN DEVELOPMENT
REV. 3/22/83
MARCH 1983

DAVID STOCK ASSOCIATES ARCHITECTS

2 of 5

FILMED FROM THE BEST AVAILABLE COPY