BZA 16-88

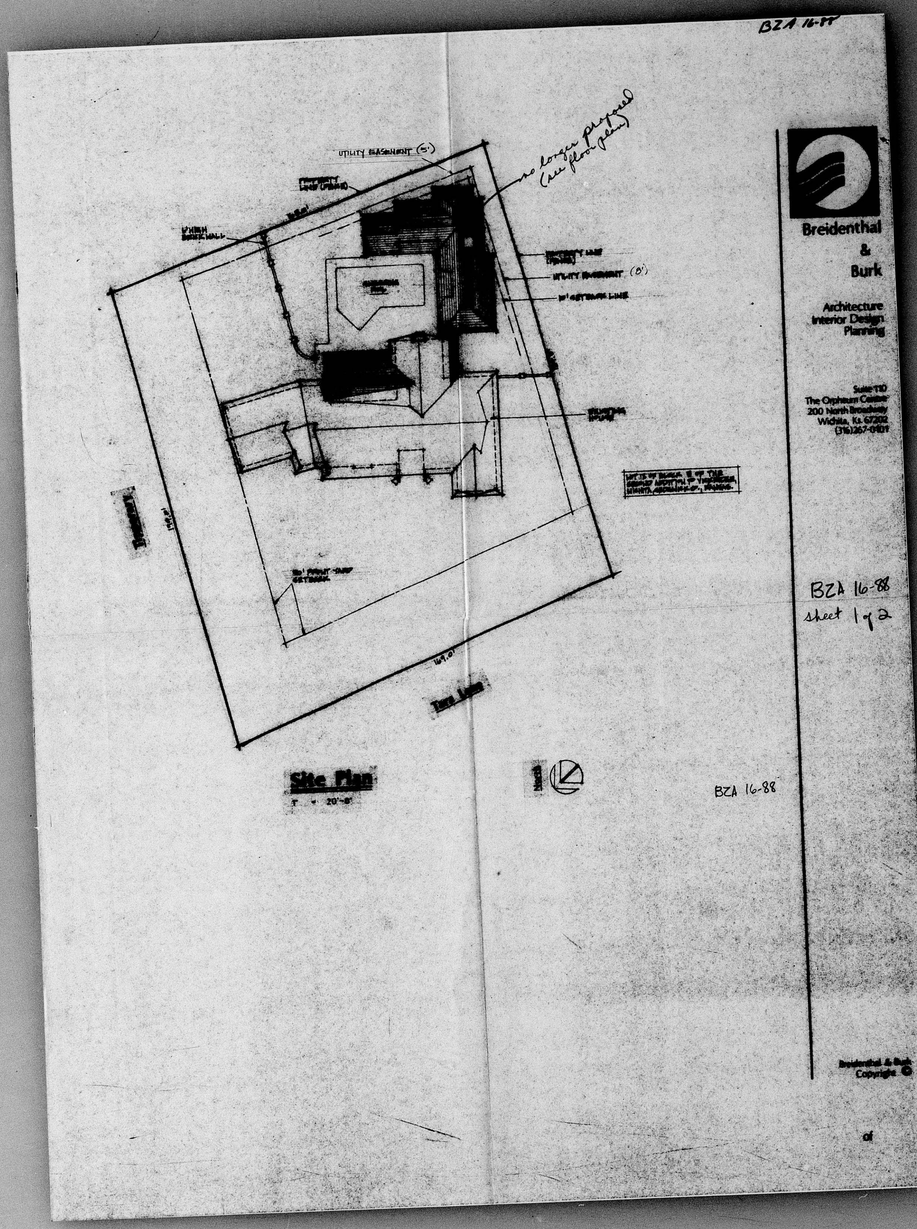

Breidenthal & Burk

Architecture
Interior Design
Planning

Suite 720
The Orpheum Center
200 North Broadway
Wichita, Ks 67202
(316)267-0107

BZA 16-88
sheet 1 of 2

BZA 16-88

Breidenthal & Burk
Copyright ©

of

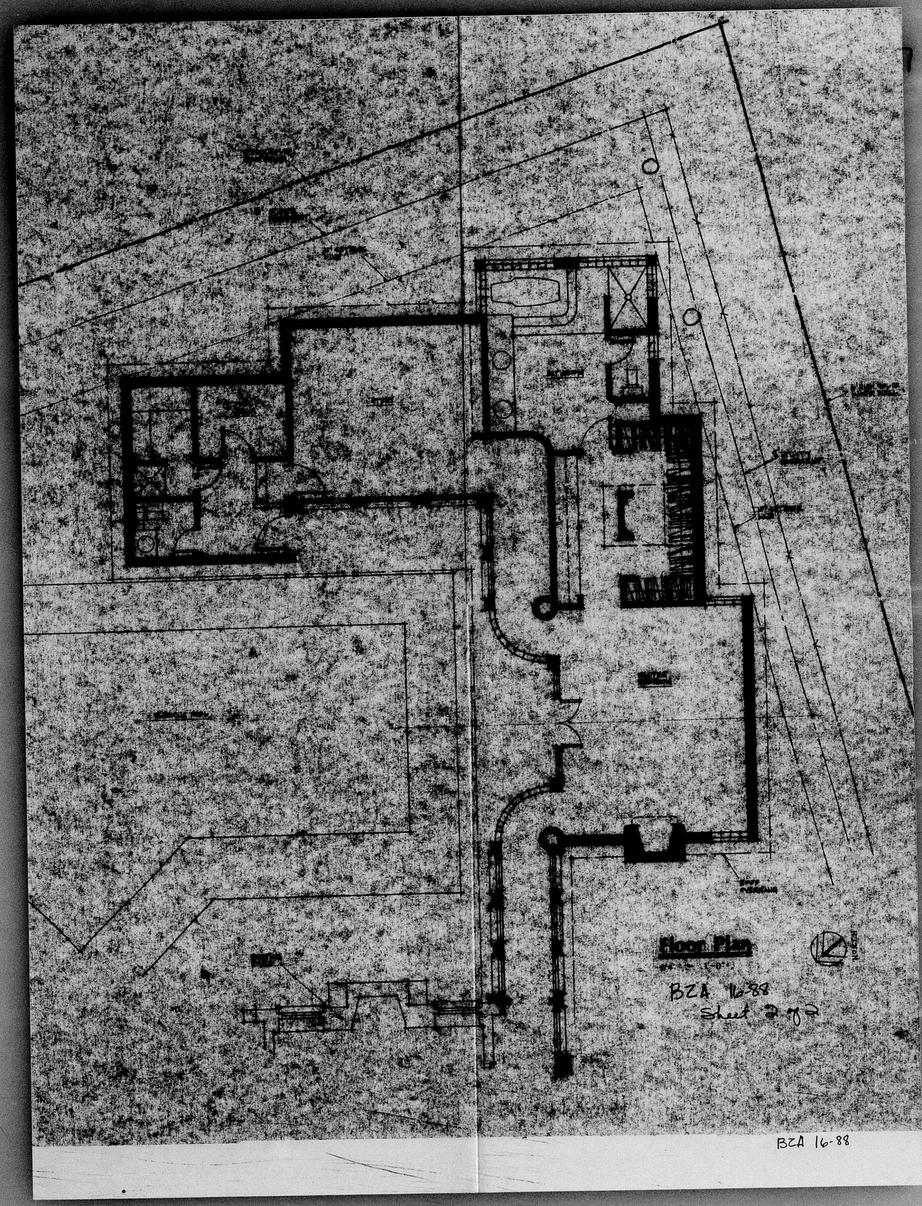

BZA 16-88
Sheet 2 of 2

BZA 16-88

FILMED FROM THE BEST AVAILABLE COPY