
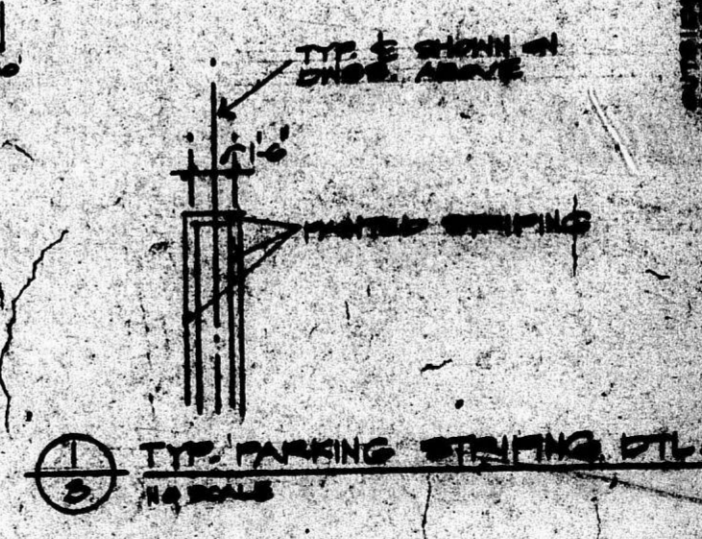


TRAFFIC ENGINEERING DIVISION APPROVED  
 Date: 6-27-73  
 (A) Parking barriers shall be installed at all locations not adjacent to public property (on that vehicles will not be on public property) and have a minimum length of 6 feet and a minimum cross section of 4" x 4".  
 (B) Steel bars shall be placed and 4" or greater in width.  
 (C) Proper signs and signs shall be installed on private property at the entrance and exits of the parking facility.

Note: Turning Radius into the parking lot is not sufficient for any truck longer than 30'

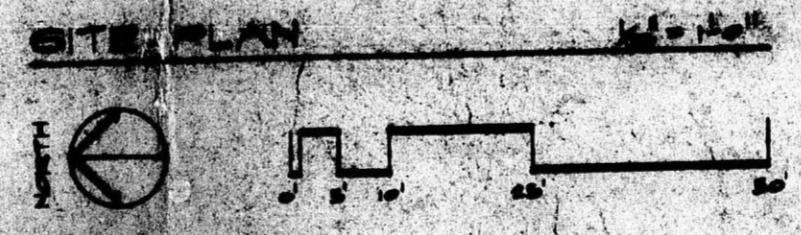


SYMBOLS


BZA 17-73



FILED FROM THE BEST AVAILABLE COPY