


DATE	REVISION
11-15-71	

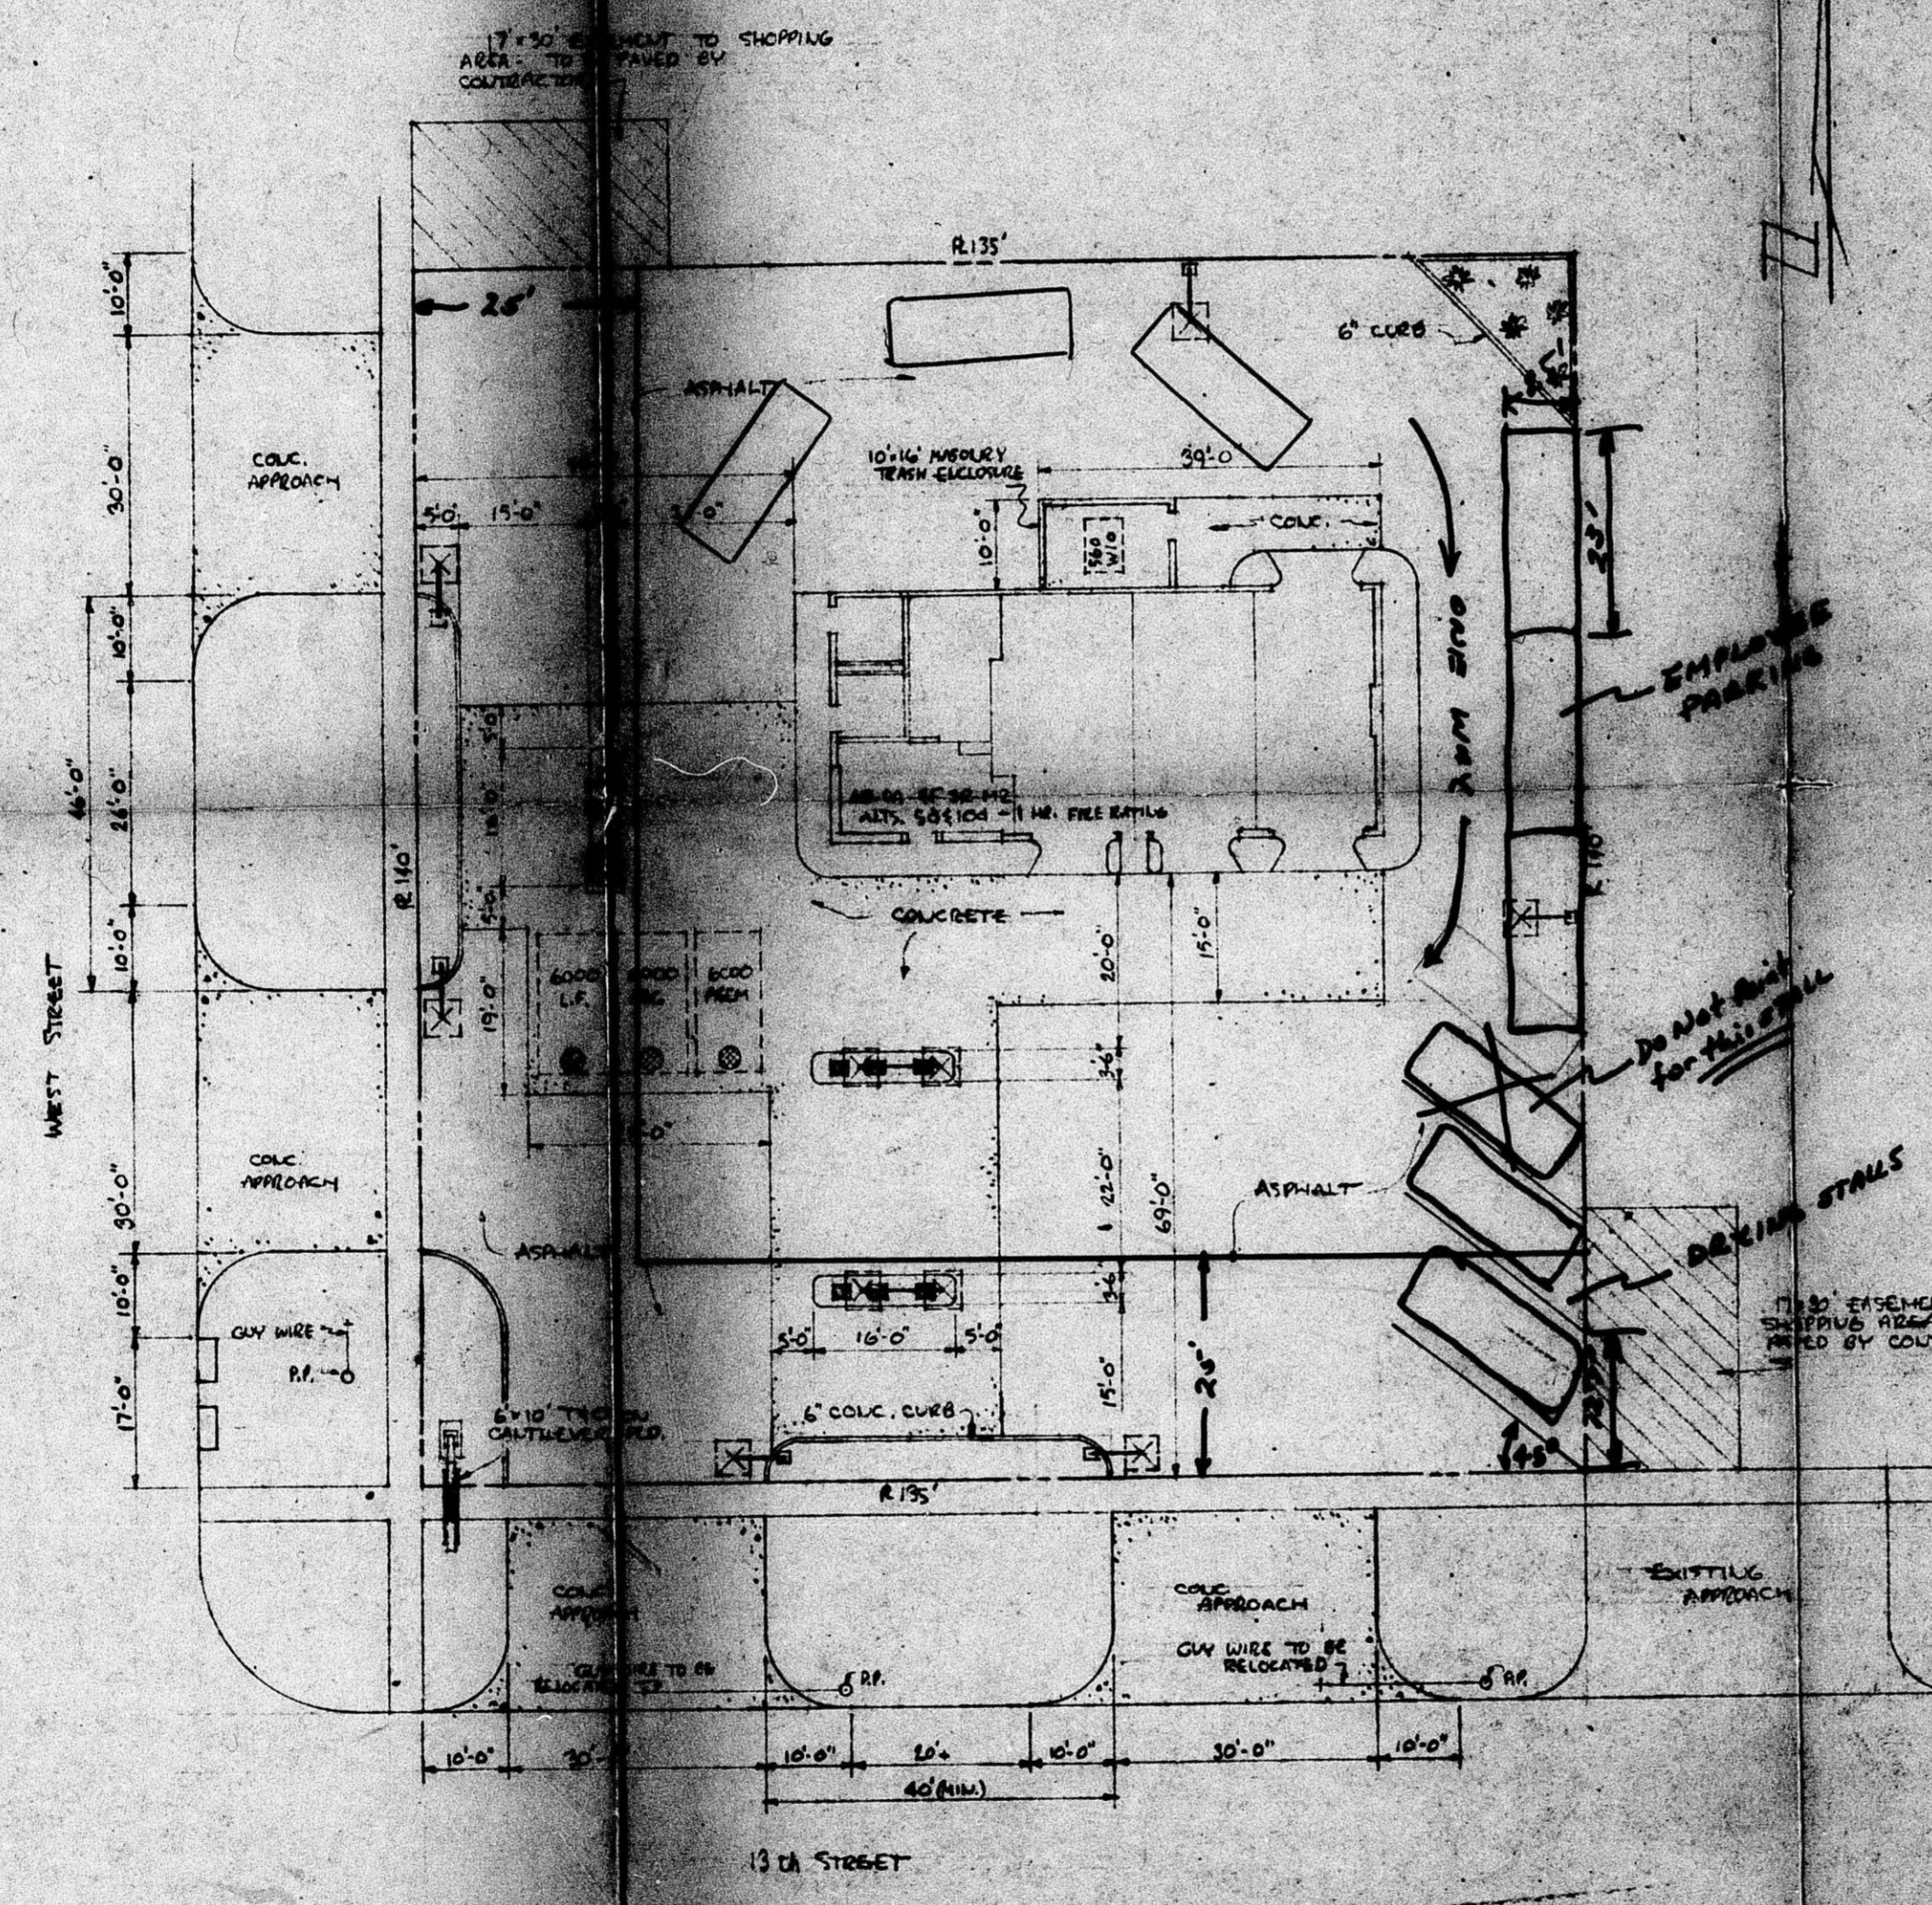

**TRAFFIC ENGINEERING DIVISION APPROVED**  
*[Signature]*  
 11-15-71

1. Traffic barriers shall be installed at all locations that are adjacent to public property and that vehicles will not be able to pass over the barriers and have a minimum length of 10 feet and a minimum cross section of 4" x 4".





BZA 18-71



STANDARD OIL DIVISION OF AMERICAN OIL COMPANY KANSAS CITY REGION		REVISED LAYOUT 13th & WEST STREETS WICHITA, KANSAS	
DESIGNED BY DATE CHECKED BY DATE	SCALE DATE	APPROVED BY DATE	CHECKED BY DATE
			878

MADE FROM THE...

