

CU-191


DR. R.L. MATHIAS
7220 S. BROADWAY
WICHITA, KANSAS
67233

UNPLATTED
BEVERLY A. GORDON
 RURAL RESIDENTIAL

Installation of approximately 600 lbs cresses a year is estimated. Average weight of each cress will be approximately 140 pounds.
 Capacity of incinerator is 90 pounds of material per hour, which would estimate one and one-half hours of burning per cress, or two and one-half hours of burning per day.

Owner & Subdivider - Bradford Const. Co.
 7320 S. Broadway
 Wichita, Kansas 67233
 Ellis Bradford, Pres.

Engineer - Professional Engineering Consultants, P.A.
 1440 E. English
 Wichita, Kansas 67211
 W.H. Kaitner PE.


Rev. Added drainage apron, new gravel rd, Lot 1 Block No. 1, existing water and sewerage serv. 5-17-78

PRELIMINARY PLAT
BRADFORD ADDITION
CU-191

PROFESSIONAL ENGINEERING CONSULTANTS, P.A.
 ENGINEERS
 WICHITA, KANSAS

Designed by: T.K. R.F.J. Checked by: Date: May 28, 78 Job No. 78088

N.M. Cor. of Sec. 4, T29S, R1E of the 6th P.M.

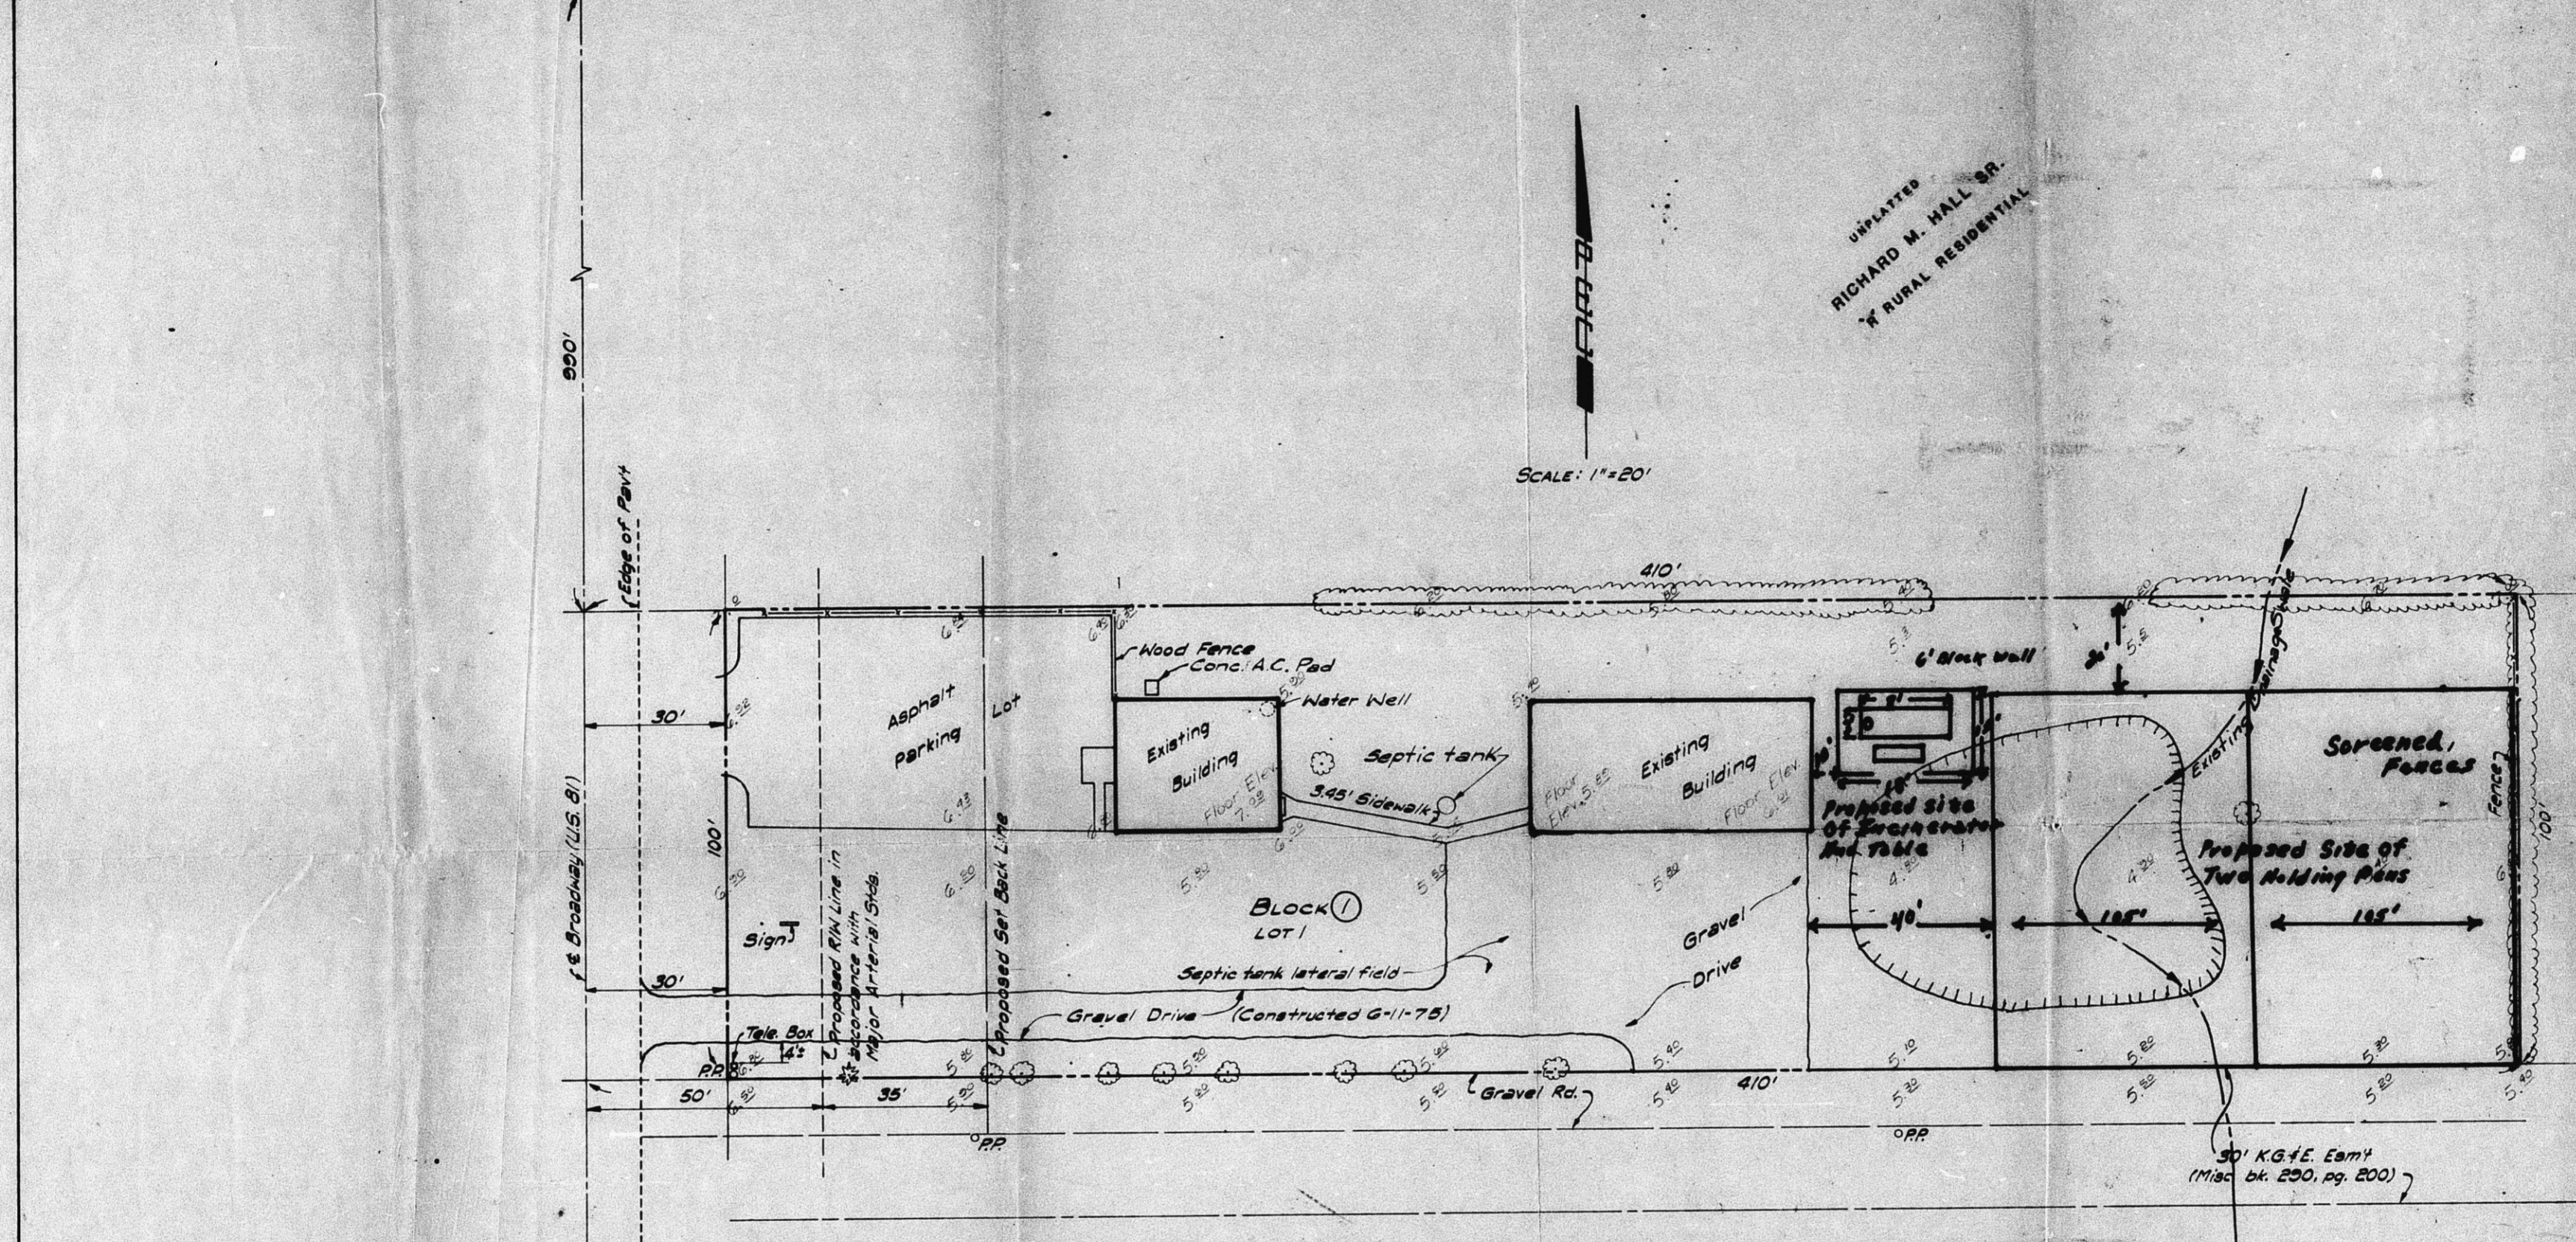

UNPLATTED
RICHARD M. WALL SR.
 RURAL RESIDENTIAL

UNPLATTED
DAVID K. GLINE
VICTOR A. HETZEL
 GENERAL COMMERCIAL

NEAREST PUBLIC UTILITIES

Water - approx. 600' North of site on east side of Broadway.
 Gas - approx. 280' North of site on east side of Broadway.
 San. Sewer - North side Diedrich Ave. 150' west of Broadway.

Notes: All elevations shown are at mean sea level (M.S.L.)
 Existing zoning for proposed Lot Block 1 Bradford Addition is 'R' (Rural Residential). Zone change to 'C' (Commercial) has been approved subject to platting. (Refer to SCE-0839). Existing proposed use of parcel is for a construction company office.

B.M. Spike in power pole located at S.N. corner of property Elev. 1256.80 (M.S.L.)

Date of Topo. Survey 5-18-78

