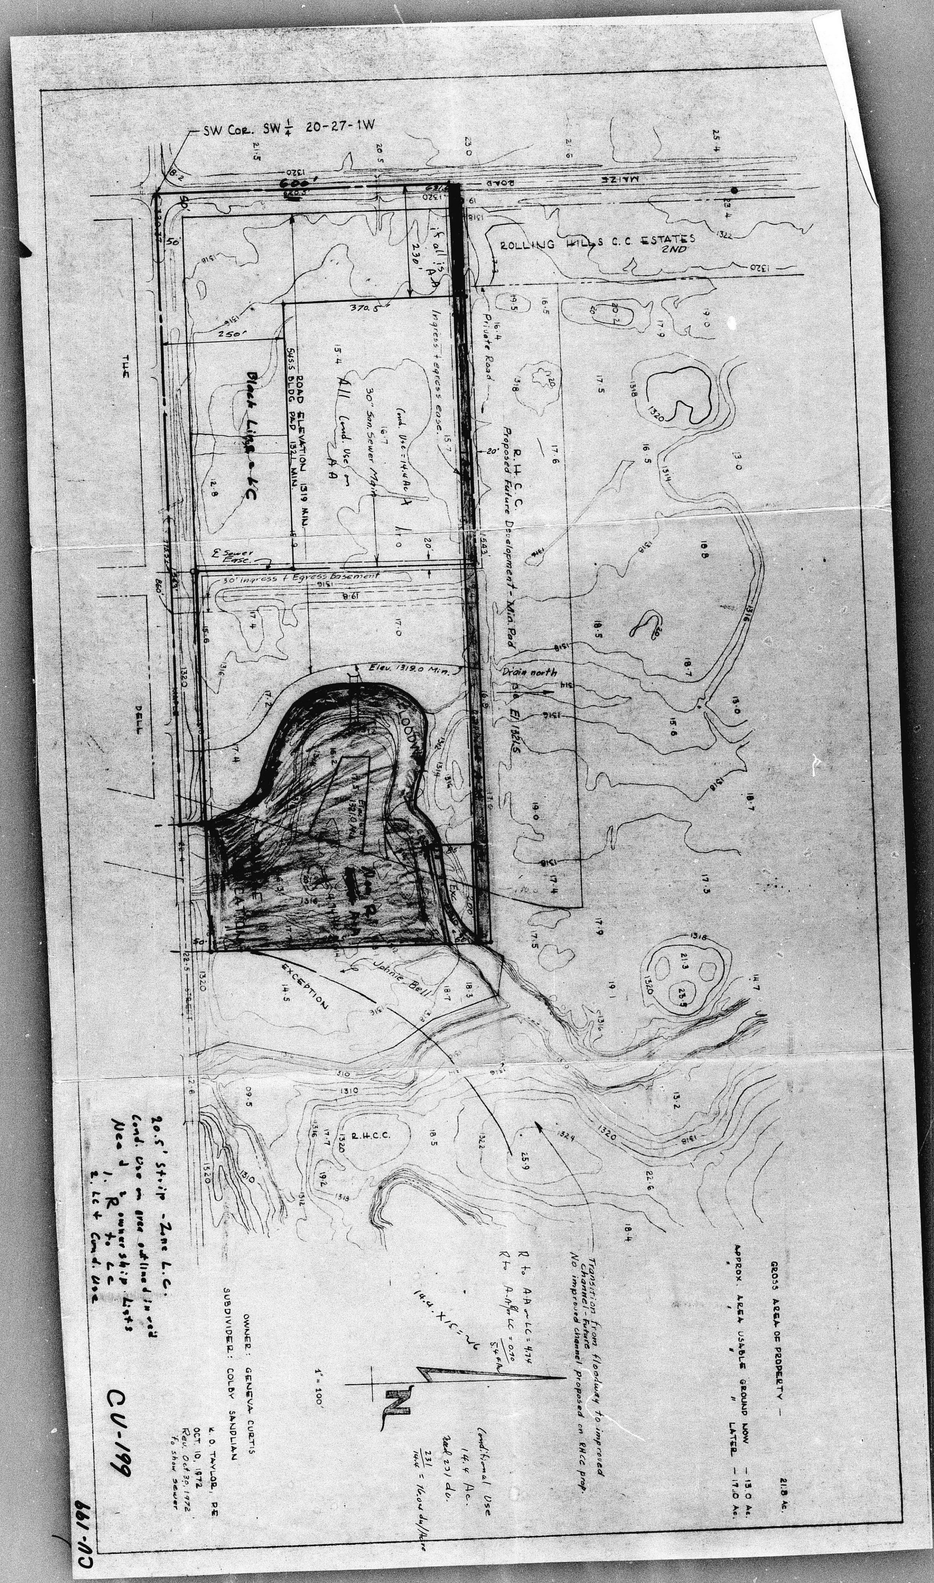

FILMED FROM THE BEST AVAILABLE COPY ....