

ACTION

DATE

COMMITTEE *no hearing necessary*

M.A.P.C. *no hearing necessary*

B.C.C./ [REDACTED] *accept 6-1-72*

D-0491 - Ivan J. Bamnes Dedicates
Street ROW at SE corner of K-15
and Fernell Street

(5838)
MAP No. O-8-D
SEC. No. NW 1/4 1
TWP. No. 29 S
RANGE 1 E

DEDICATION REPORT AND PROGRESS

CASE No. D - 0491

I. OFFER TO DEDICATE: Street row
GENERALLY LOCATED: At the southeast corner of K-15 and Fernell Streets

LEGALLY DESCRIBED AS:

The W 10' of Lot 7, Nelson's 2nd Crestview Addition to Sedg. Co., Ks.


DEDICATED BY: Ivan J. Bammes

AGENT: Charles D. Anderson

ADDRESS: 1020 Union Nat'l. Building 67202 PHONE 782-2128

PURPOSE OF DEDICATION: Condition of approval of Case No. SCZ-0274

* & BEING FOR NELSON DRIVE, IN AN AREA NORTH OF DERRY, KS.

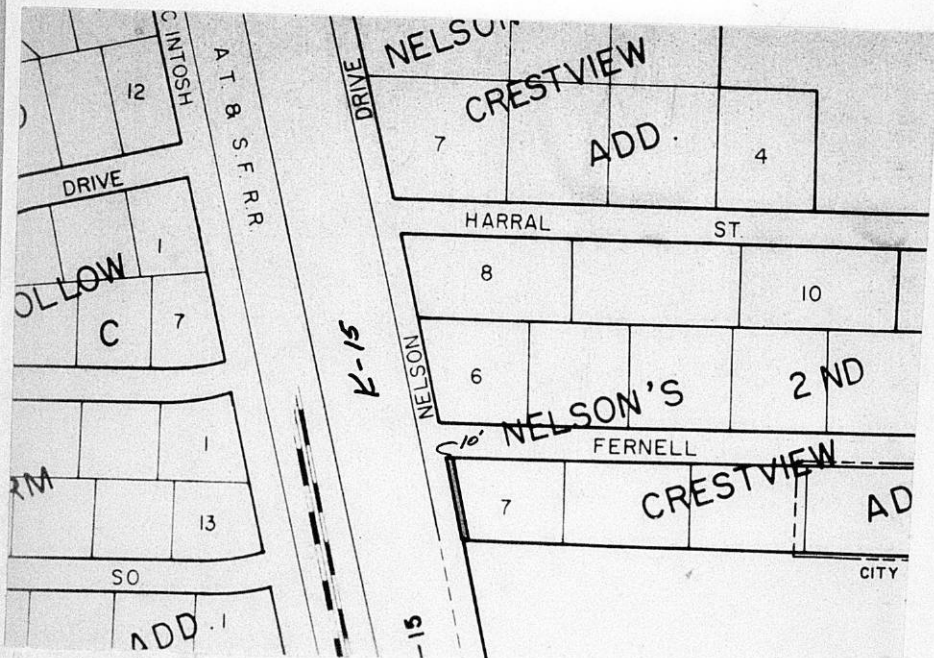

III. FILED 1-19-72

POSTED TO ATLAS 1-24-72
S/D COMM. ACTION no hearing necessary

M.A.P.C. ACTION no hearing necessary

B.C.C. ACTION E-1-72 accept

PLACED ON RECORD _____

CITY CLERKS No. _____

MAPC CASE NO. D-0491 Dedication of Portion of street right-of-way

Dedicated by: Ivan J. and Ruby Bammes

Generally Portion of Nelson Drive in an area north of Derby

This dedication is given for the following reason:

Conditiona of approval of Case No. SCZ-0274.

ACTION: Accept the dedication and instruct the City Clerk to file with the Register of Deeds.

T9-325

DEDICATION

KNOW ALL MEN BY THESE PRESENTS:

That for and in consideration of the sum of One Dollar (\$1.00) and other good and valuable considerations, the receipt of which is hereby acknowledged, the undersigned, Ivan J. Bammes and Ruby Bammes, husband and wife,

being the owners of the following described real estate in Sedgwick County, Kansas, to wit:

The west ten (10) feet of Lot 7, Nelson's 2nd Crestview Addition to Sedgwick County, Kansas.

do hereby dedicate the above described real estate to the public for _____ street _____ purposes.

Executed this 19th day of January 19 72.

Ivan J. Bammes
Ruby Bammes

STATE OF KANSAS)
SEDGWICK COUNTY)^{ss}

BE IT REMEMBERED, that on this 19th day of January, 1972,
came Ivan J. Bammes and Ruby Bammes, husband and wife,

to me personally known to be the same persons who executed the foregoing instrument and duly acknowledged the execution of the same.

IN WITNESS WHEREOF, I have hereunto subscribed my name and affixed my official seal, the day and year last above written.

Submitted to the Wichita-Sedgwick County Metropolitan Area Planning Commission and the Board of Commissioners of the City of Wichita, Kansas, and approved by said Board of Commissioners of the City of Wichita, Kansas,

this _____, _____

City Clerk

Shelby S. Diamond
Notary Public

My Commission Expires:

July 31, 1973

